


WAKEMAN LAGRANGE RICHFIELD RD.  
S.R. 303

WHITEHEAD RD.

HOLLIS C. & LUCILLE EKLEBERRY  
10-8-48 D.V. 450 - PG. 526

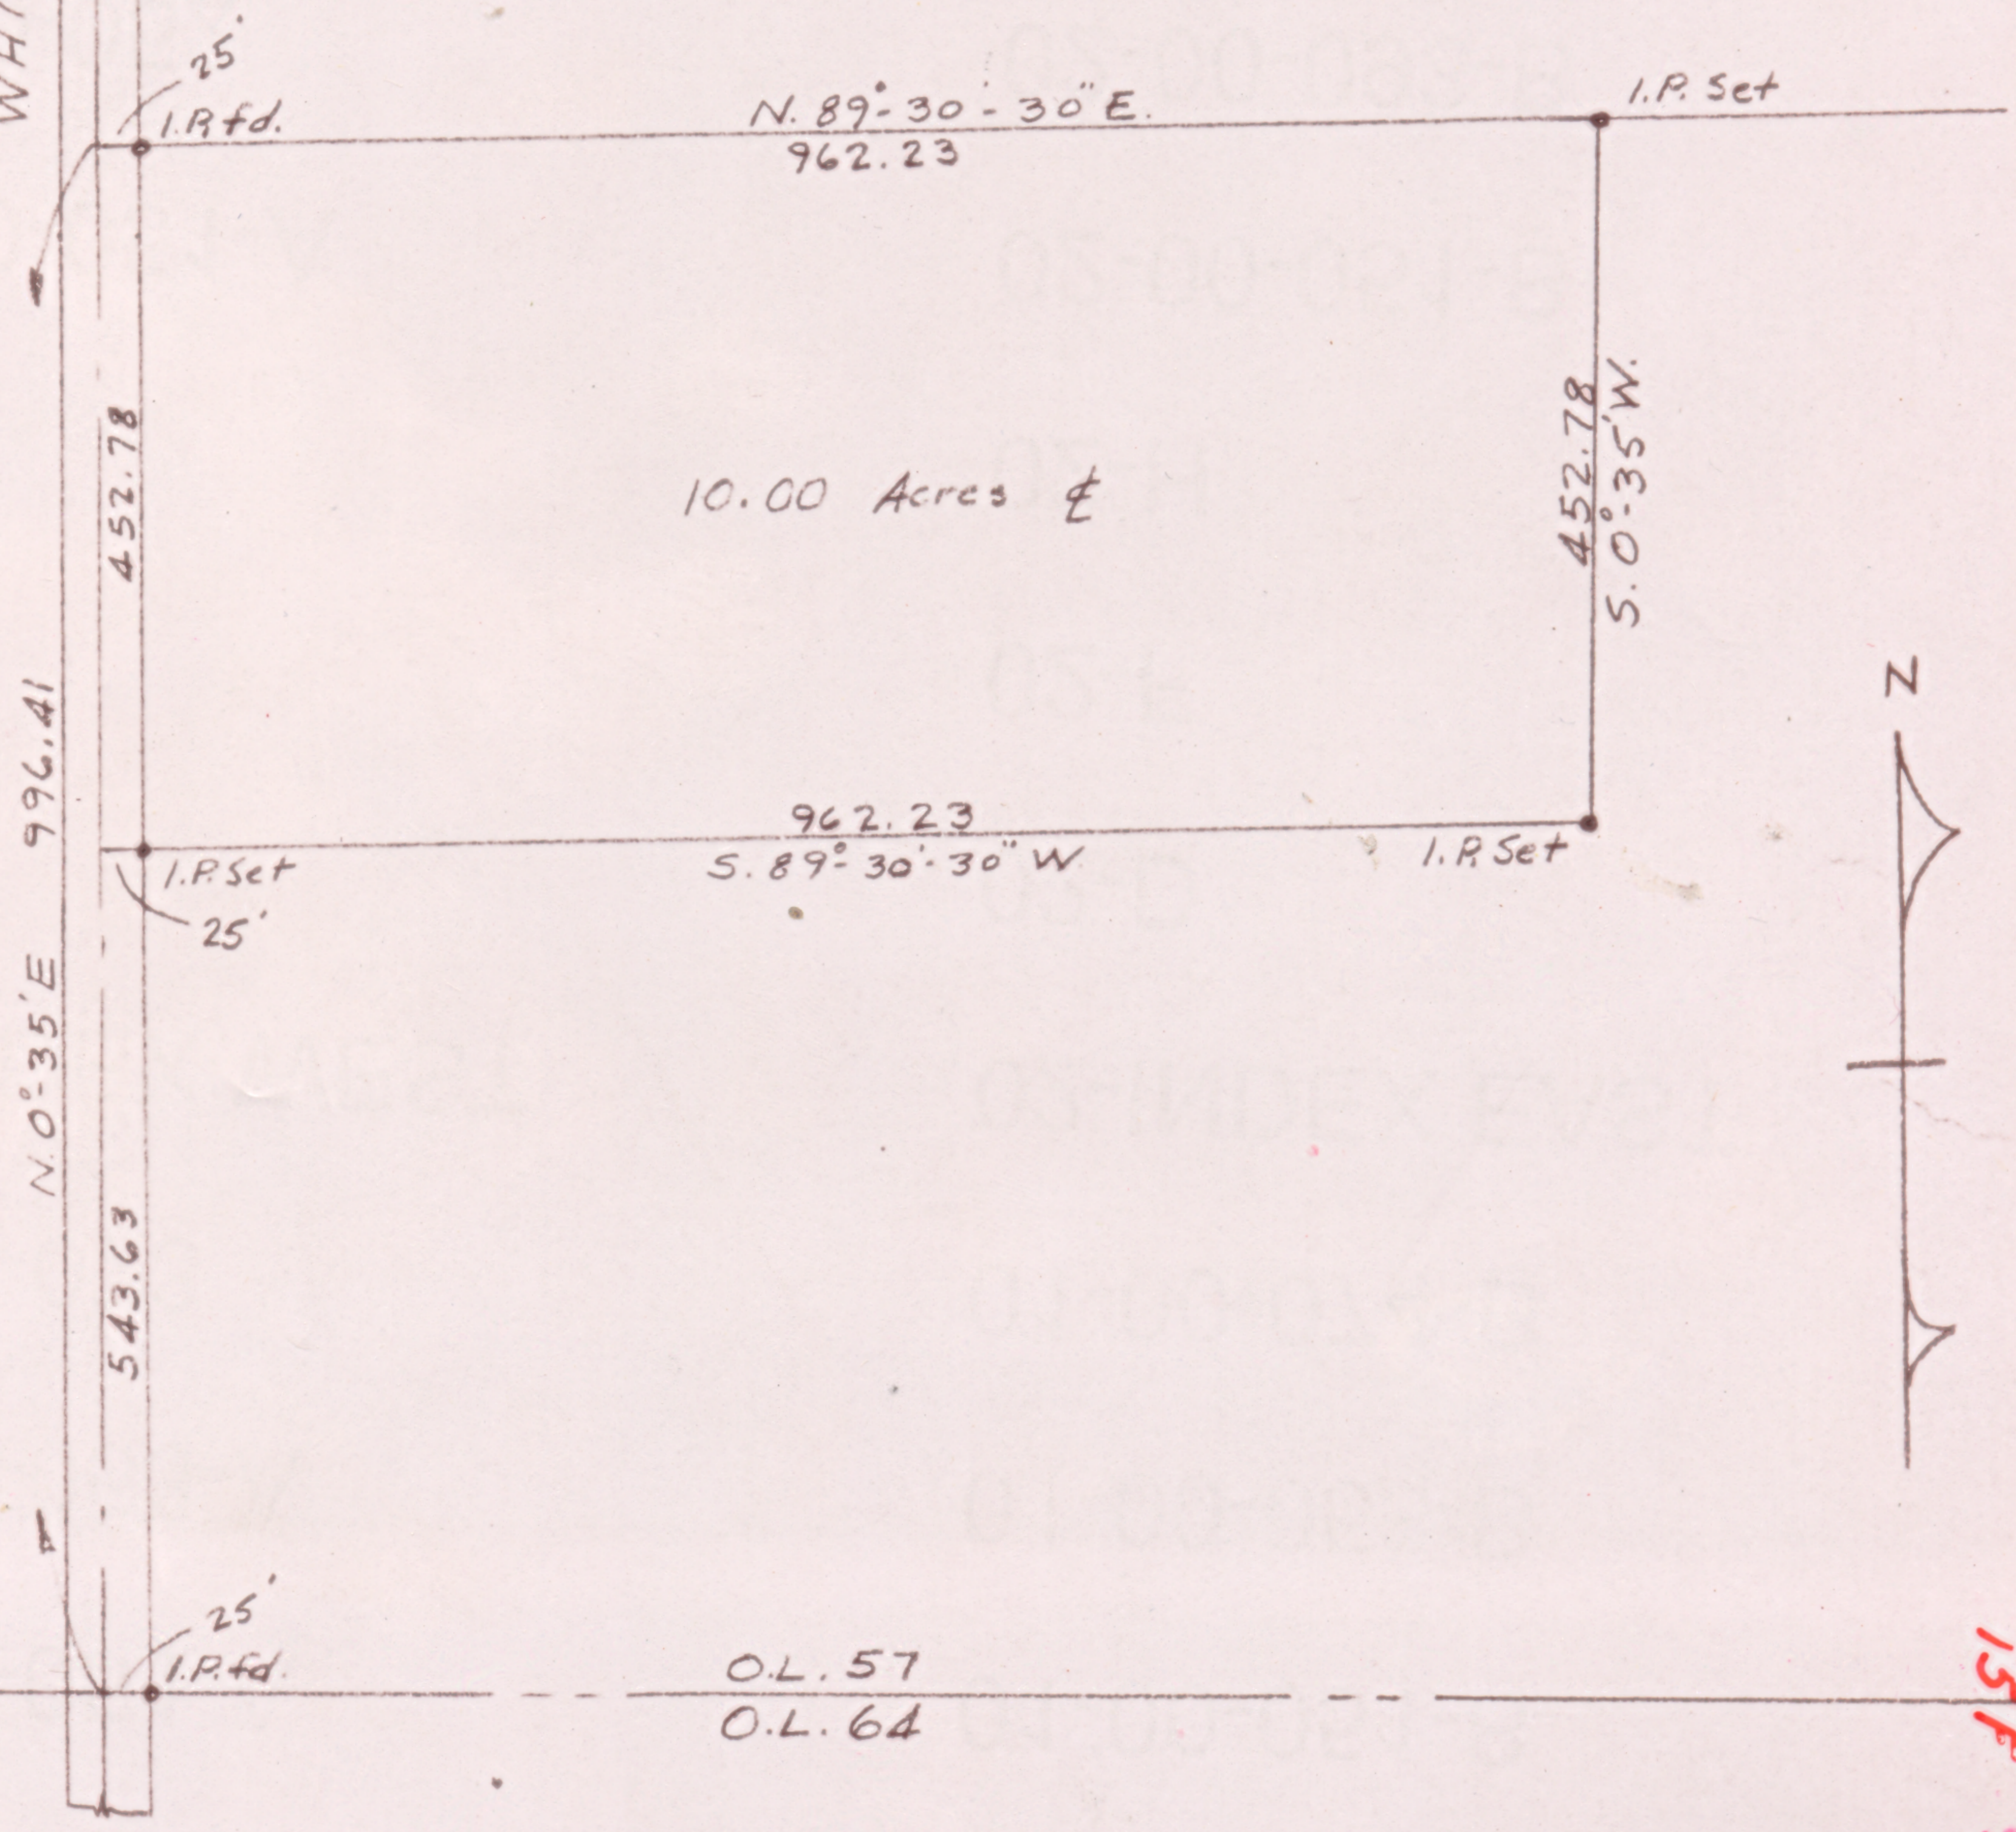

10.00 Acres ±



O.L. 58  
O.L. 63

O.L. 57  
O.L. 64

SURVEY FOR PETER & YOLANDA MAROZSAN  
PART OF O.L. 57 LAGRANGE TWP, LOR. CO., O.  
SCALE 1"=200' JANUARY 1960  
LAUNDON & HUFFMAN - REG. SURVEYORS

15-00-057-000-003  
15 F  
46852