


15-00-098-106-050
15-00-098-106-051
15-00-098-A
SCAN # 46857

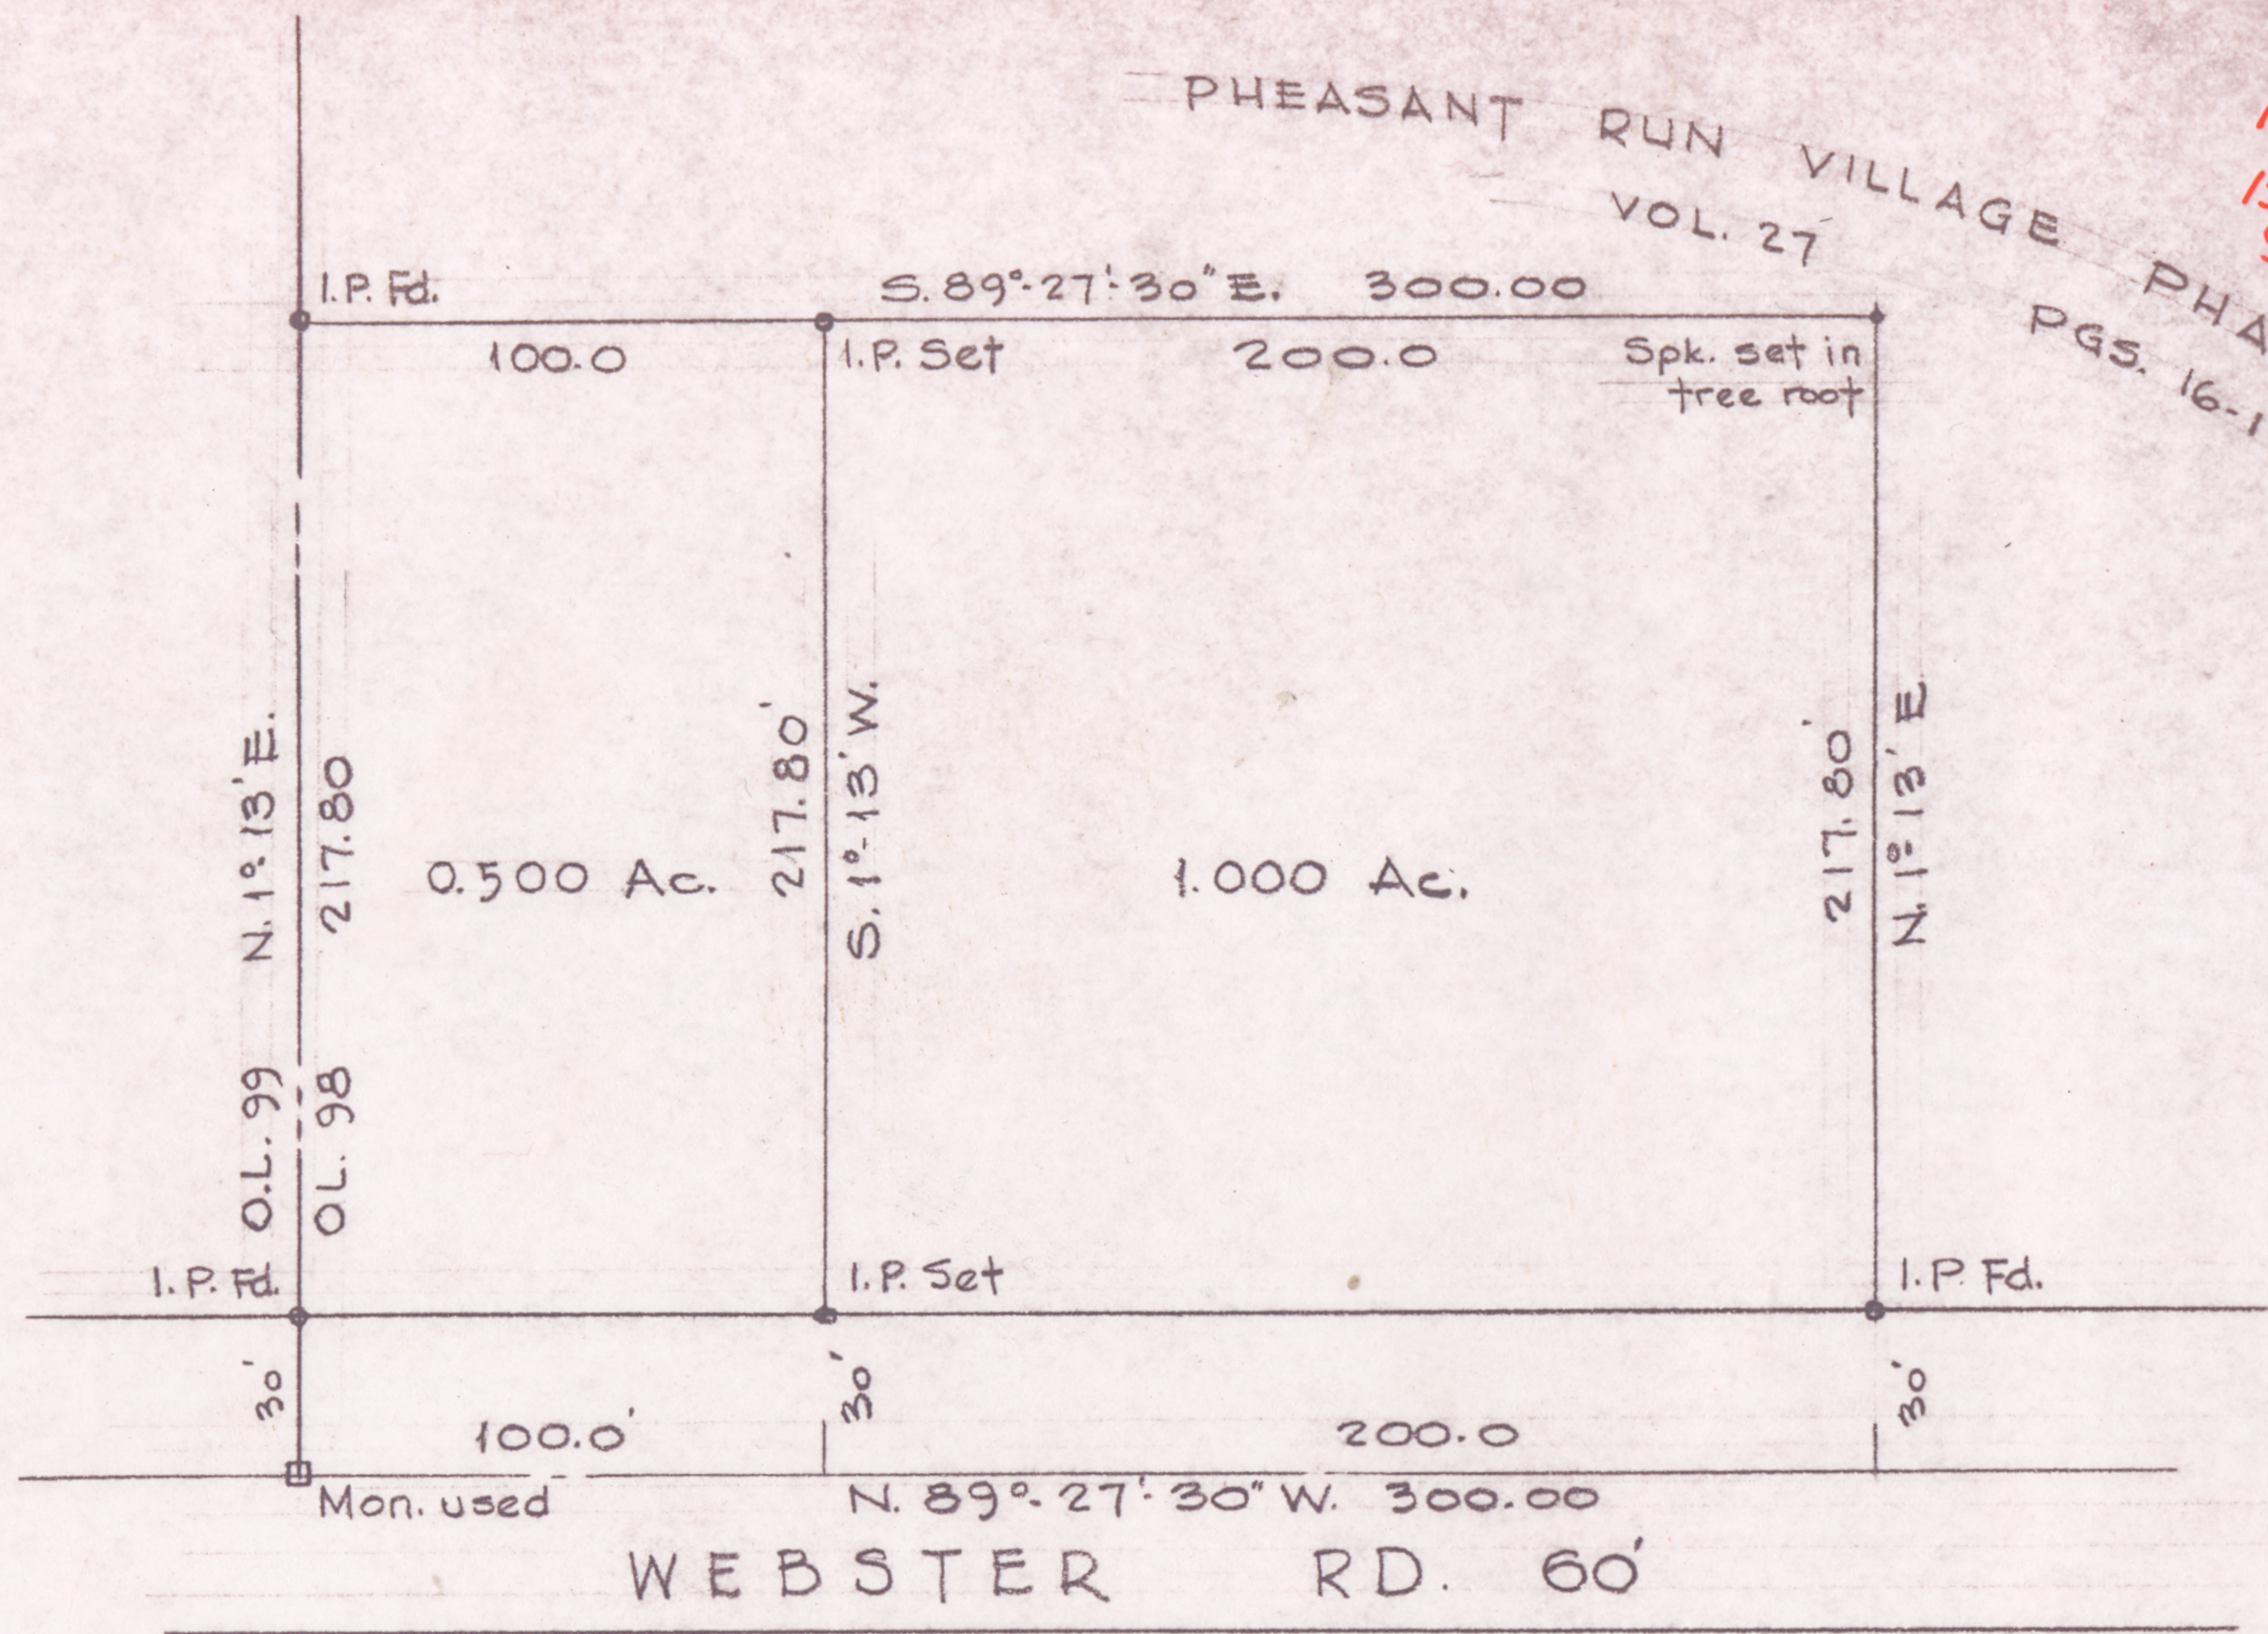

SURVEY FOR CATHERINE FILO
O.L. 98 LAGRANGE TWP.
LORAIN COUNTY OHIO
SCALE 1"=60' FEB., 1974
LAUNDON·SIMON·CAHL & ASSOC.
ENGINEERS·SURVEYORS

Job 74-217