


16-00-001-112-015

SCAN: 16-00-001-D
SCAN #: 46860

MECHANIC ST.

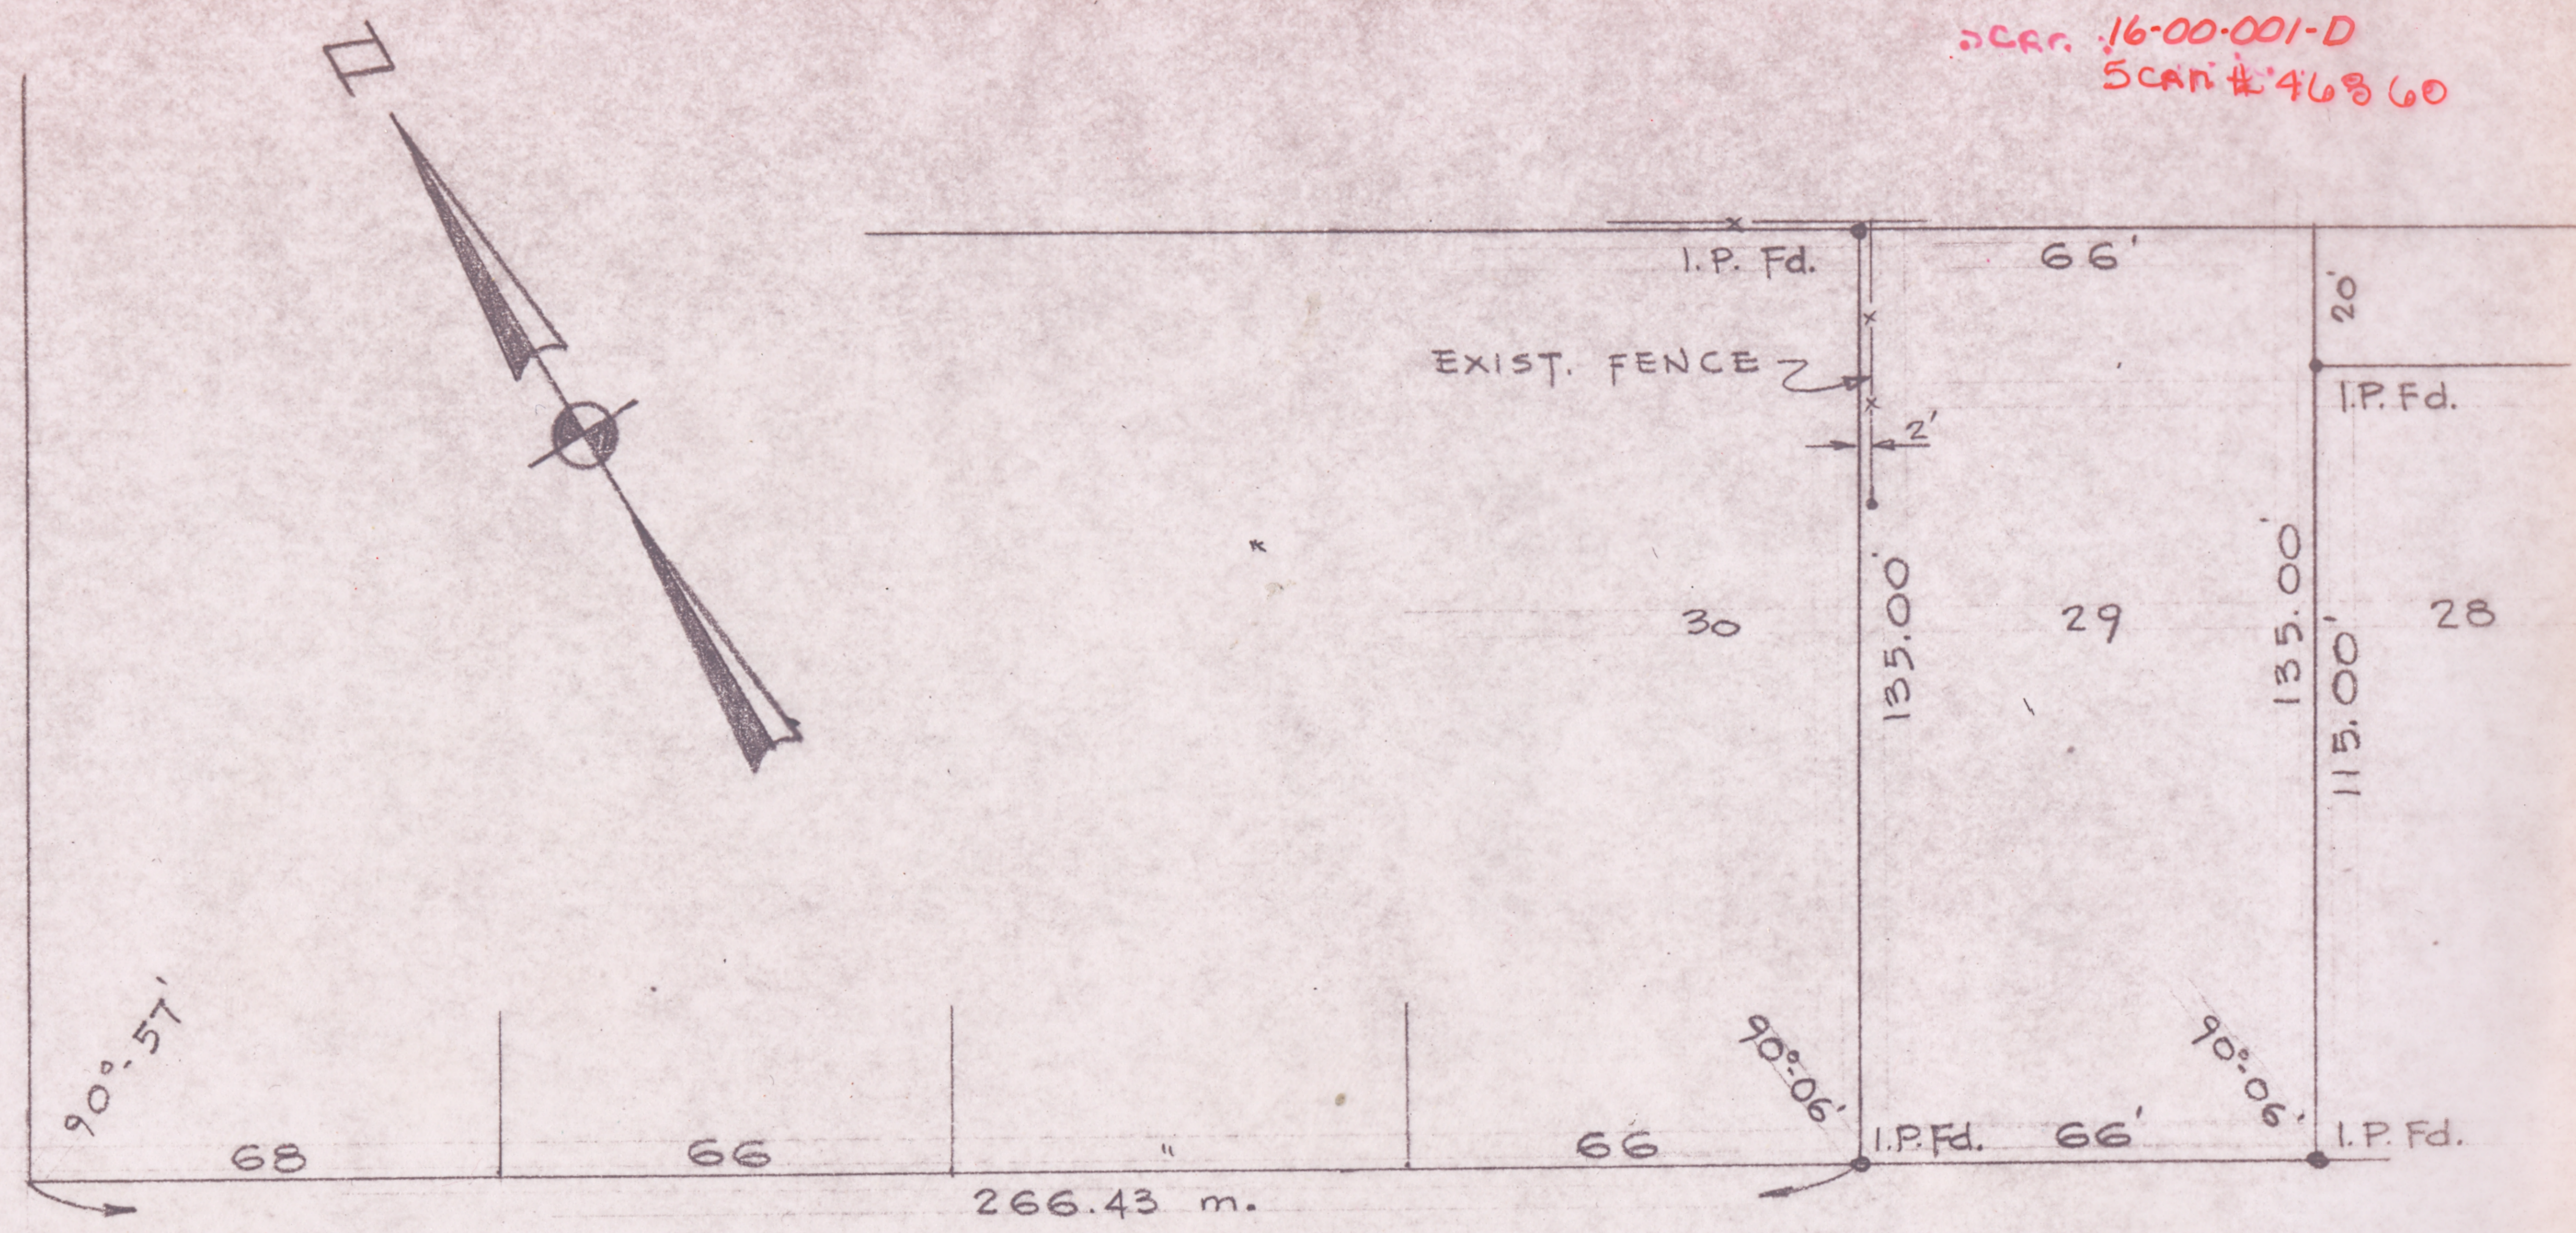

90°:57'

68

66

266.43 m.

66

90°:06'

I.P. Fd.

66'

90°:06'

I.P. Fd.

CHESTNUT ST.

ST.

60'

SURVEY FOR RICHARD PARDEE

S/L 29 RAWSONVILLE SUBN. P.V. 1 PGS. 3-23-24
VILLAGE OF GRAFTON LORAIN COUNTY OHIO
SCALE 1"=40' MAY, 1974
LAUNDON • SIMON • CAHL & ASSOC.
ENGINEERS & SURVEYORS