


16-00-019-103-010

16-00-019-D

SCAN # 46861

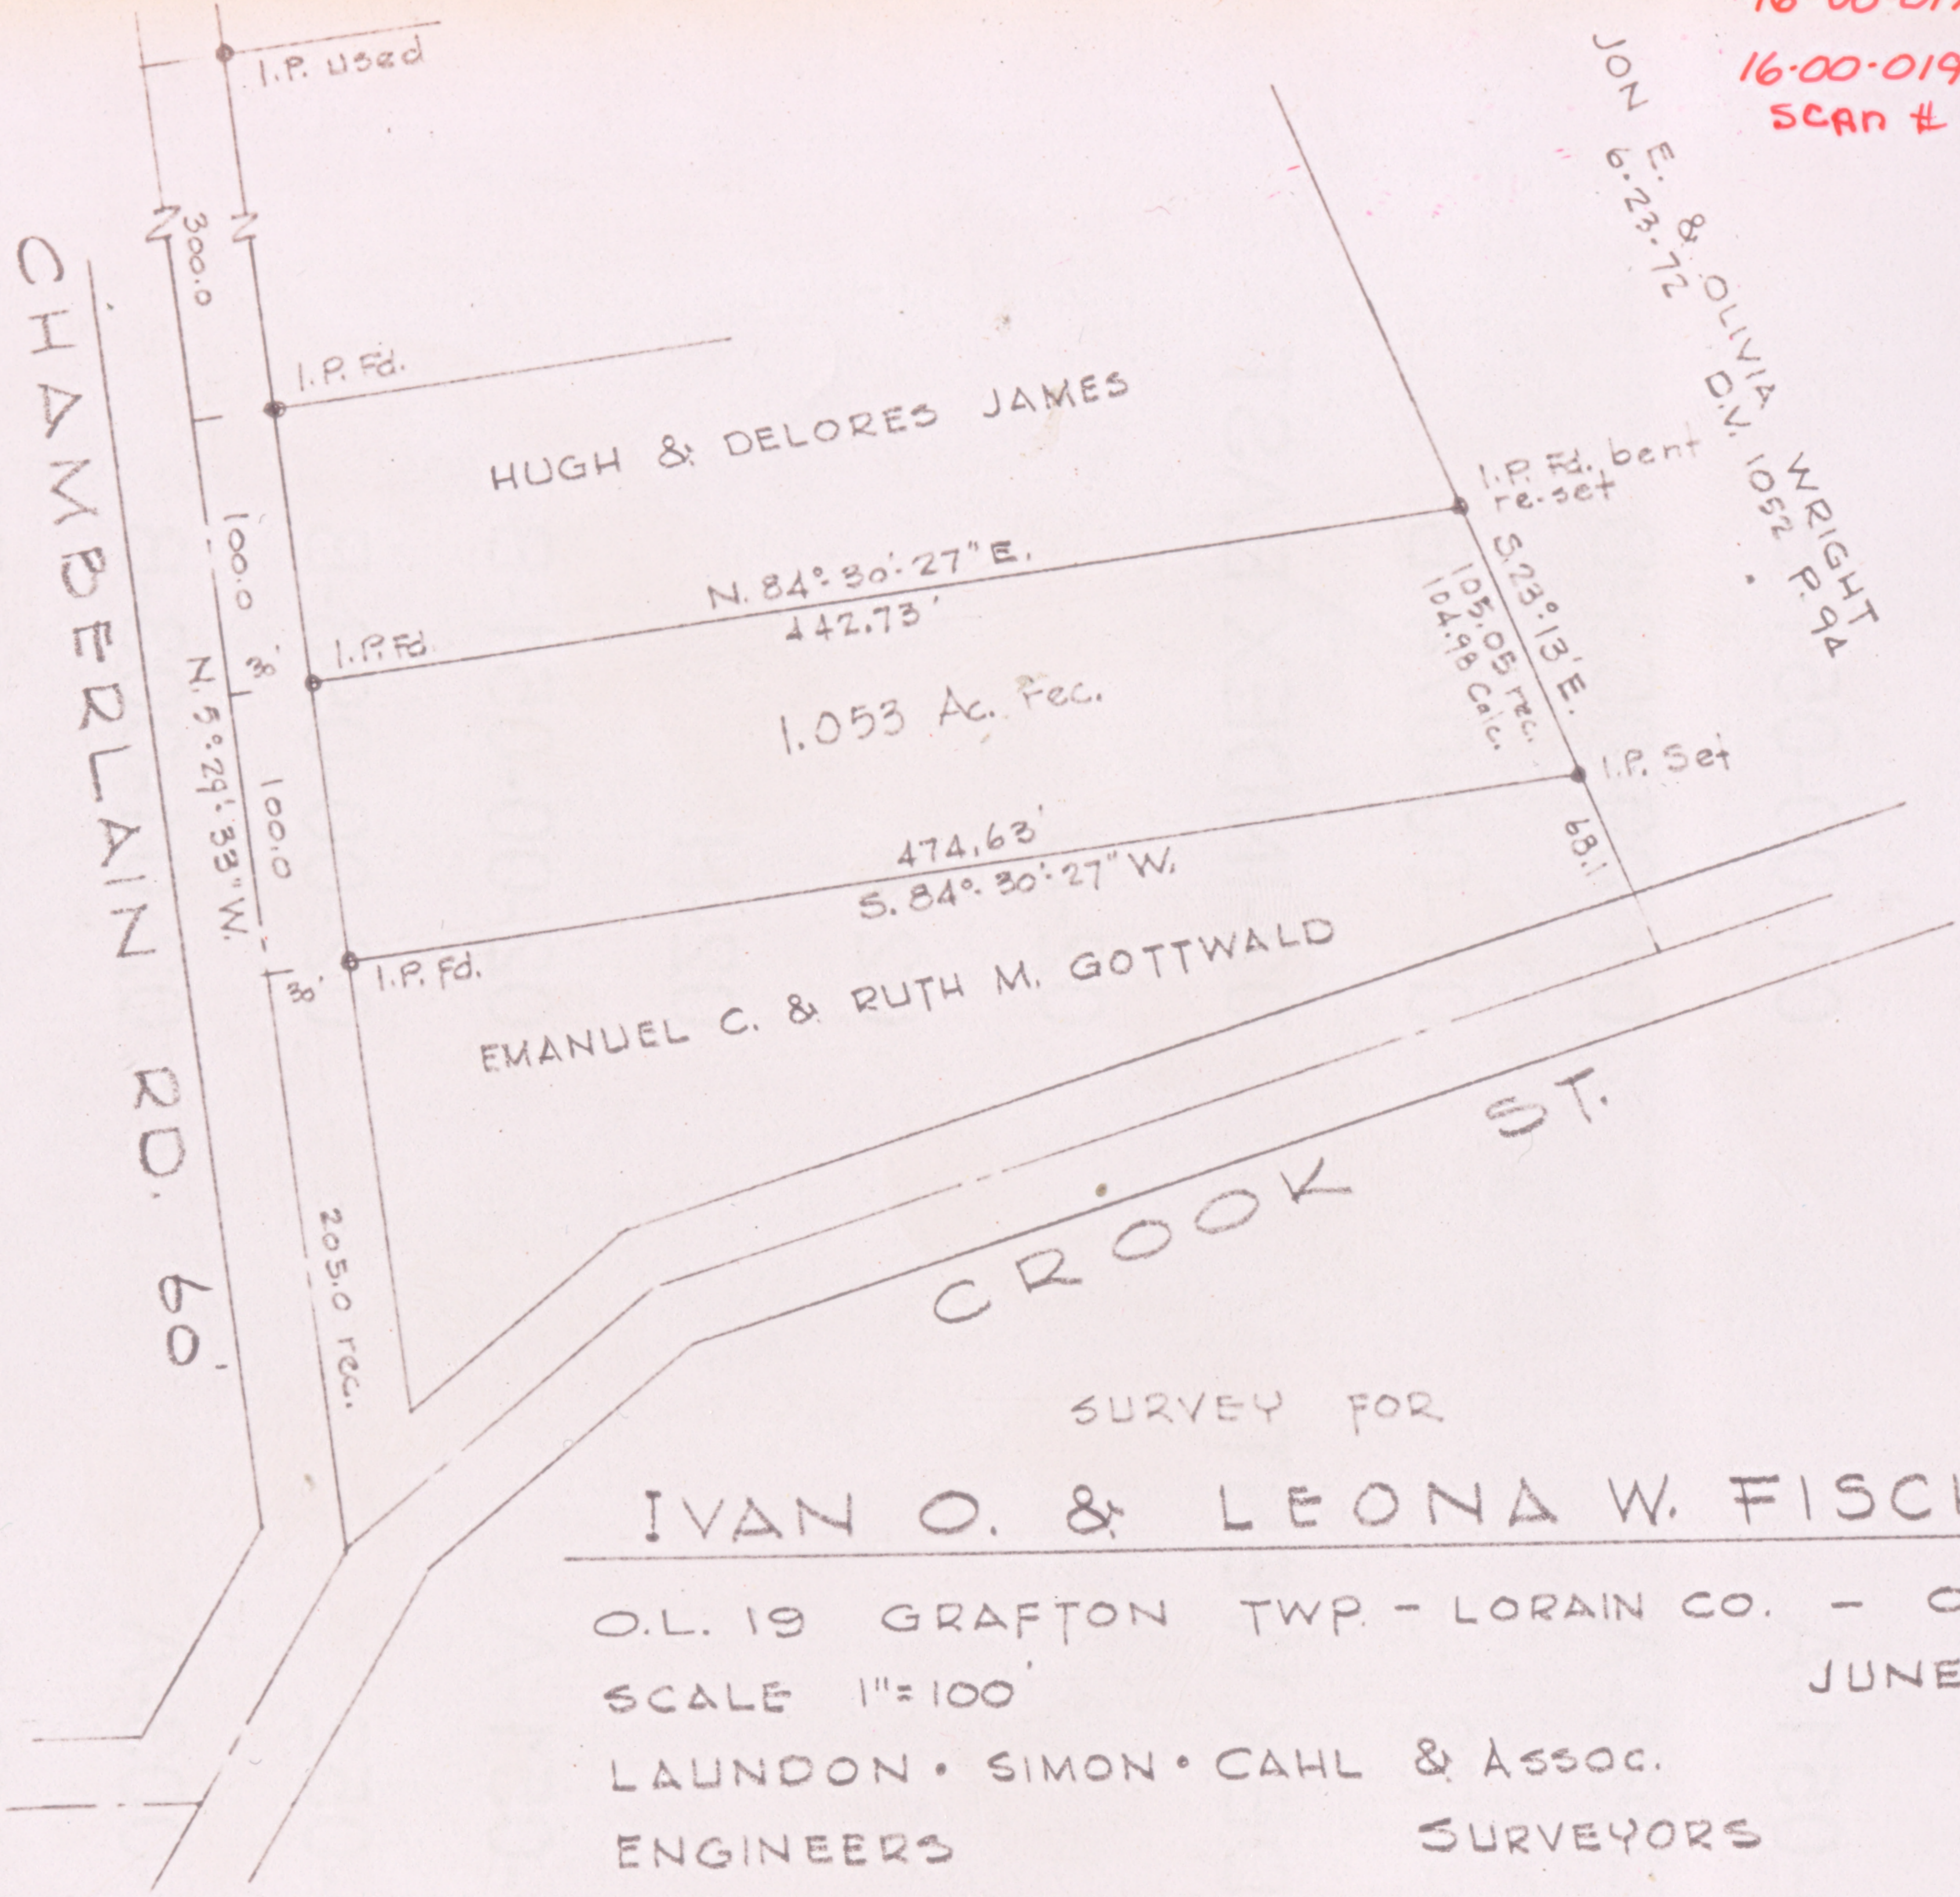

SURVEY FOR

IVAN O. & LEONA W. FISCHER

O.L. 19 GRAFTON TWP. - LORAIN CO. - OHIO

SCALE 1"=100'

JUNE, 1978

LAUNDON • SIMON • CAHL & Assoc.

ENGINEERS

SURVEYORS

Job 78-749