



LAUNDON • SIMON • CAHL and ASSOC.  
ENGINEERS  
504 MIDDLE AVE.

SURVEYORS  
ELYRIA, OHIO 4035

FOR: ROBERT & LYNNE E. JARVIS


TOWNSHIP GRAFTON  
ORIG. LOT or SEC. 73  
CITY

VILLAGE  
COUNTY LORAIN  
STATE OHIO

DATE FEB. 16, 1982  
SCALE 1" = 100'  
JOB NO. 82-1104 F.B. 140/43

16-H  
16-00-073-000-022

Scan # 46871

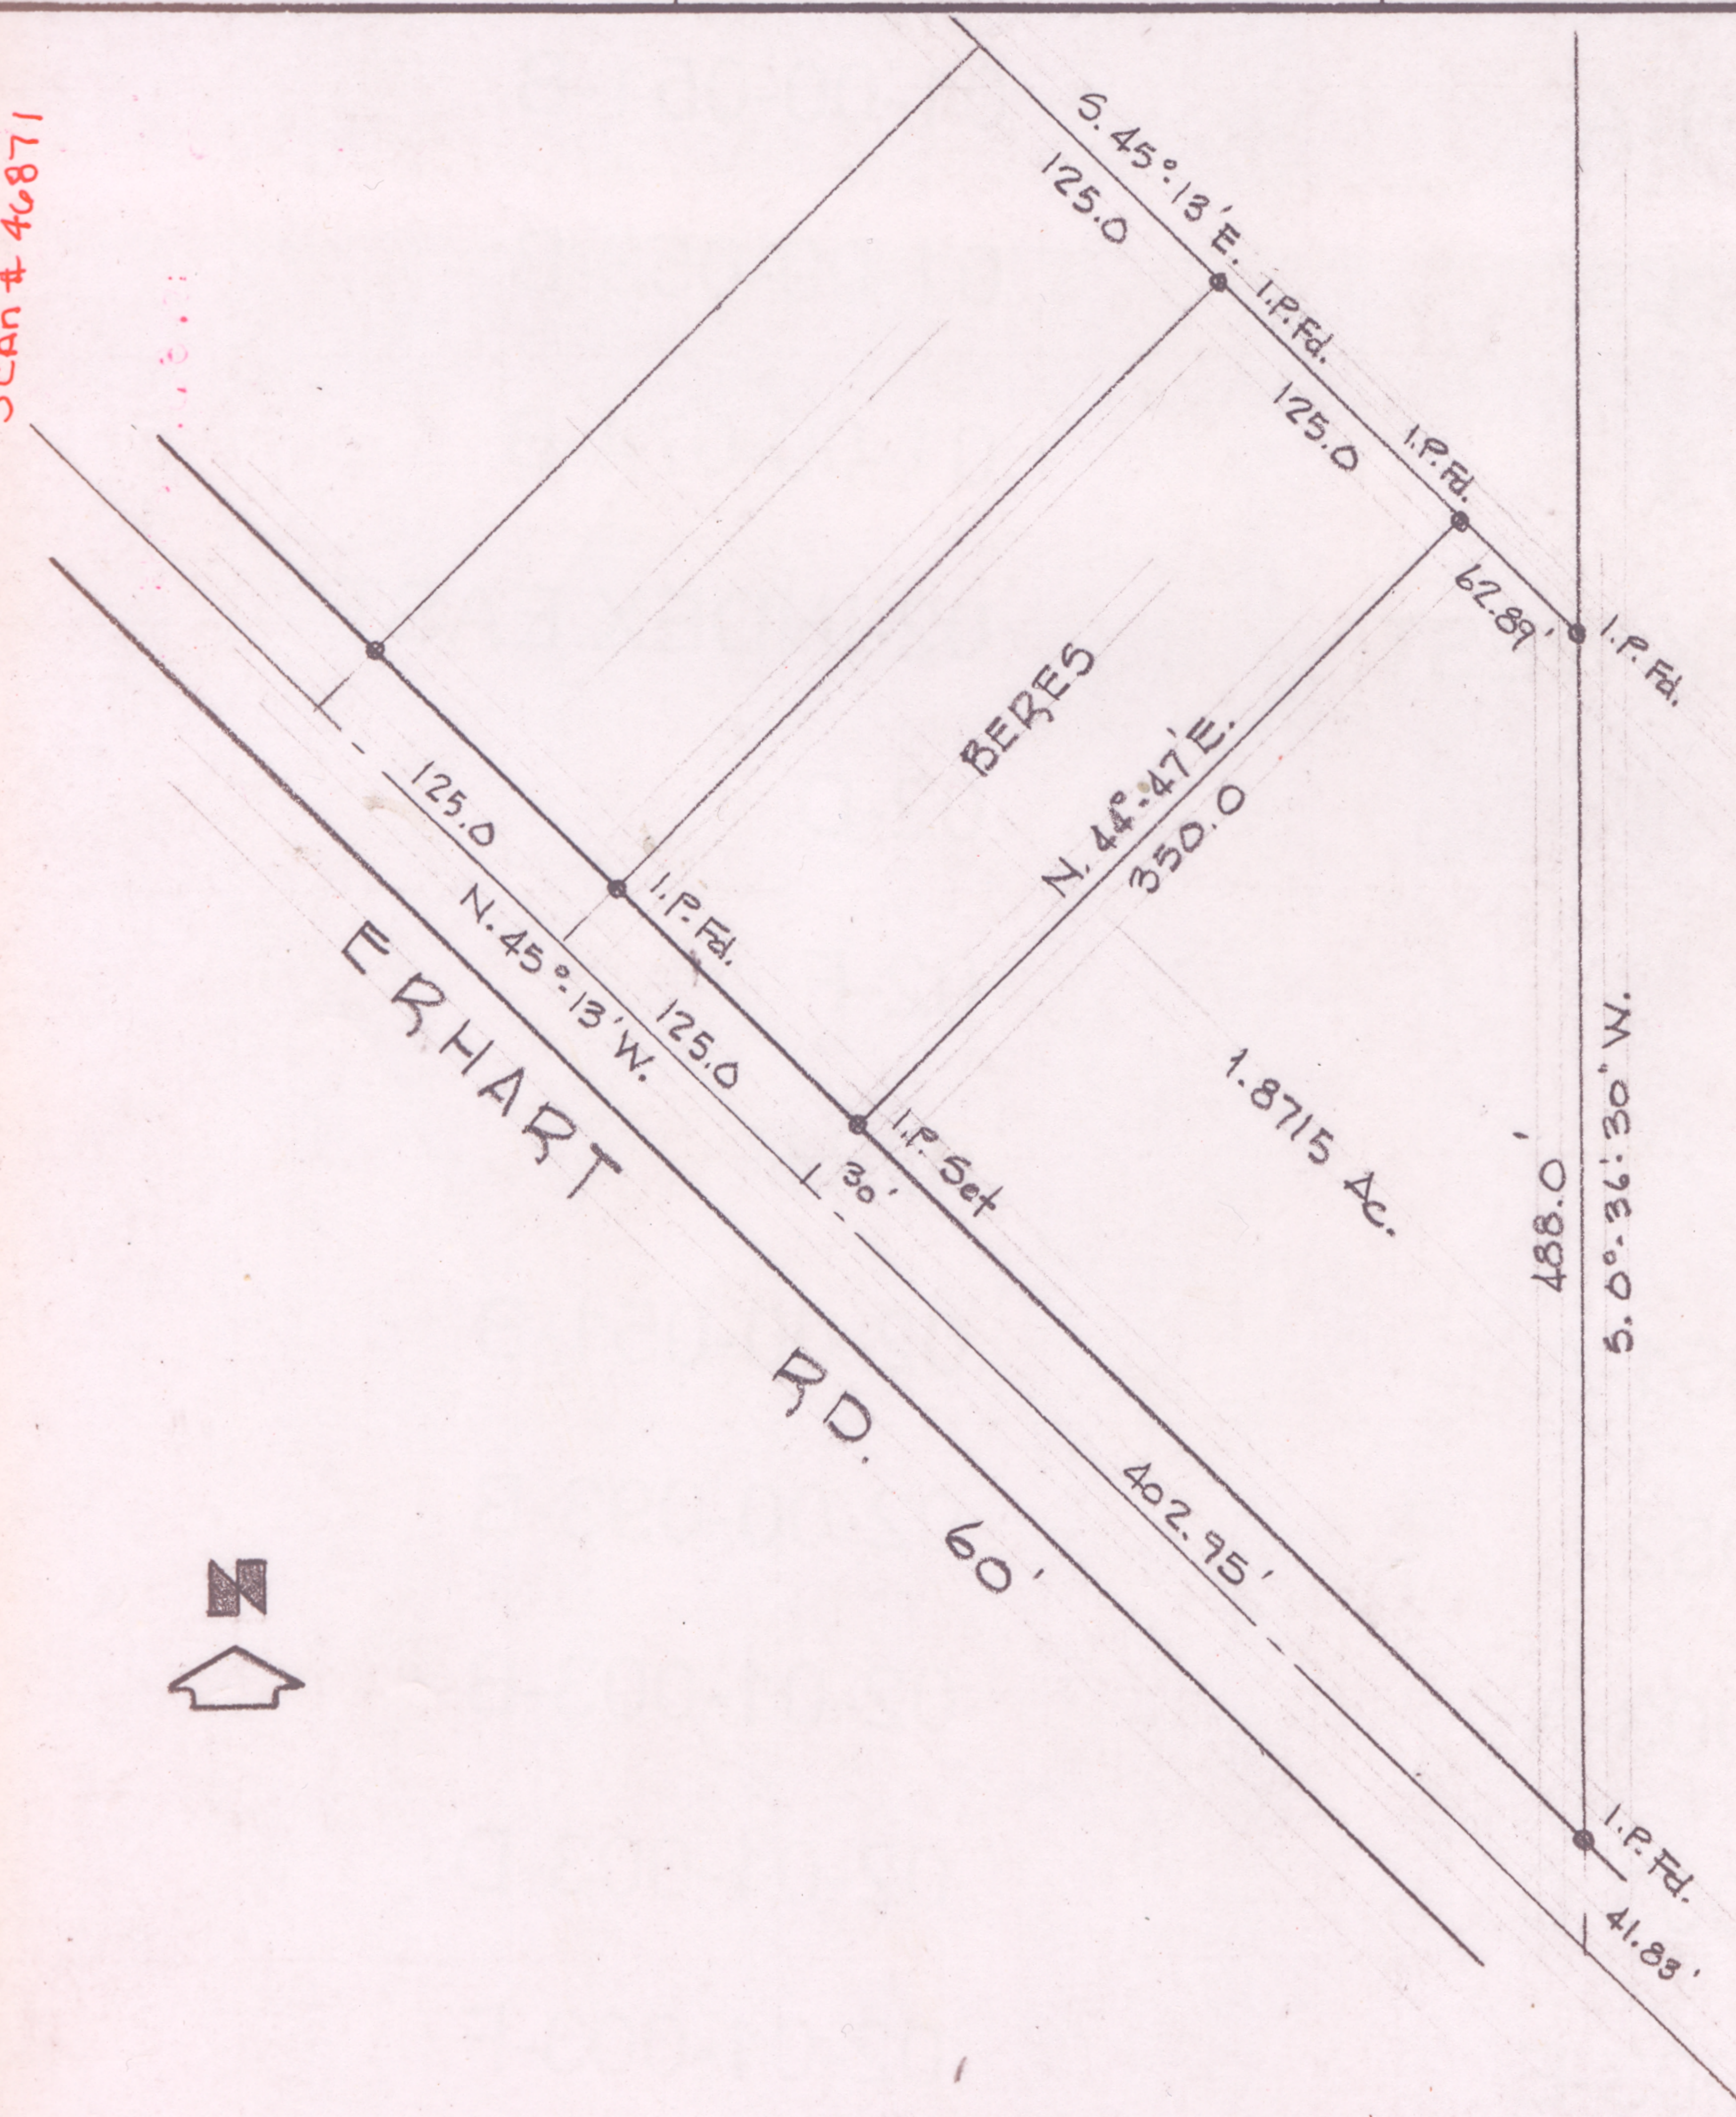

ANDY J. DEMYAN

