


ALBERT & MARY BAIRD
7-16-34 D.V. 271-241

Property line by agreement

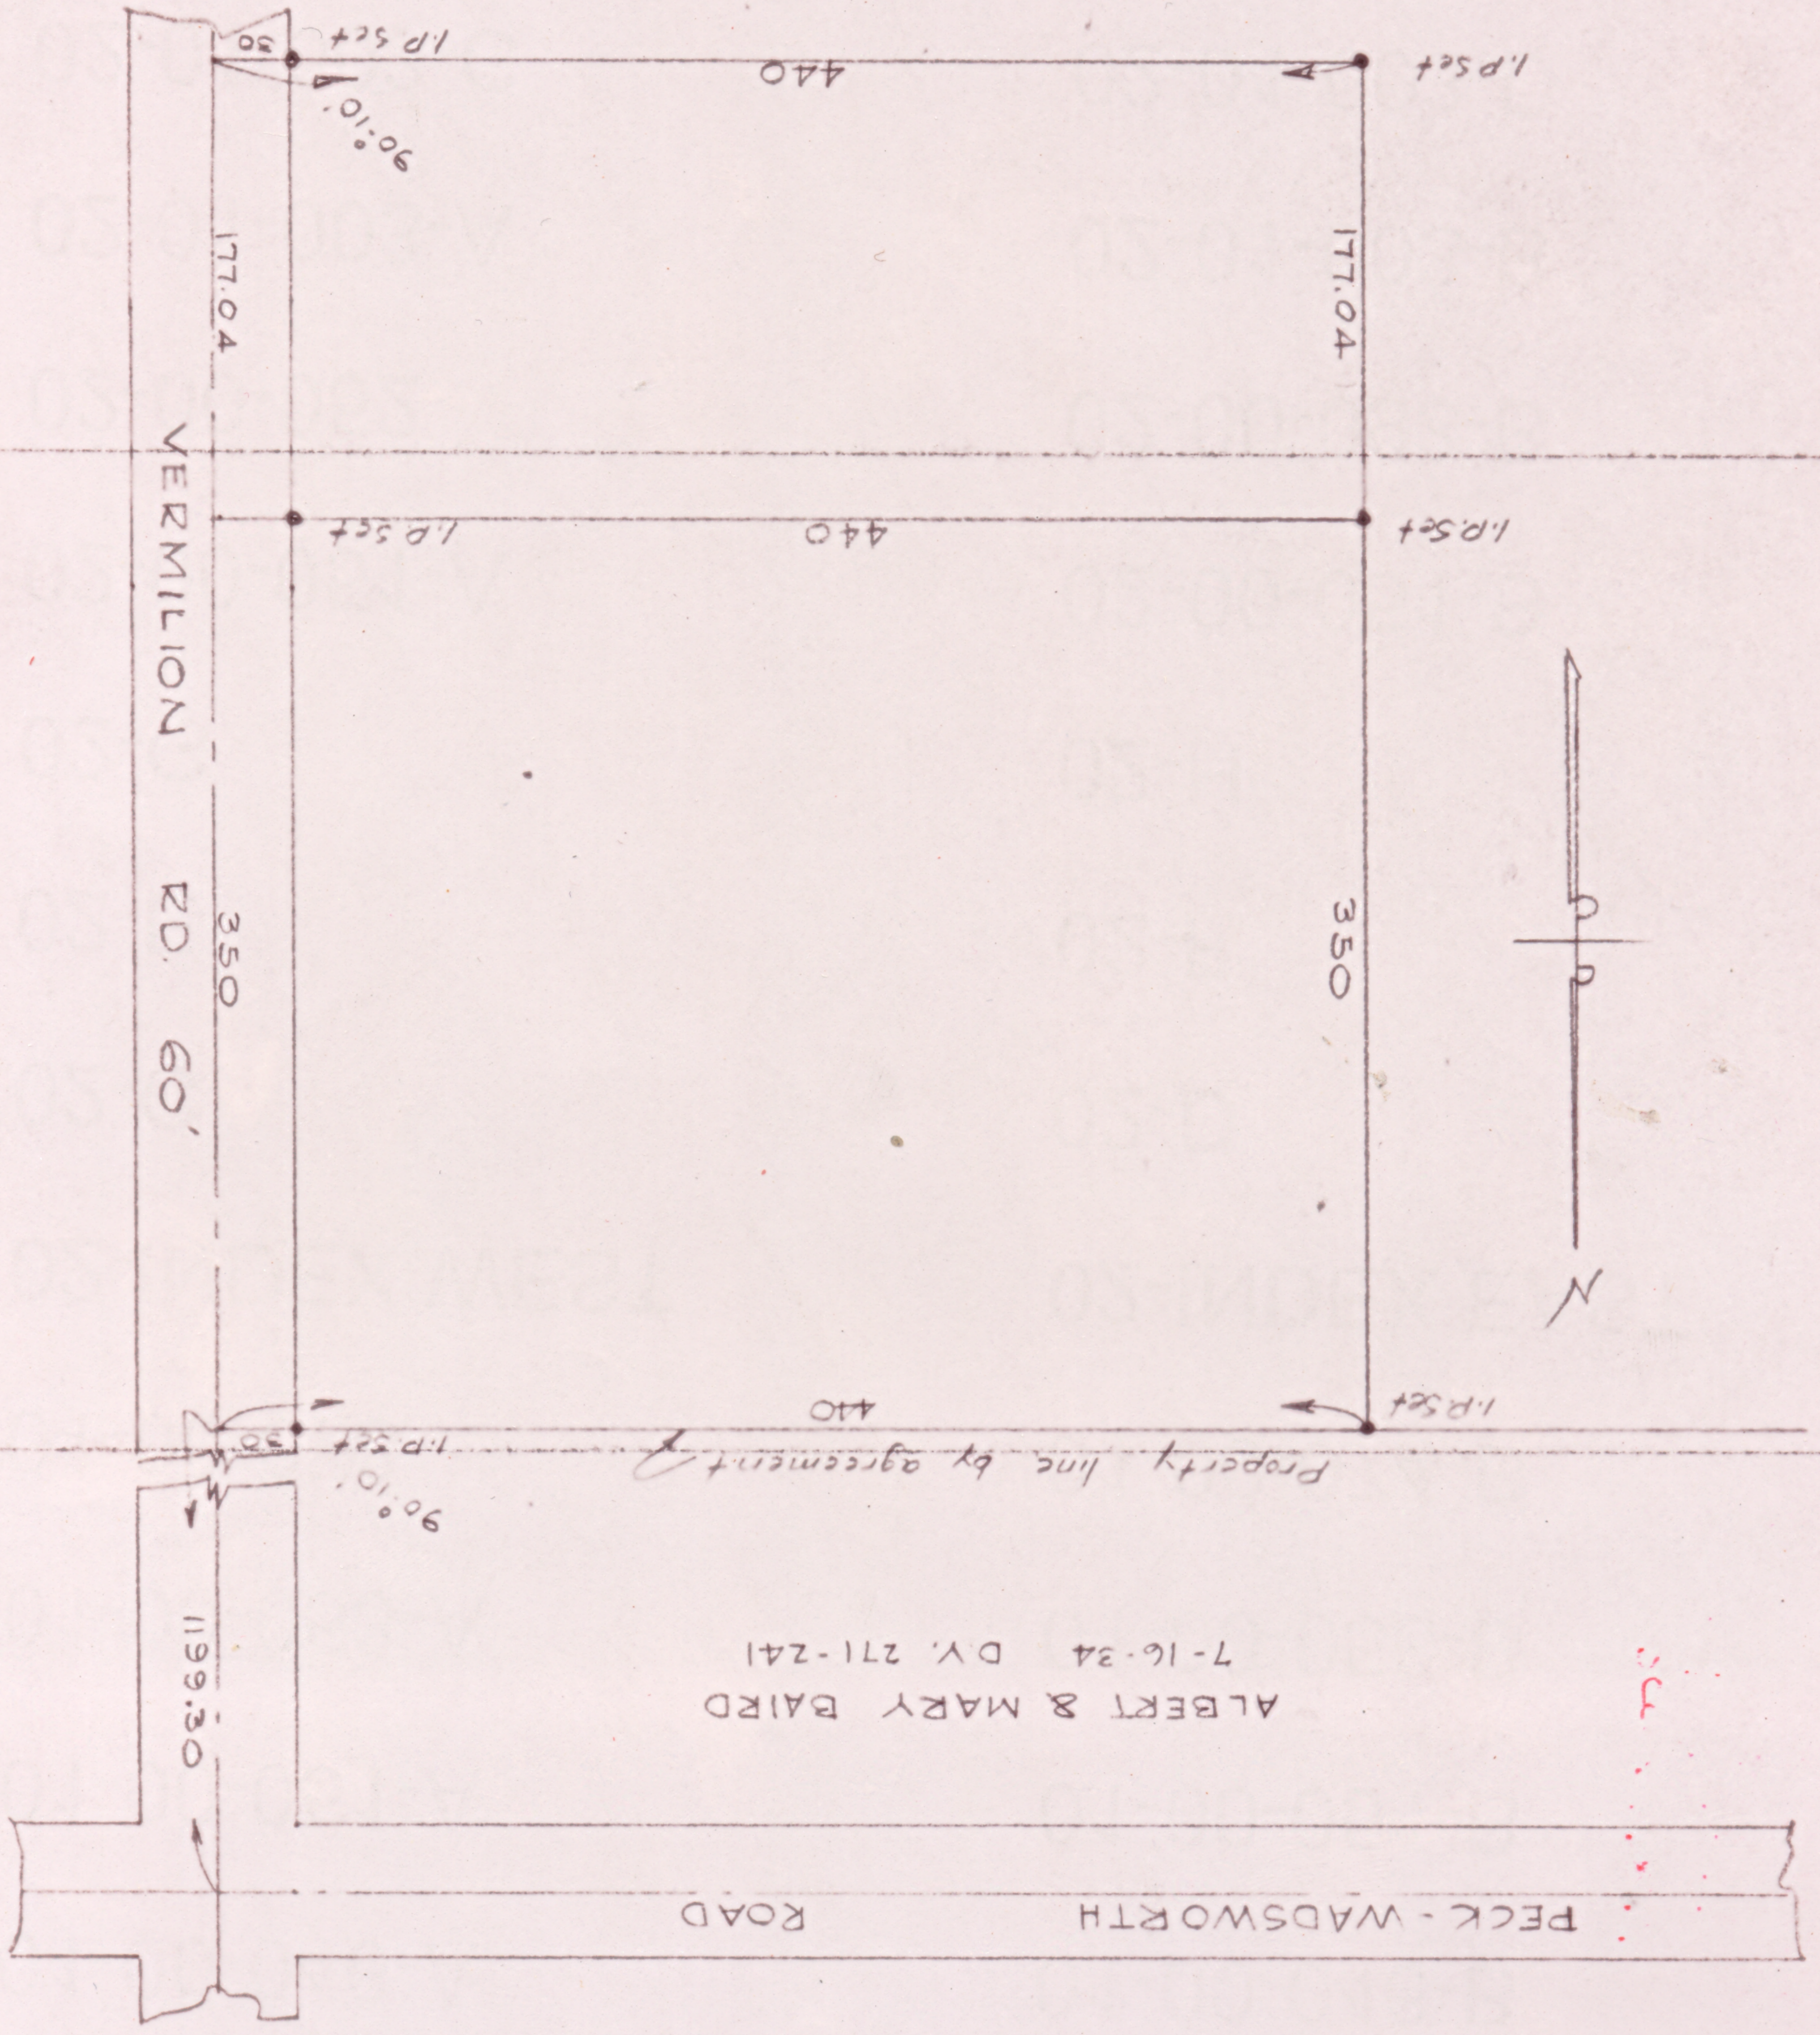

We the undersigned do here by agree upon property line established July 11, 1959

Albert R. Baird
Mary K. Baird

Herbert Peet
Herbert Peet

William R. Baird
William R. Baird

SURVEY FOR HERBERT PEET
TRACT 7 LOT 4 BRIGHTON TWP.
LORAIN COUNTY - OHIO
SCALE 1"=100' JULY, 1959
LAUNDON & HUFFMAN
REG. SURVEYORS
H. 96 R. 6