


18-00-021-101-044
18-00-021-101-045
18-00-021-A
SCAN # 46885

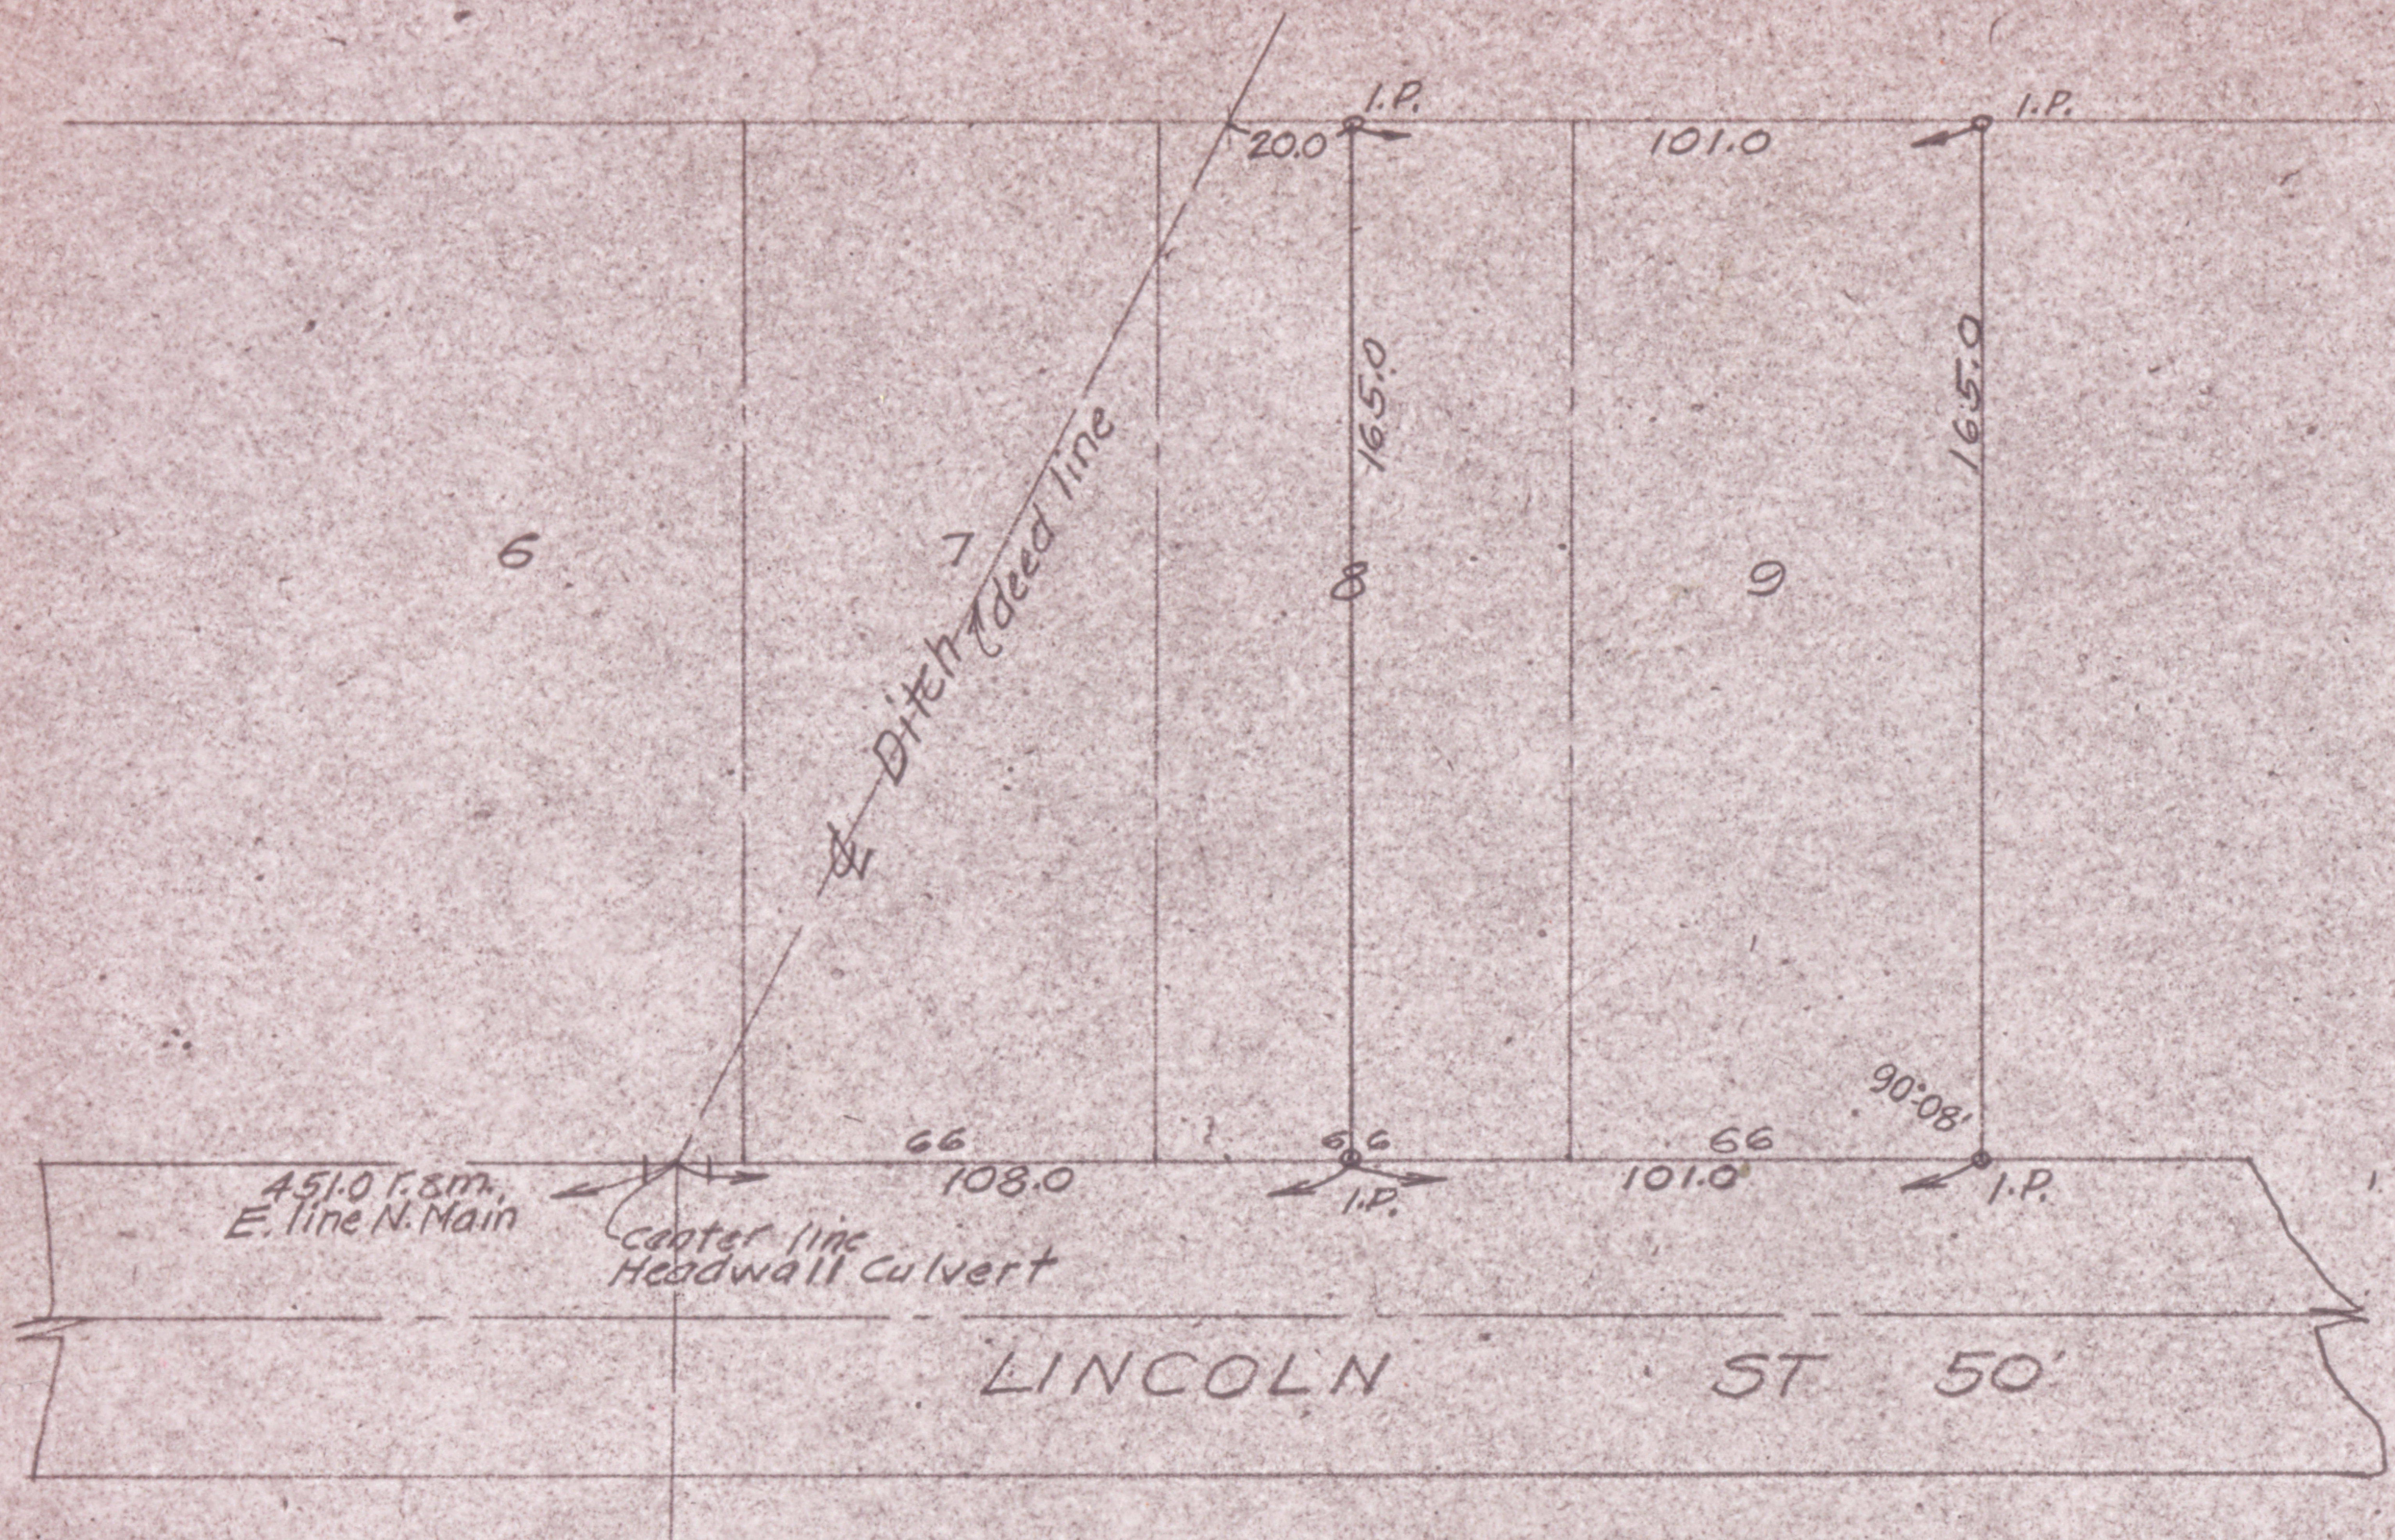

SURVEY FOR JAMES & JANICE, QUERIN
LOTS 6-7-8-9 ADAMS ADDN. P.V. 1-40
WELLINGTON VILLAGE, LORAIN CO. OHIO
SCALE 1" = 50' 5-22-52
T.W. LAUNDON REG. SURVEYOR,