

18-00-021-103  
18-00-021-C  
Scan #44890


GLENN &  
HATTIE  
PERRY  
6-26-57  
698-3

HOWARD &  
KATH.  
NORRIS

11-13-45  
371-3A1

HAMILTON  
ST. 66'

NORRIS

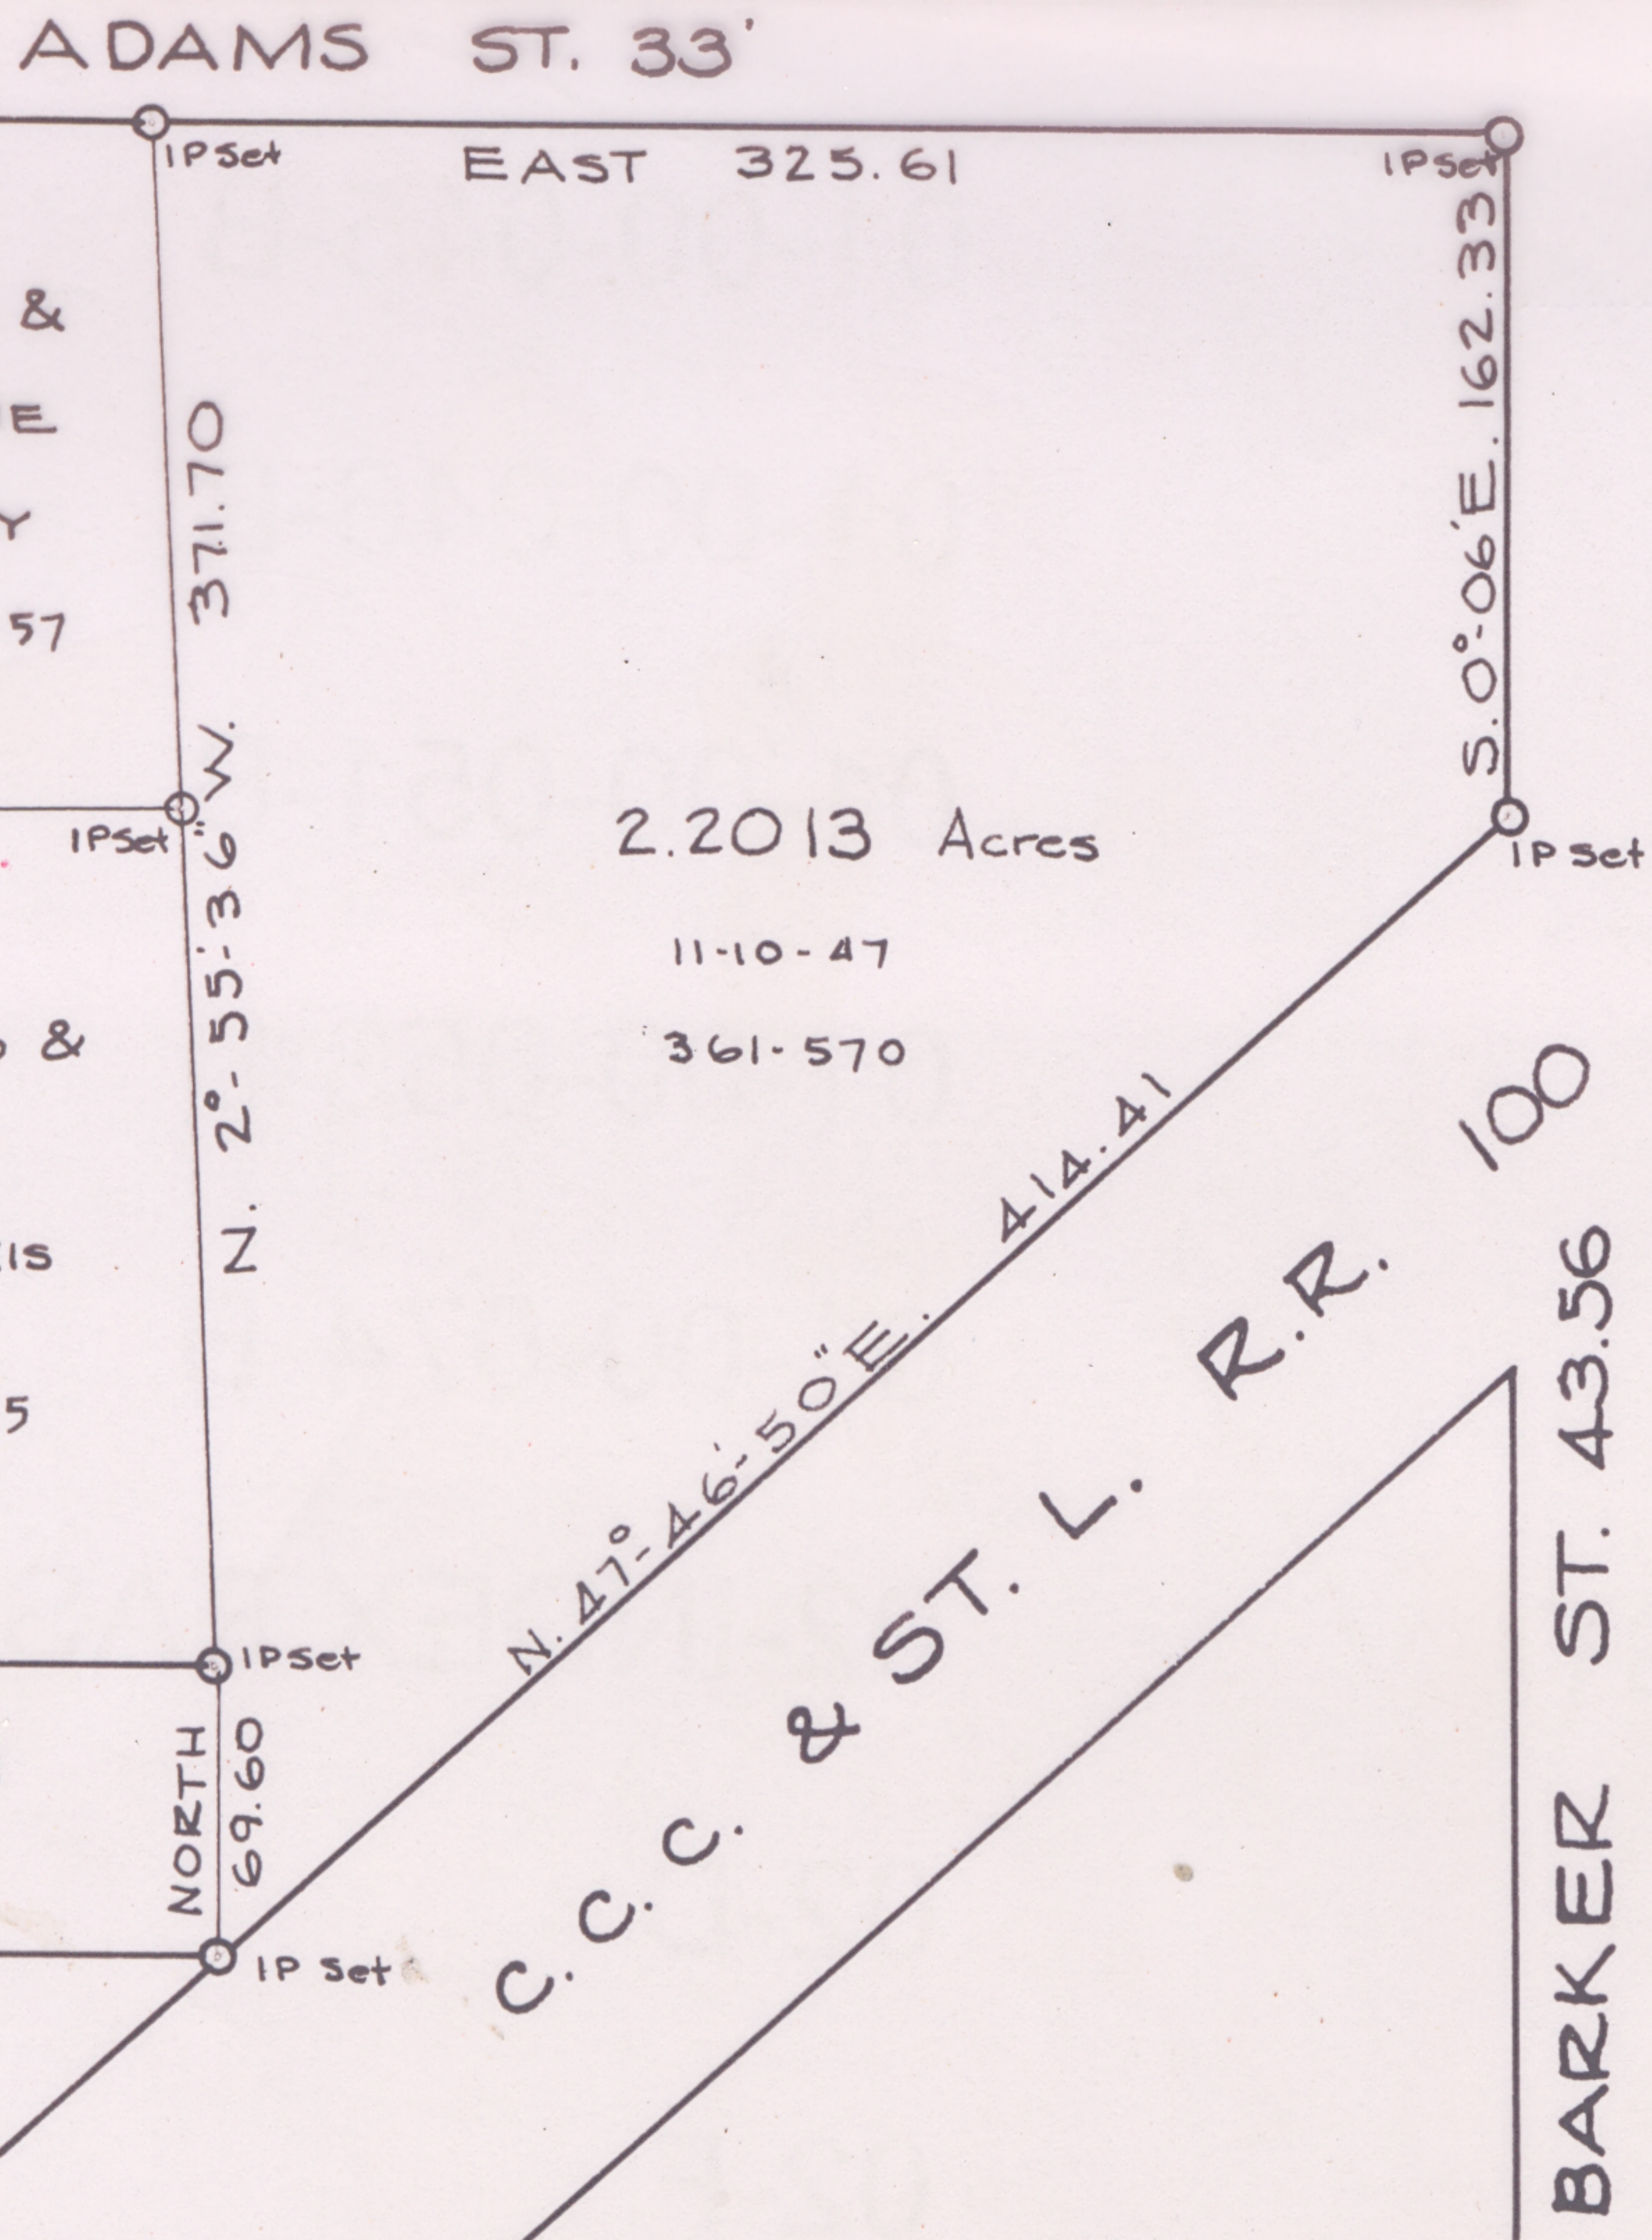

2.2013 Acres  
11-10-47  
361-570

SURVEY FOR

HARRY & MARGARET LEONARDI

O.L. 21 VILLAGE OF WELLINGTON

LORAIN COUNTY

OHIO

SCALE 1"=100'

AUGUST 30, 1957

T.W. LAUNDON

REG. SURVEYOR

