


18-00-021-110-045
 18-00-021-110-046
 18-00-021-110-047
 18-00-021-110-048
 18-00-021-C

Mary E Knapp

Property Line as per occupation

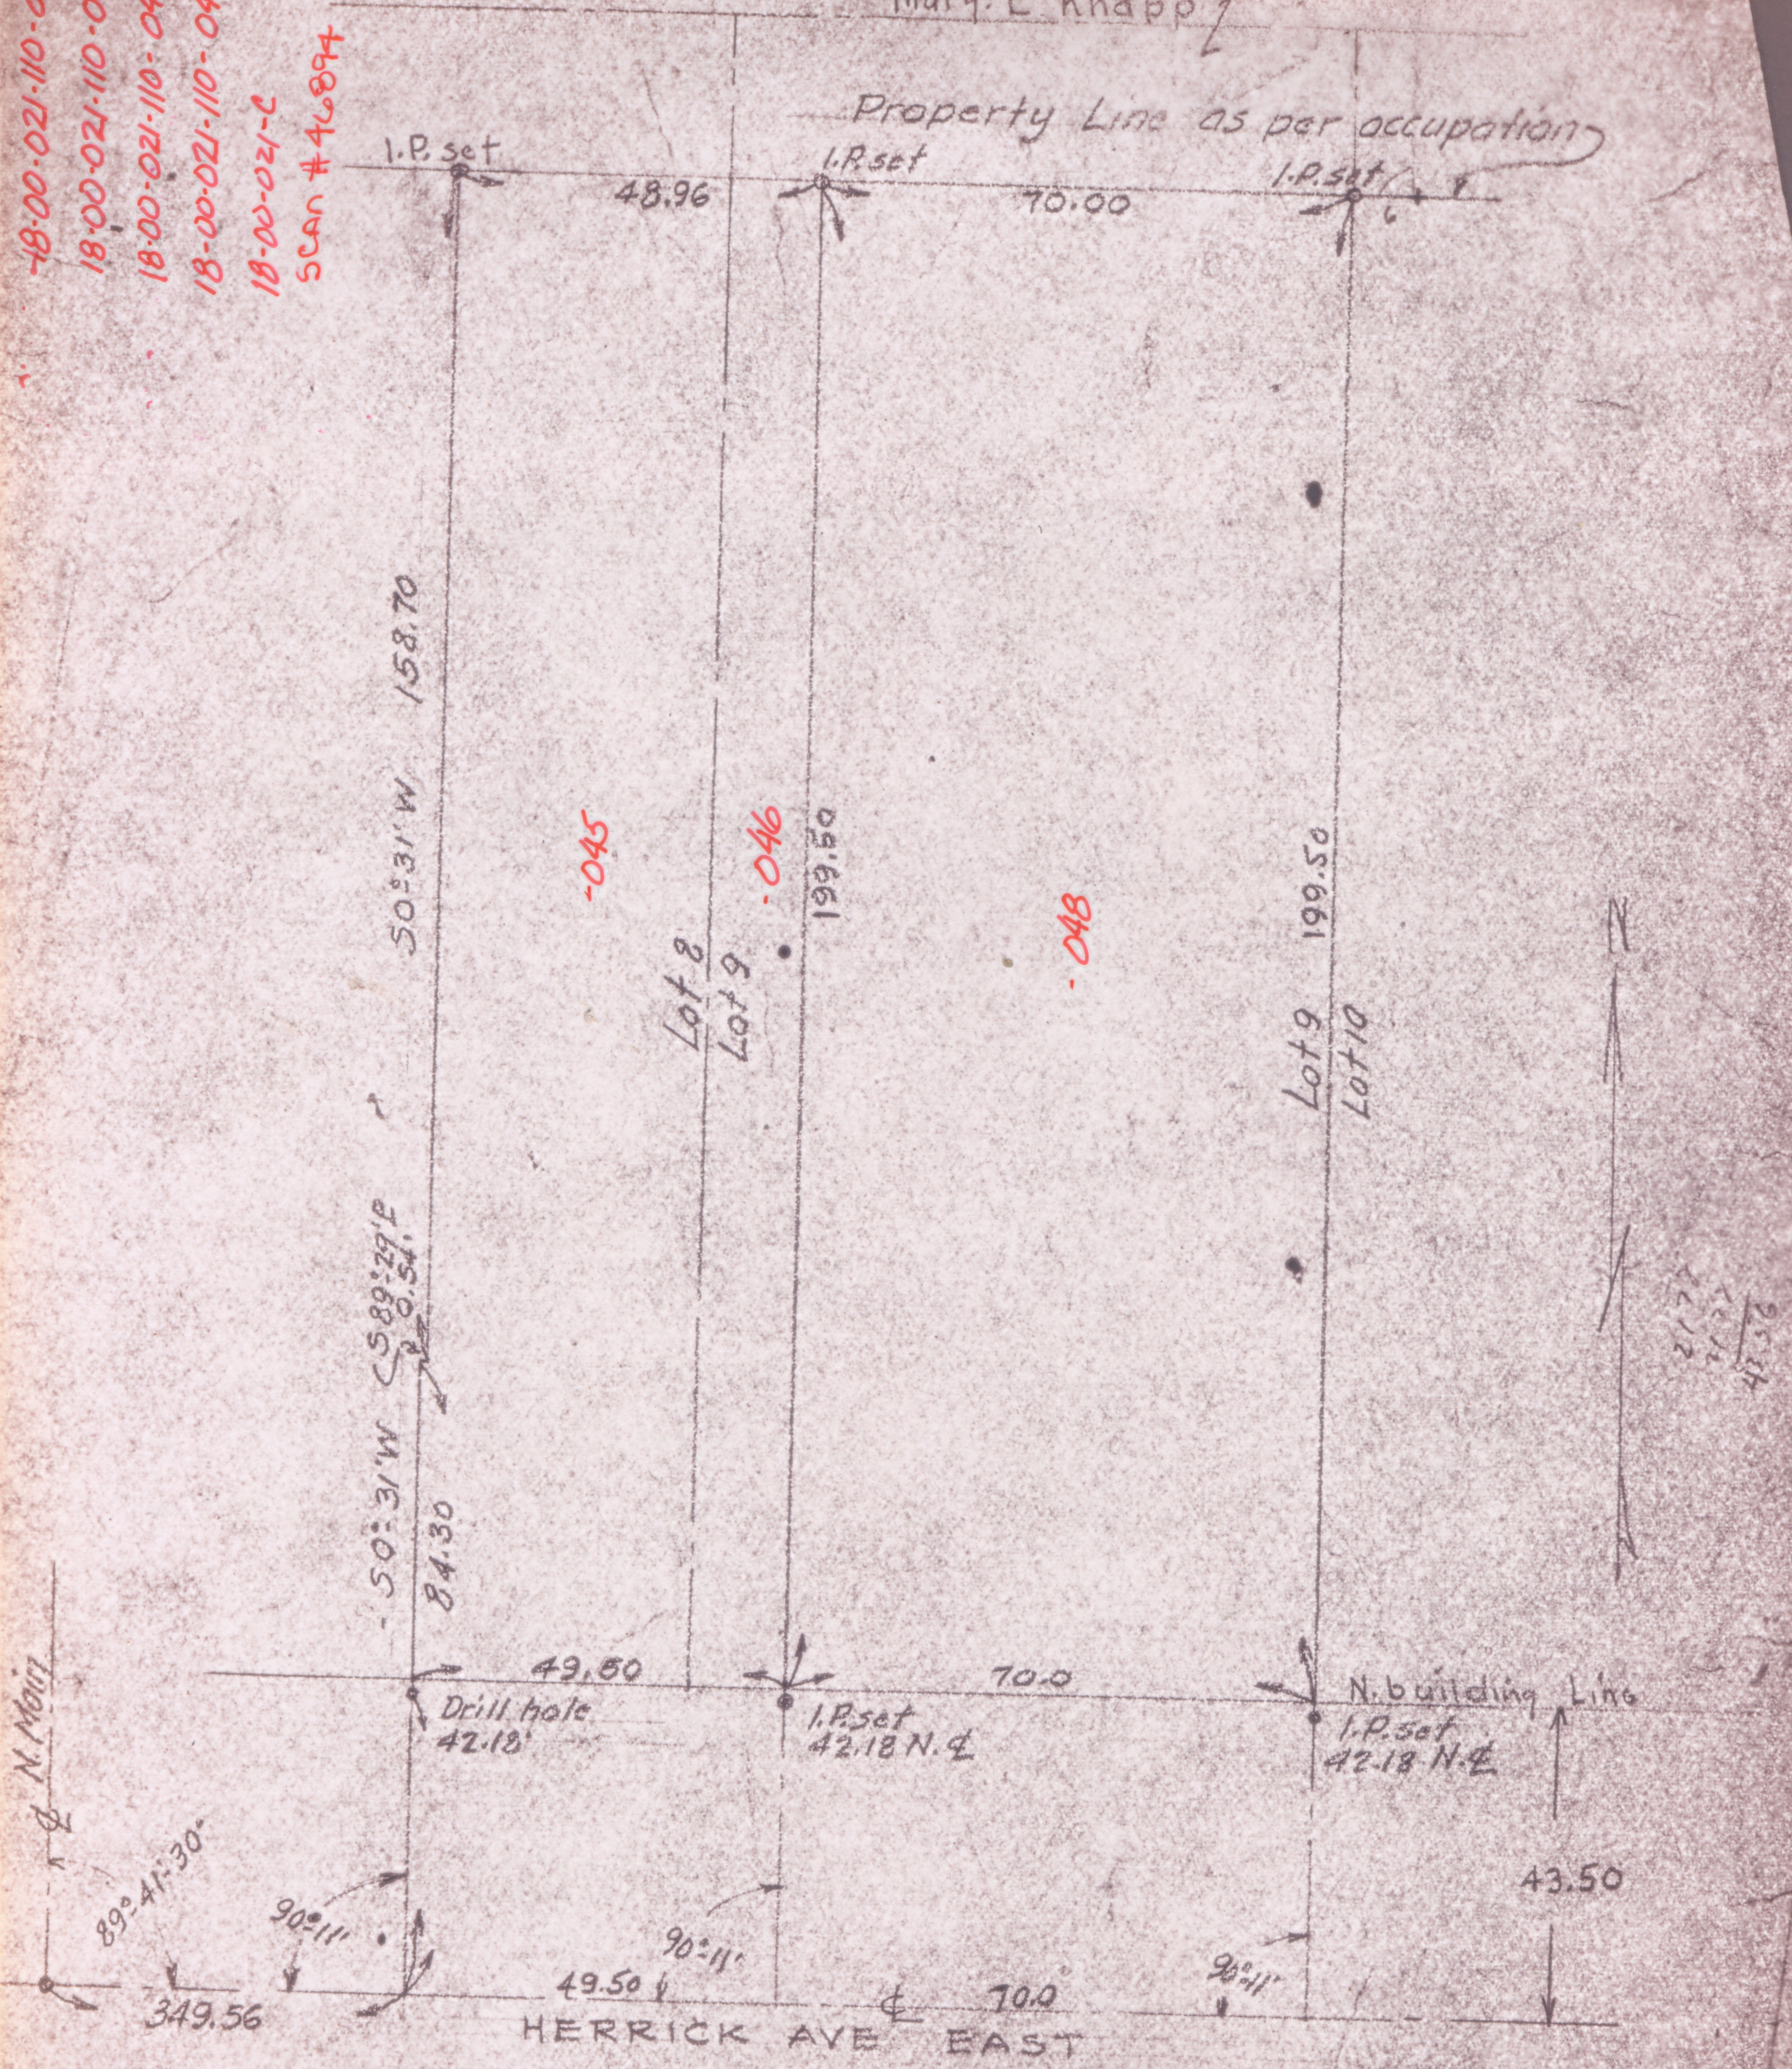

SURVEY FOR GUY E WELLS ETAL
 PARTS OF LOTS 8 & 9 O.V.P.
 WELLINGTON VILLAGE LORAIN CO. OHIO
 APRIL, 19, 1945 SCALE 1" = 30'