


18-00-021-110-077
18-00-021-110-078
18-00-021-C
SCAN # 46894

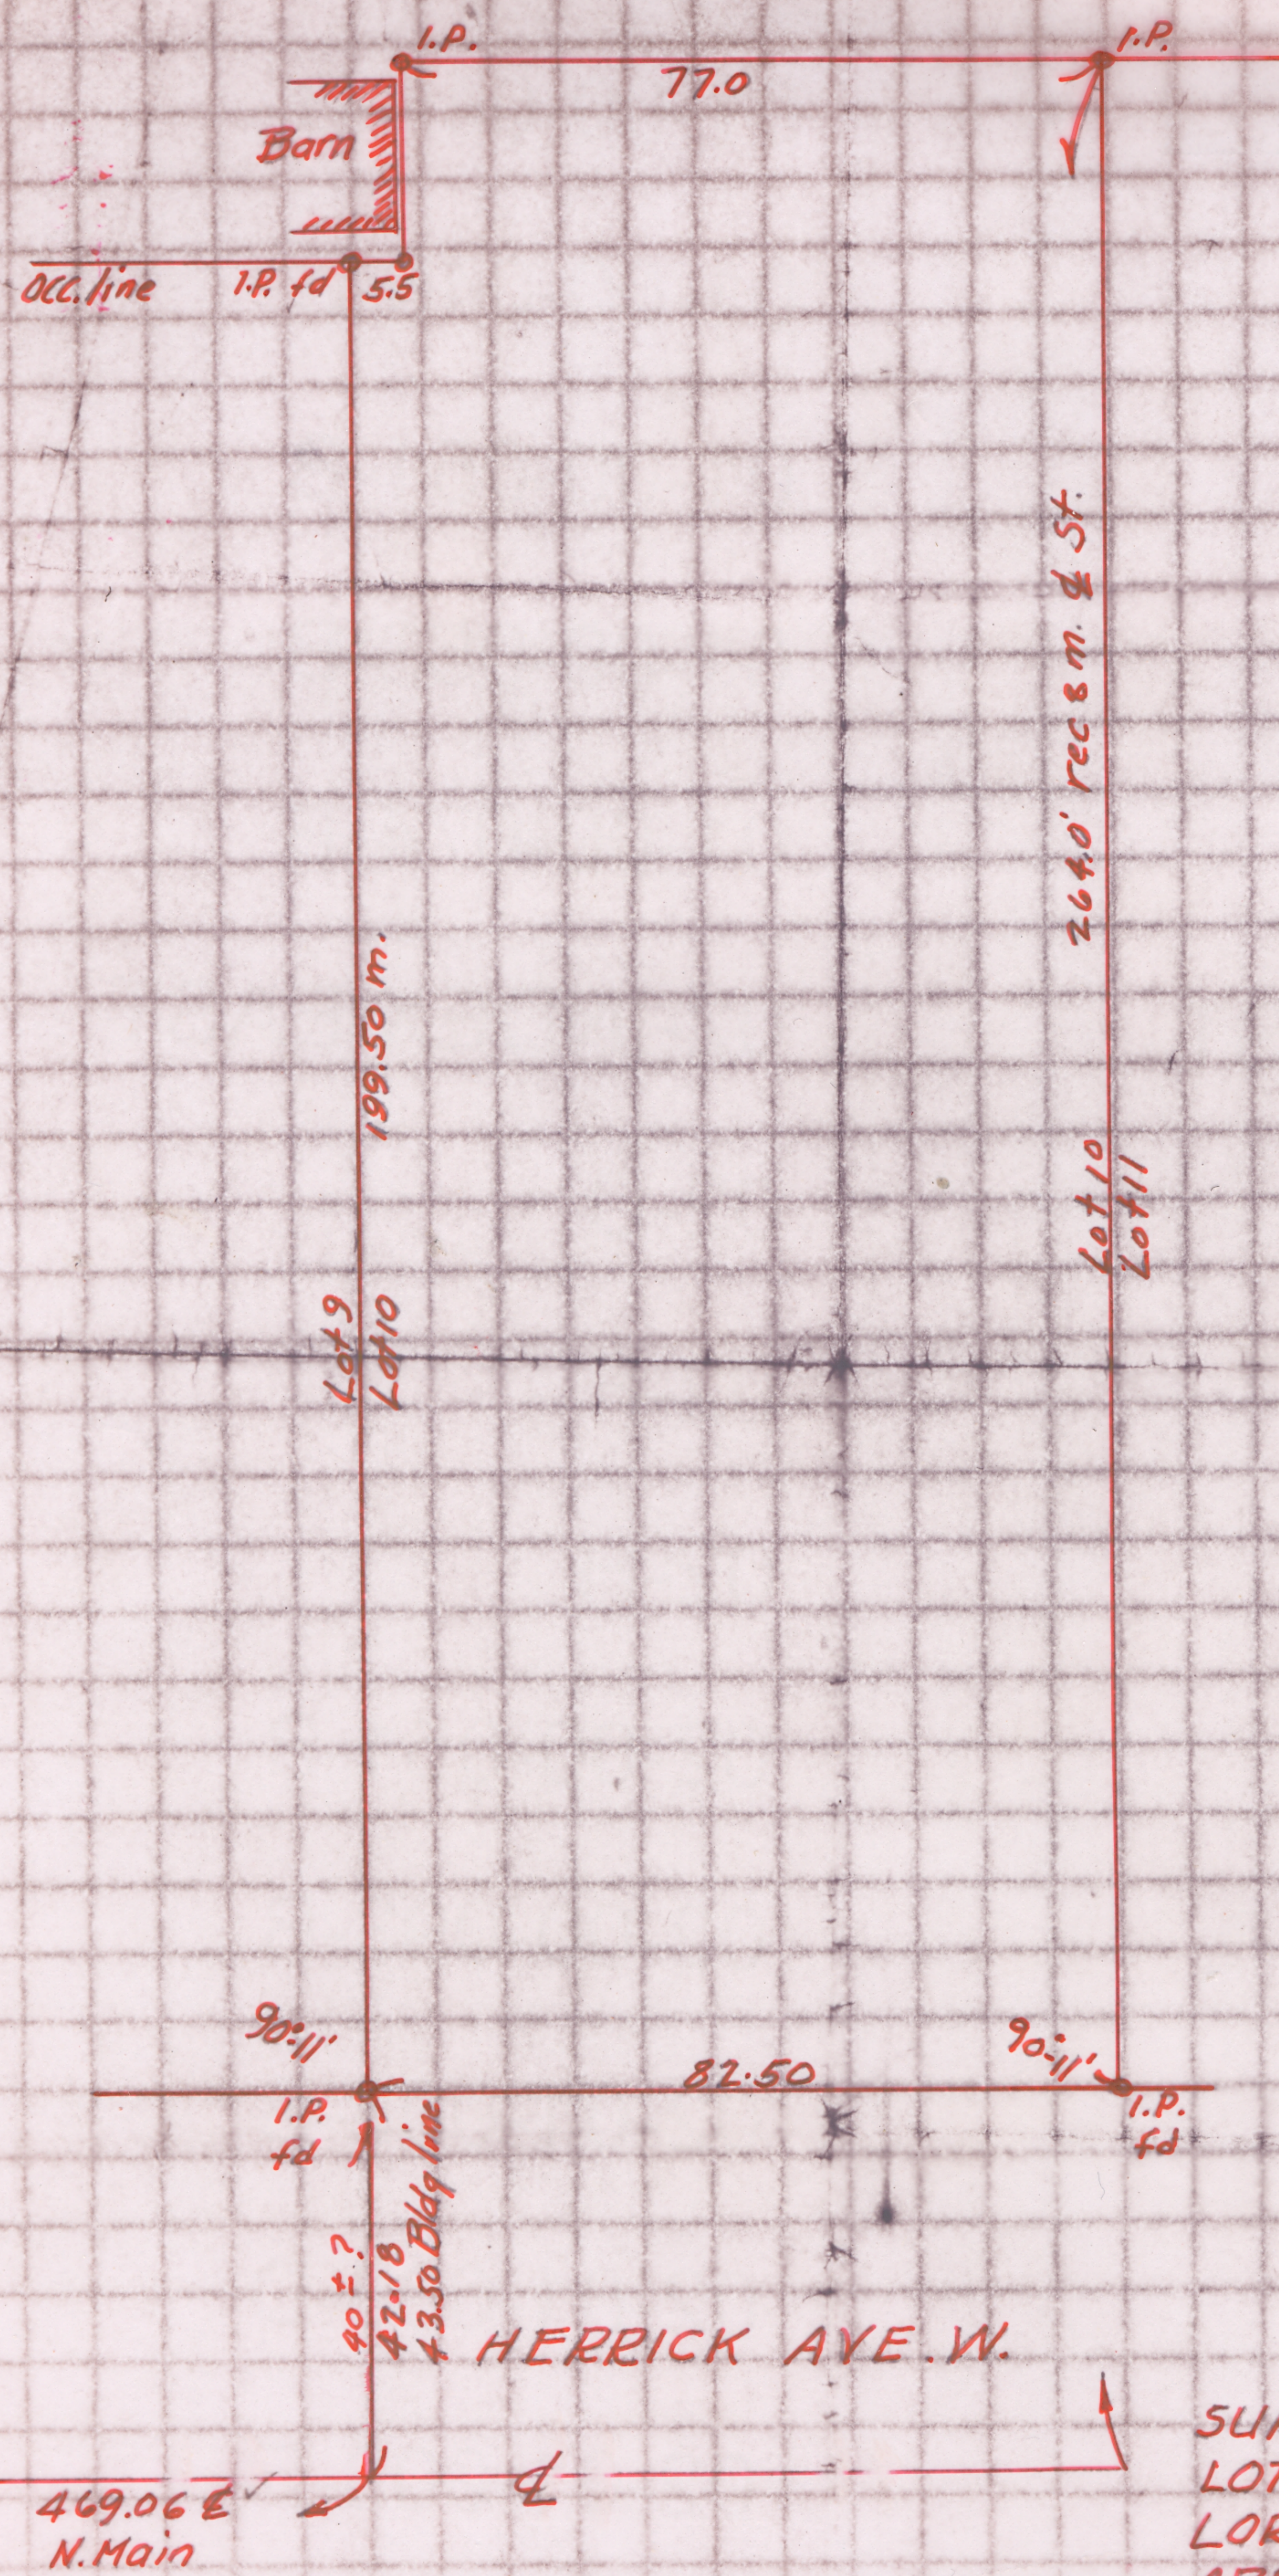

SURVEY FOR ROBERT S. MILLER
LOT 10 O.V.P. WELLINGTON VILL
LORAIN CO. OHIO. SCALE 1"=30'
APR. 27. 1954 T.W. LAUNDON
REG. SURVEYOR.