


18-00-021-113-005

18-00-021-C

SCAN # 46898

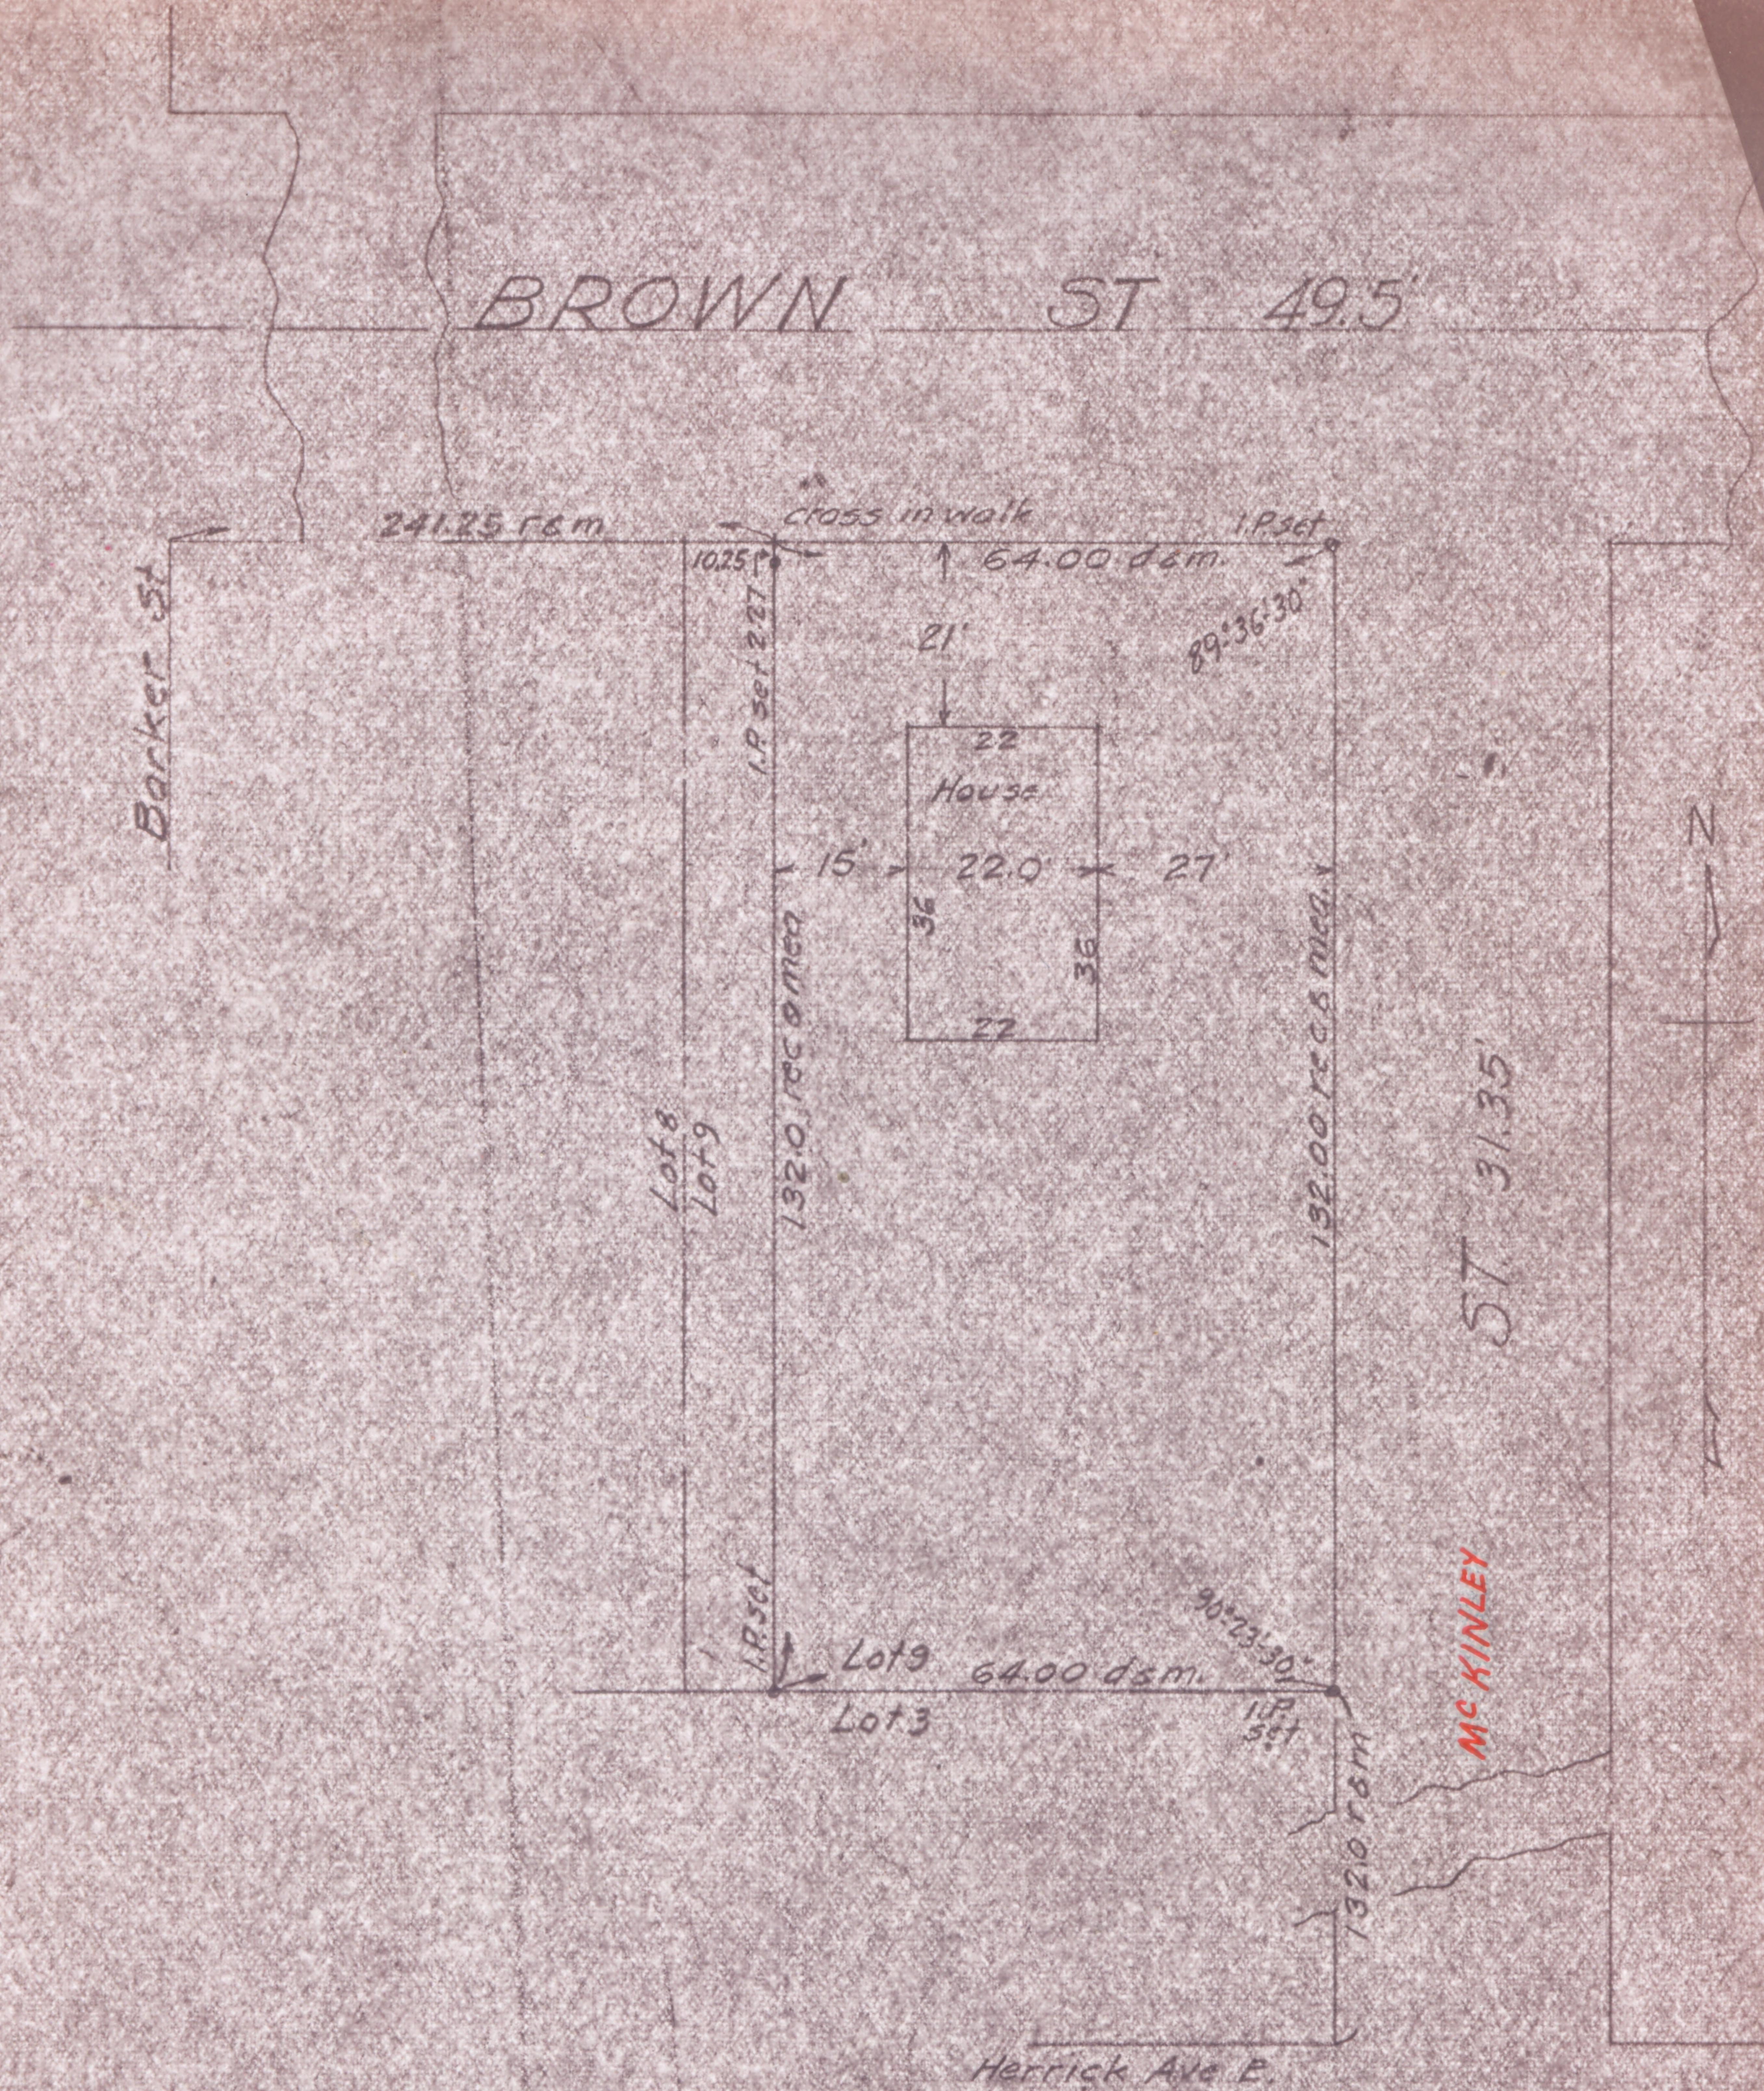

Survey for Harry W. Wagner  
 Part of Lot 9, Blk 5, O.V.P.  
 Village of Wellington  
 Lorain Co., Ohio. Scale 1" = 30'  
 March 26, 1940 T.W. Laundon, Reg. Surveyor