


18-00-022-102-001  
 18-00-022-102-002  
 18-00-022-A  
 Scan # 46903  
~~Serial #~~

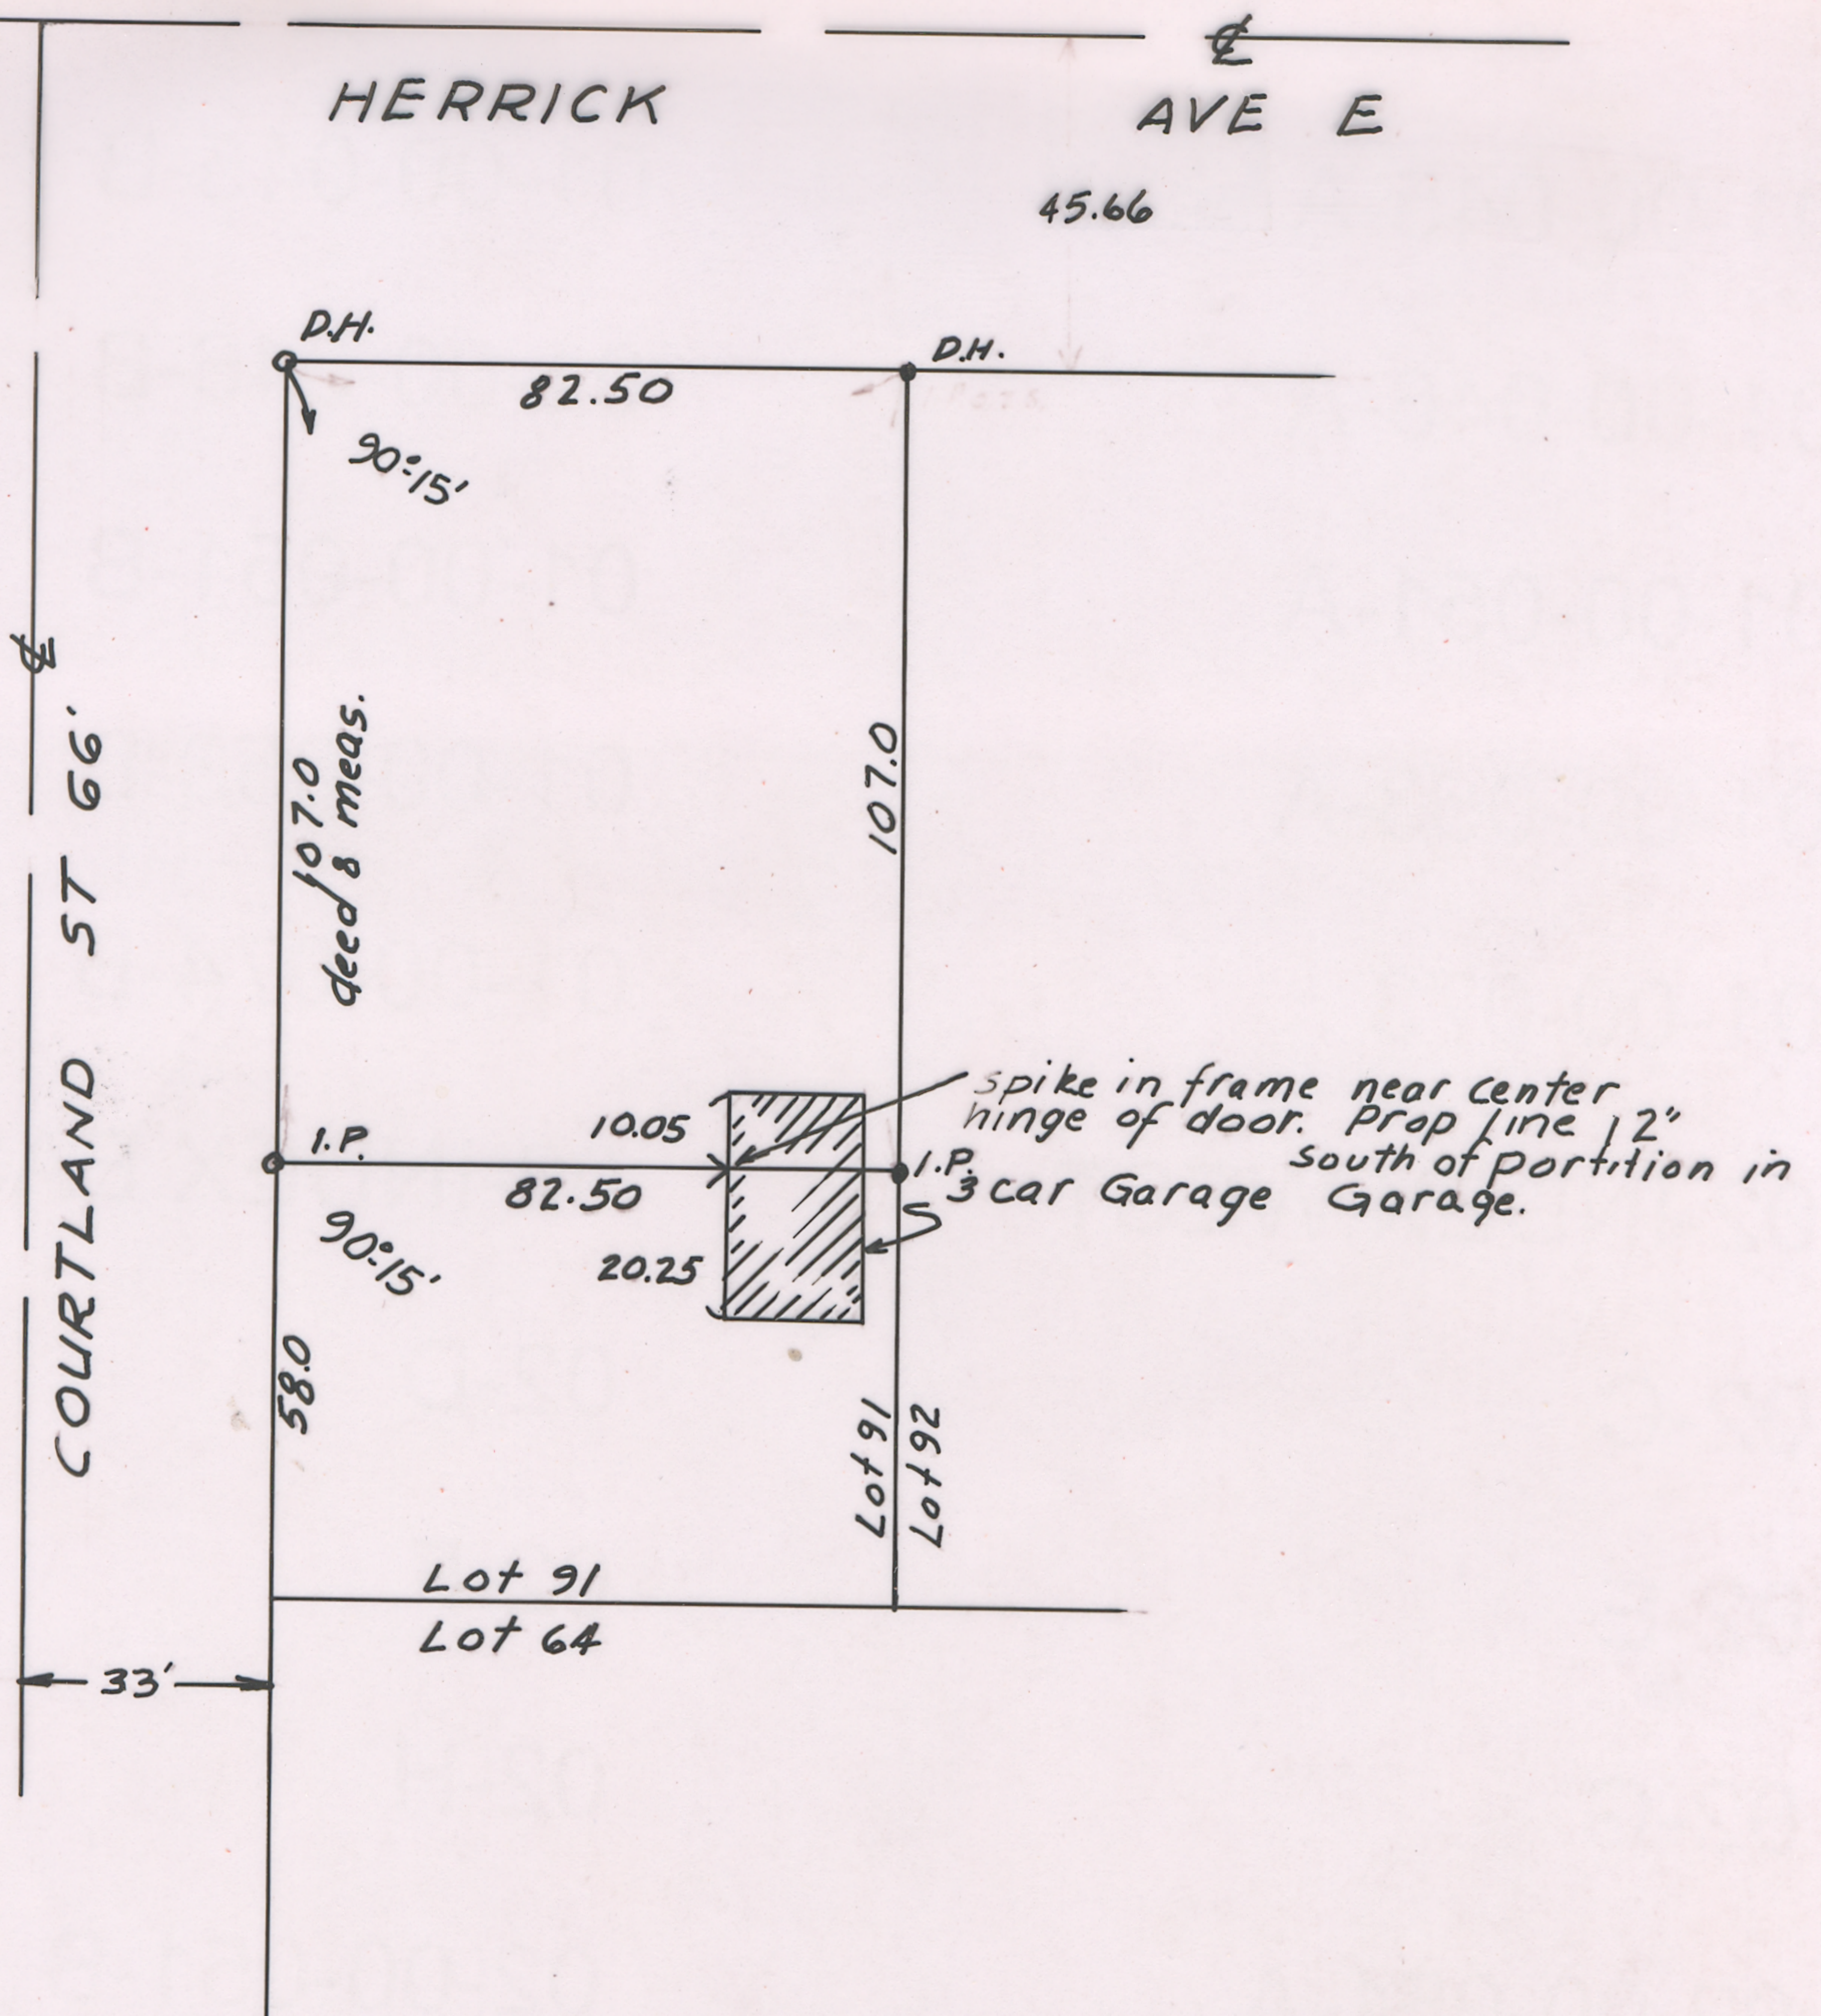

SURVEY FOR MABEL FORTNEY  
 PART OF LOT 92 BLK 4 R.A.HORR'S  
 ADD'N. WELLINGTON VILLAGE

LORAIN CO OHIO

SCALE 1" = 40'

AUG. 12. 1948

T.W. LAUNDON REGISTERED SURVEYOR

DH = 1/2" Drill hole in walk