


18-00-022-102-001
 18-00-022-102-002
 18-00-022-A, 105
 Scan #46904

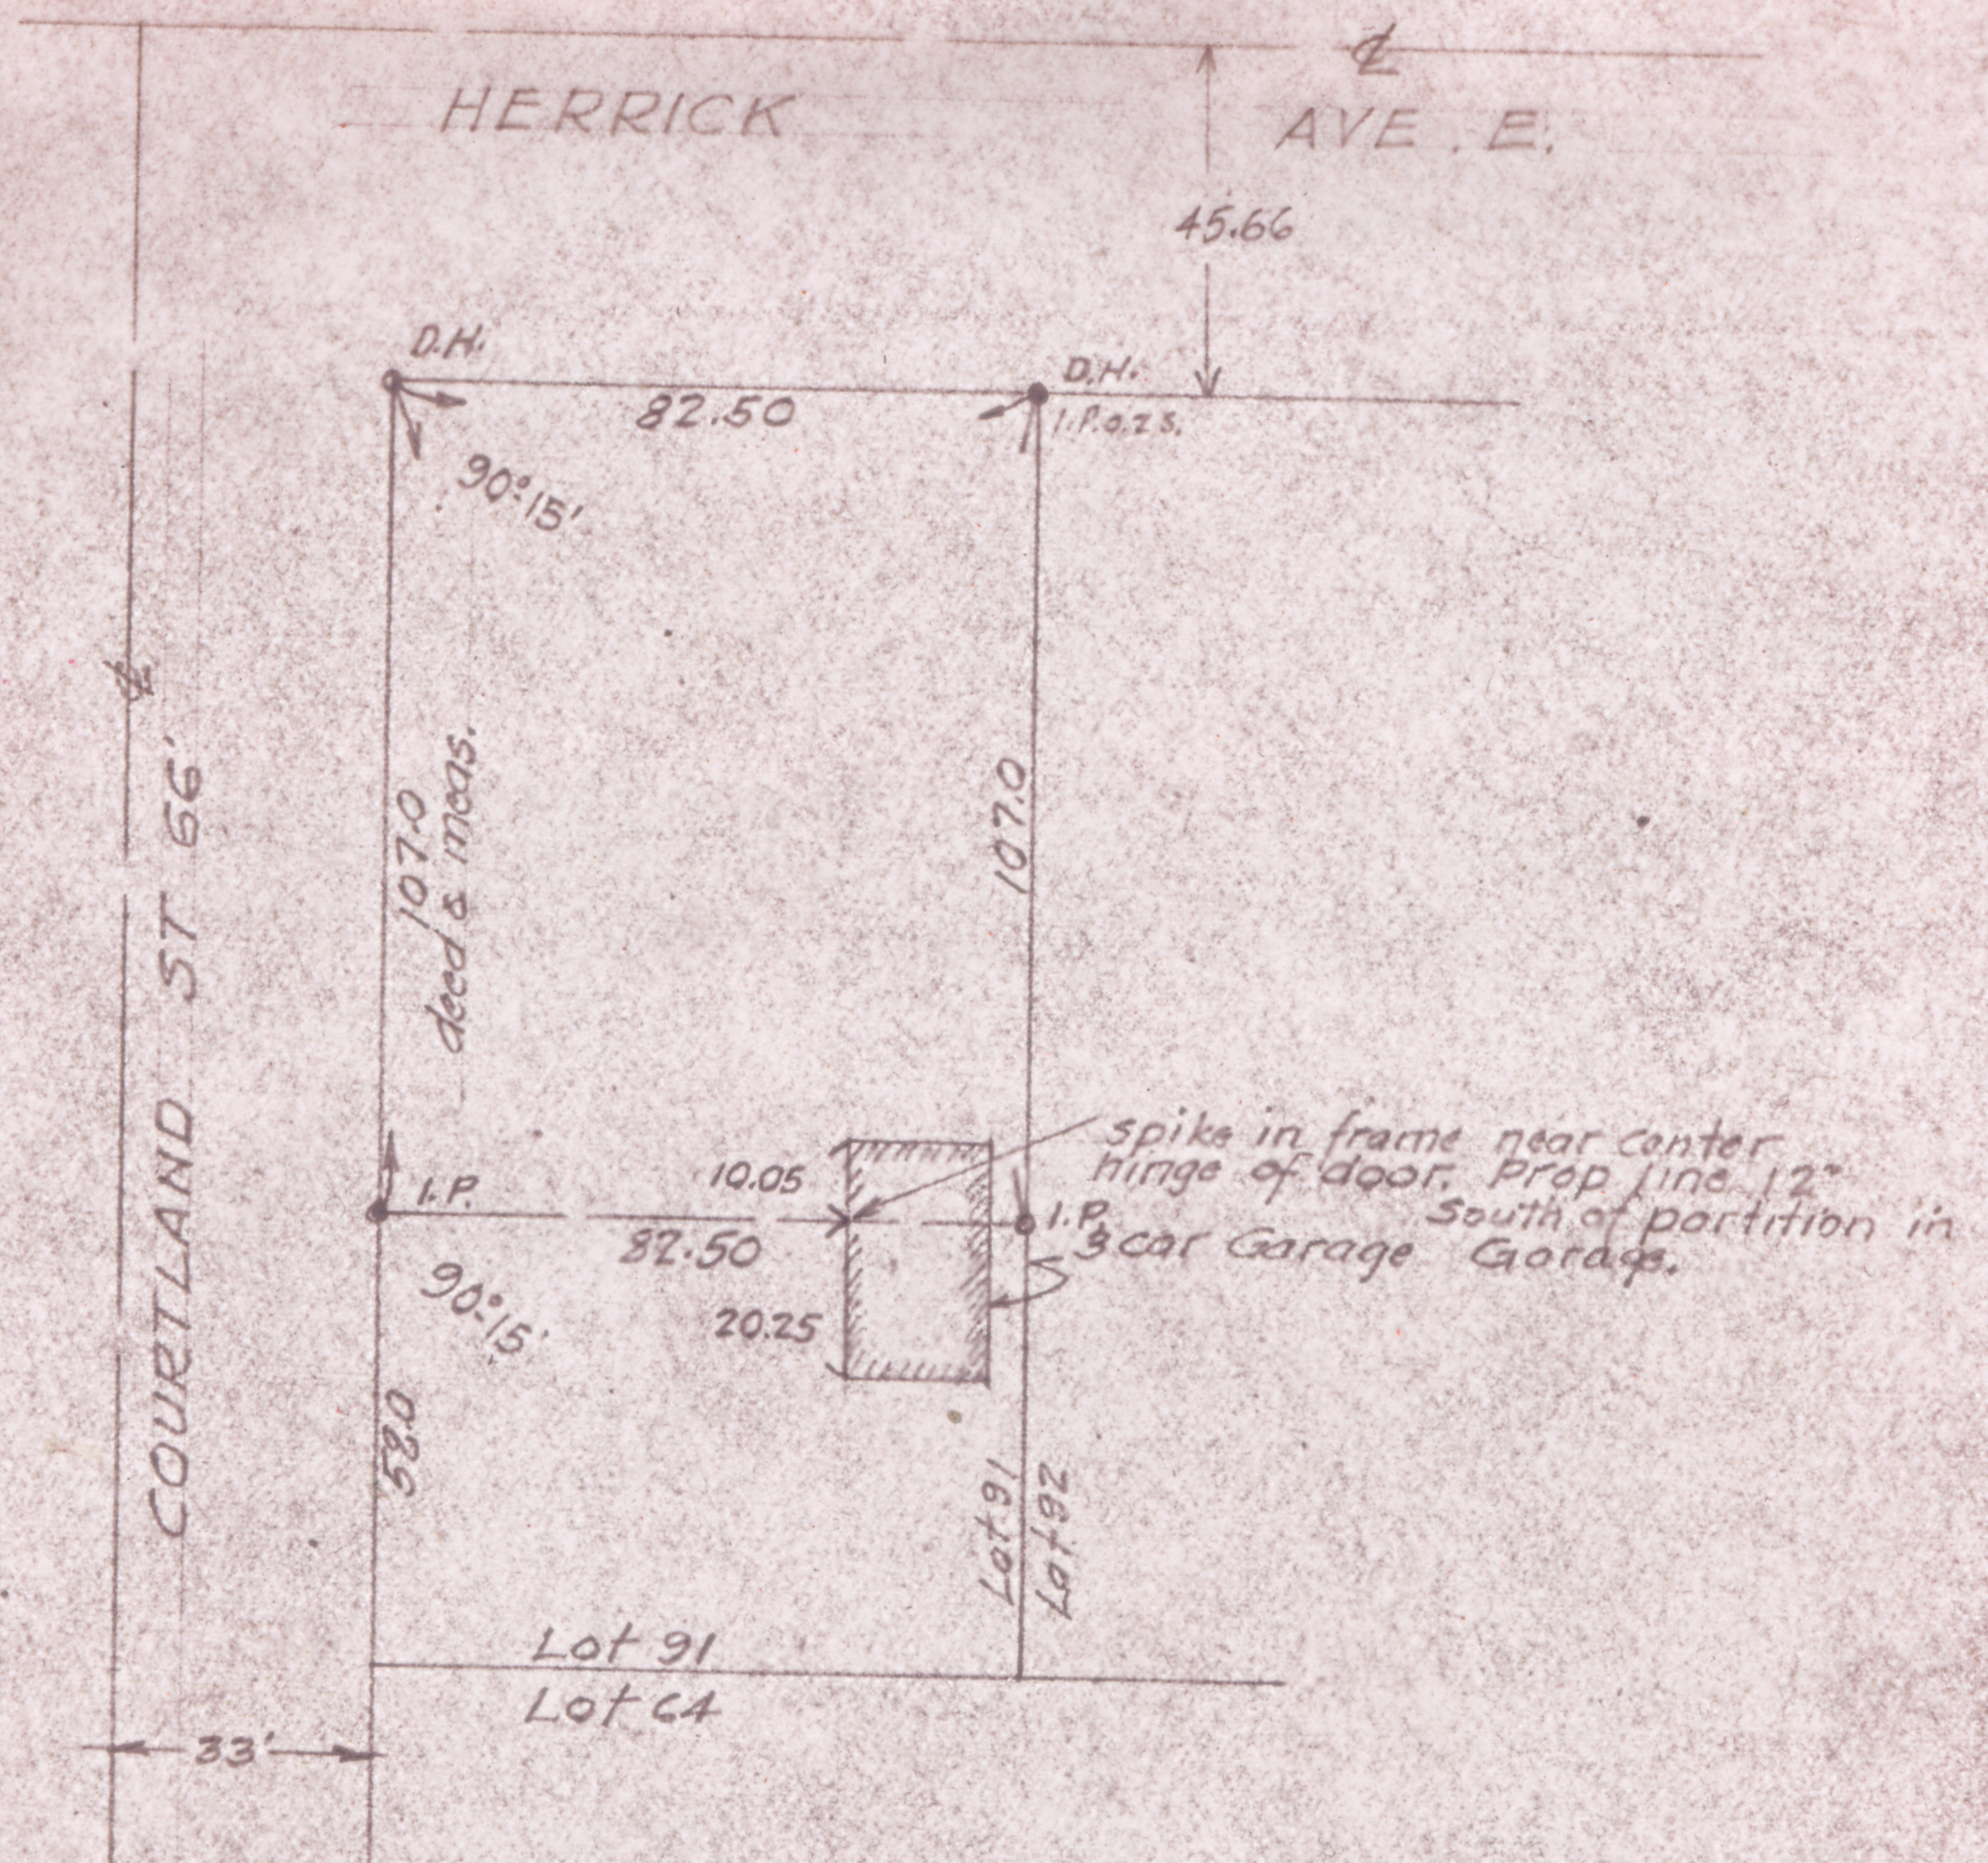

SURVEY FOR MABEL FORTNEY
 PART OF LOT 92 BLK 4 R.A. HOBBS
 ADDN. WELLINGTON VILLAGE,
 LORAIN CO OHIO
 SCALE 1" = 40' AUG. 12, 1948
 T.W. LAUNDON REGISTERED SURVEYOR

D.H. = 1/2" Drill hole in walk