


WEST MAIN ST.

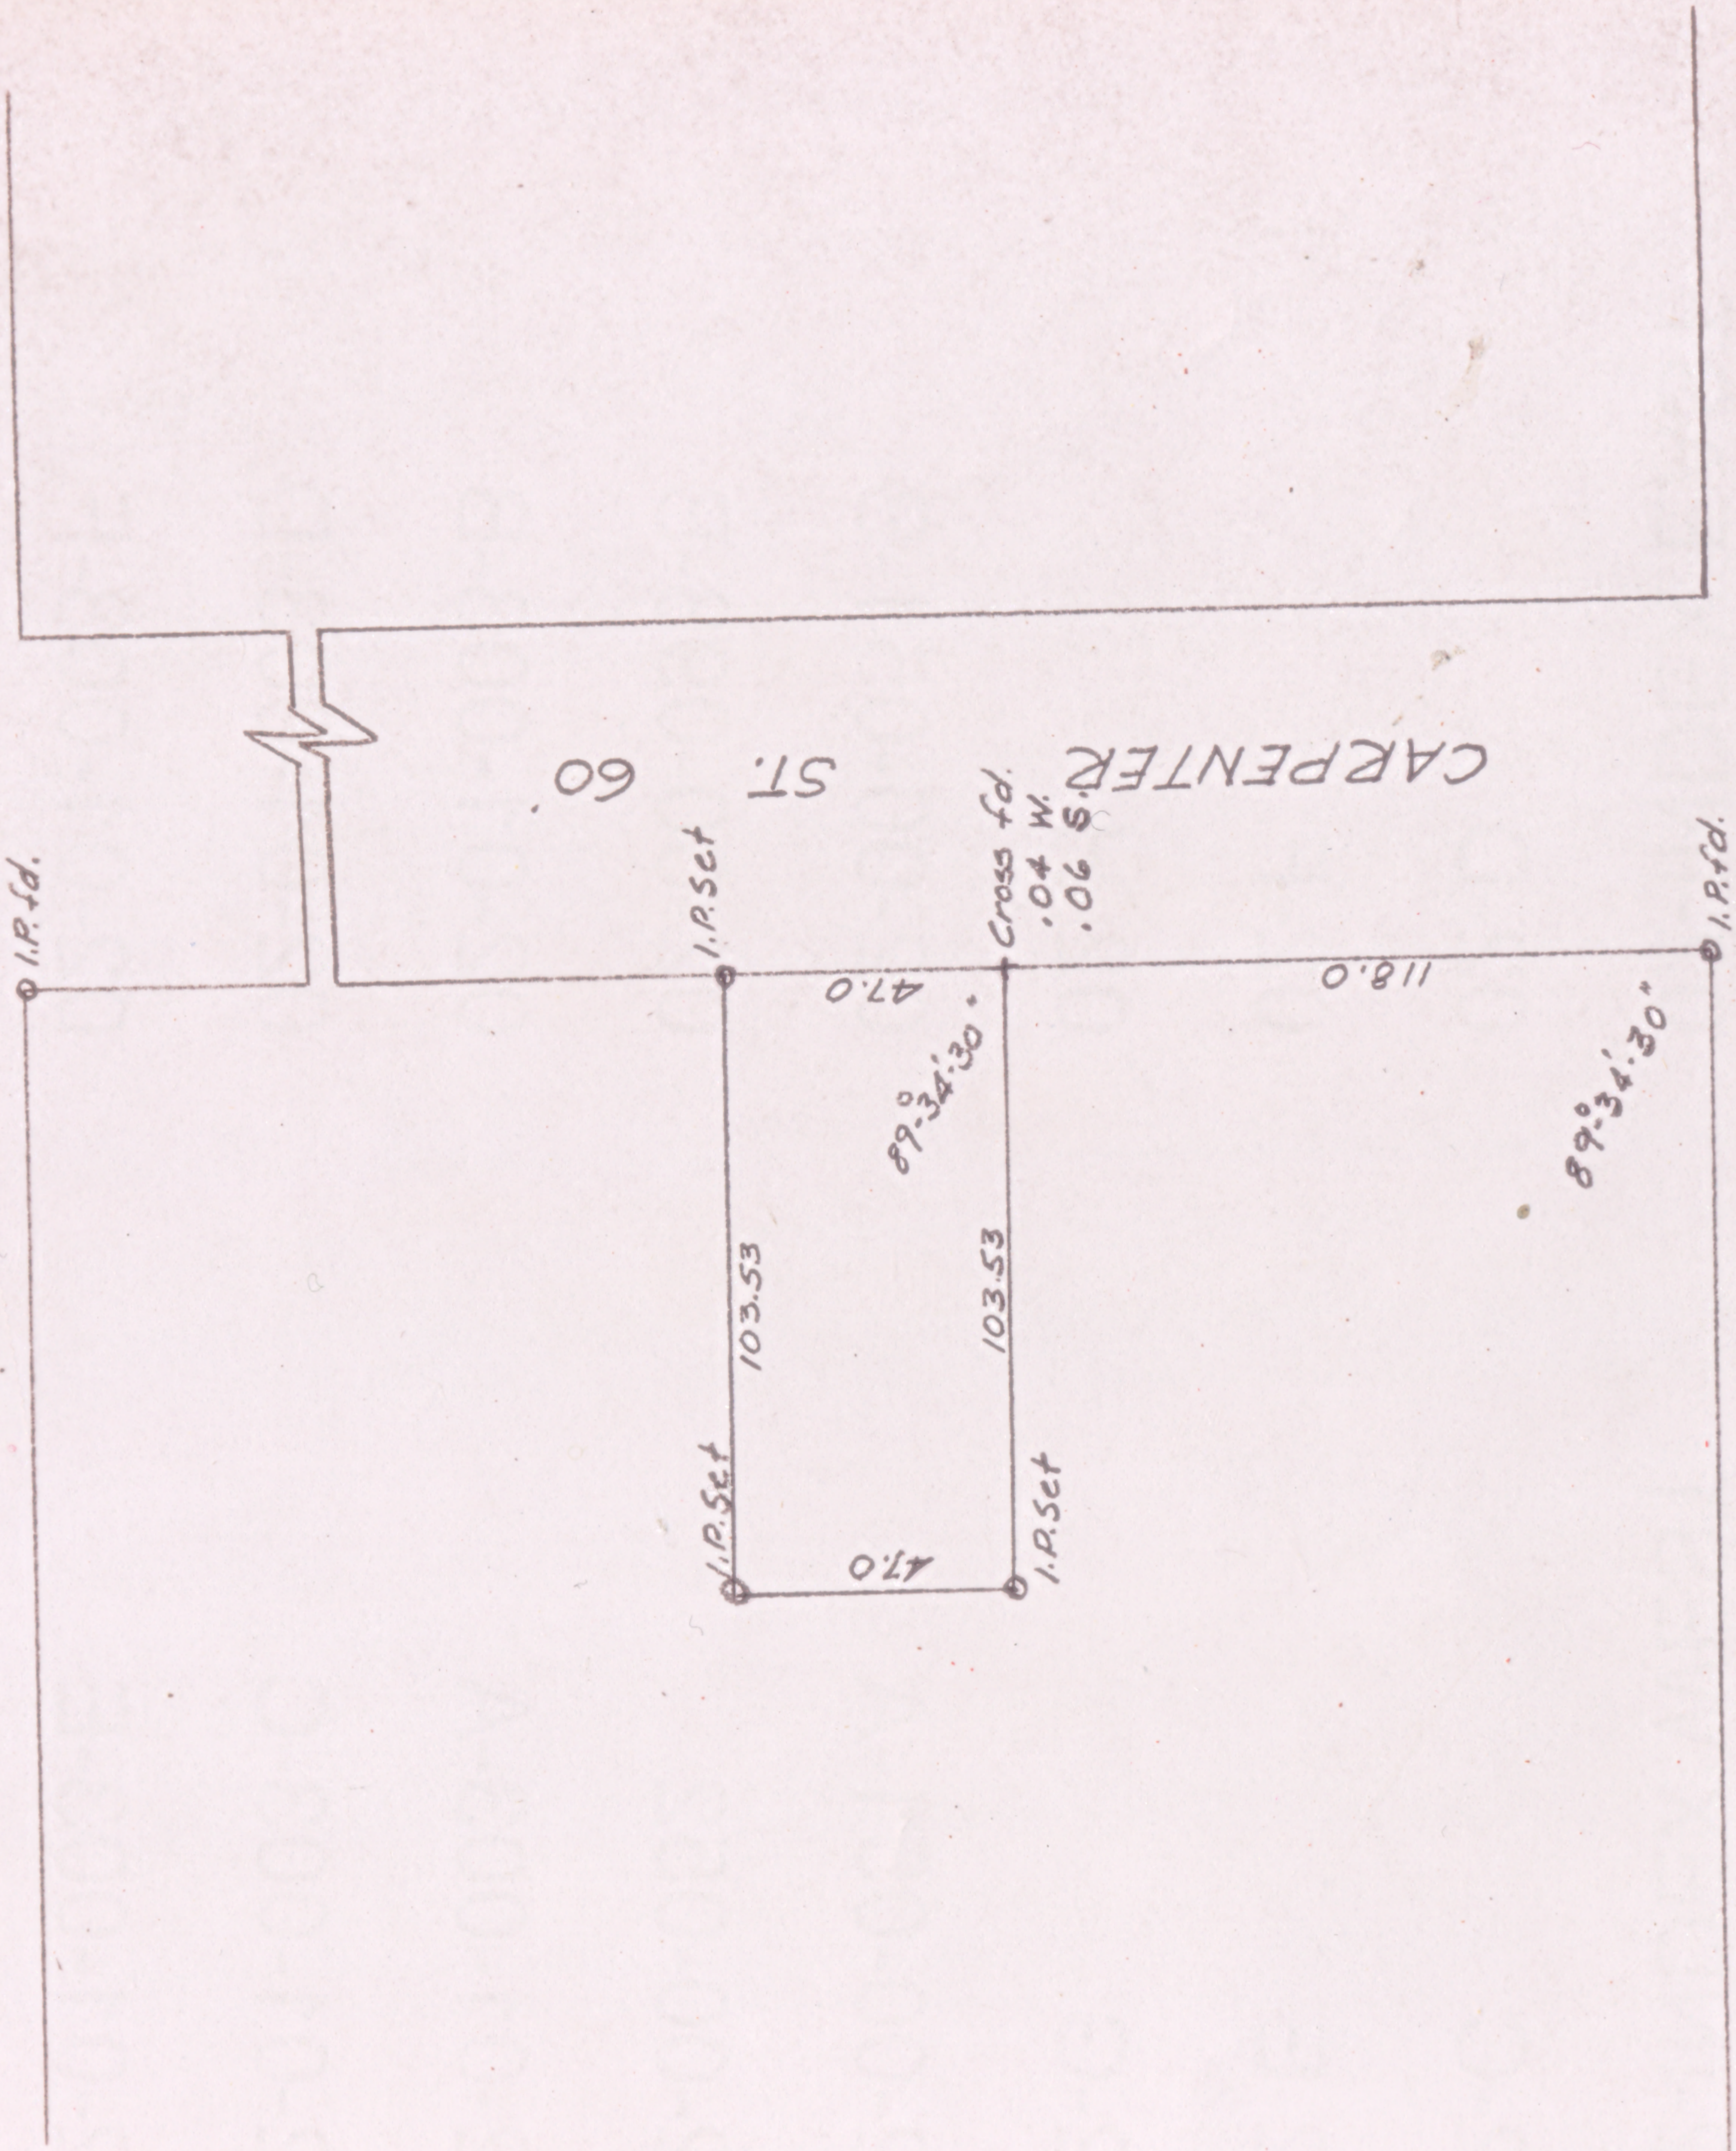

CARPENTER ST. 60'

COURTLAND ST. 66'

• I.P. at Pleasant St.

18-00-022-107-019
18-00-022-A
SCAN #46905

SURVEY FOR LEON N. WEITZEL
WELLINGTON VILL. - LORAIN CO. - OHIO
SCALE 1"=50'
JULY 1959
LAUNDON & HUFFMAN - Reg. Surveyors

LA N