

State of Ohio
Registered Professional
Engineer and Surveyor
Office 5811
Phone Home 2094


Surveys for Agnes Close
Lots 51 & 52 - Lots 42 & 43, Bk 1
Wellington Village Lorain Co. Ohio.
Scale 1"=50' Sept 26, 1944
T.W. Laundon Registered Surveyor



PROSPECT ST 60

THOMAS W. LAUNDON
CIVIL ENGINEER AND SURVEYOR
405 Elyria Building
ELYRIA OHIO

Municipal Engineering
Survey - City, Farm,
Sub-divisions

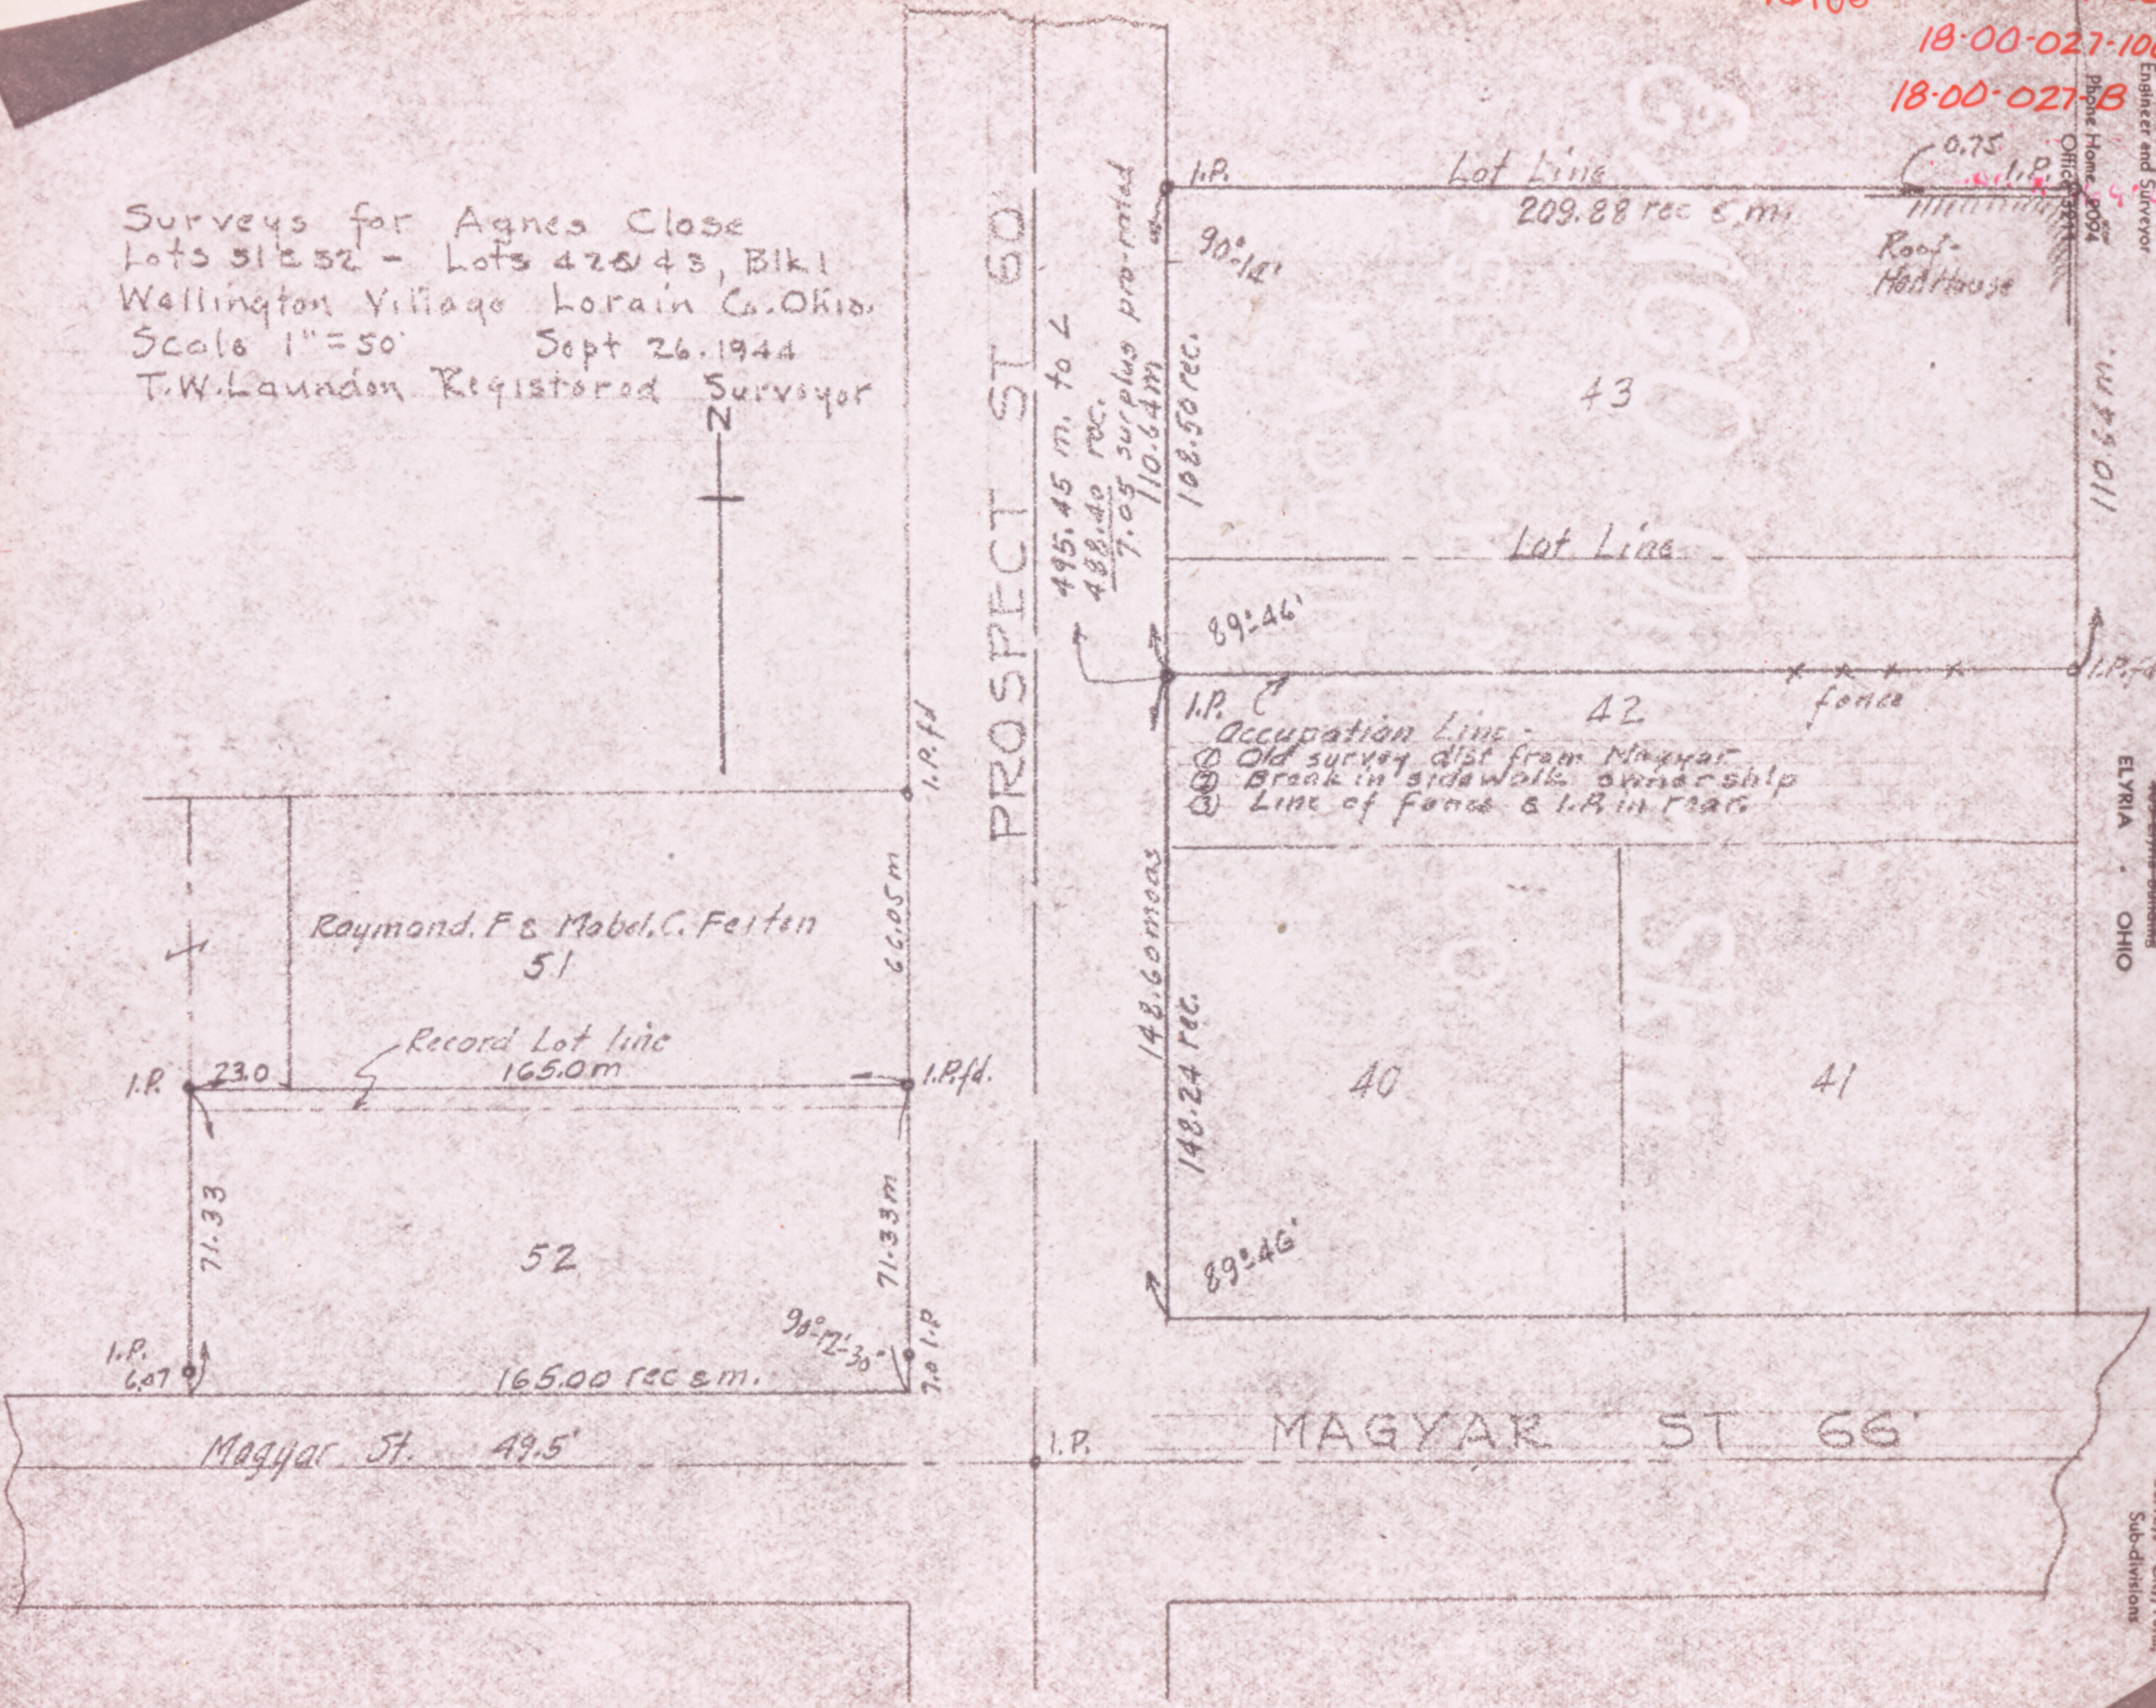

Raymond F. & Mabel C. Feiten
51

Record Lot line
165.0m

52

Magyar St. 49.5'

MAGYAR ST 66

43

40

41

42

Occupation Line -
① Old survey dist from Magyar
② Break in sidewalk ownership
③ Line of fence & I.P. in rear

Roof-Hed House

495.45 m. to L
488.40 rec.
7.05 surplus pro-rated
110.64m

148.60 meas
148.24 rec.

Lot Line
209.88 rec 5 m.

Lot Line

110.64 m.

I.P. 23.0

I.P. fd.

I.P. fd.

I.P.

I.P.

I.P.

I.P. fd.

I.P. 6.07

I.P.

90°12'

89°46'

89°46'

90°12'30"

0.75