

SCAN # 46911 Pt. 18-00-027-III-026

18-00-027-B
PROSPECT ST. 60'

Stone Mon.
in box fd.

MAGYAR

ST. 66'

455.62

90°-15'-30"

48.0 r


90°-15'-30"

LOTTIE CARINO 12-19-40 307-595

Lot 33
Lot 39

165.73

N. 0°-22'-15" W.

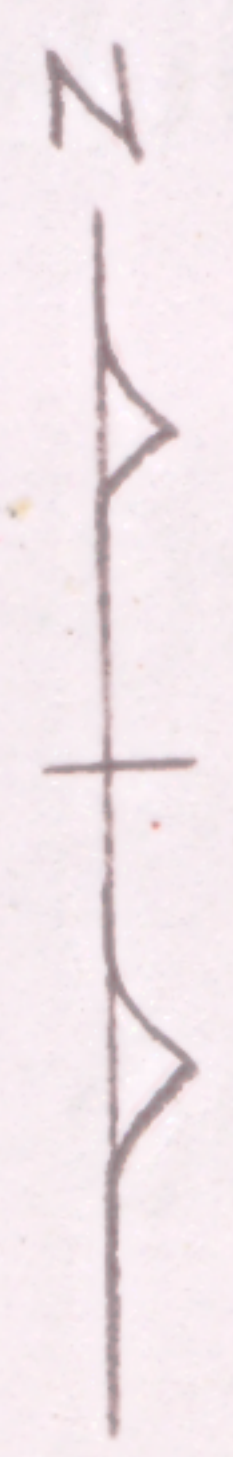

Lot 34
Lot 33

I.P. fd. I.P. Set S. 89°-19'-56" W.

28.87

33.13

I.P. fd. S. 89°-19'-58" W.

48.0 r. I.P. fd.

144.02

N. 1°-03'-20" E.

99.41

132.55 m.

N. 0°-27'-02" W.

20' d.

Lot 33
Lot 15

173.86 m.

I.P. Set

Lot 90
S. 89°-20'-07" W.

I.P. Set

N. 0°-23'-13" W.
Lot 88
Lot 90

SURVEY FOR MILDRED M. McCORMICK
PART OF LOTS 33 & 34 ALL OF LOT 15
BLOCK 1 ORIGINAL VILLAGE PLAT

VILLAGE OF WELLINGTON
LORAIN COUNTY OHIO
OCTOBER 1964
LAUNDON & HUFFMAN SURVEYORS
SCALE 1"=40'