


T.W. LAUNDON
REGISTERED SURVEYOR #685

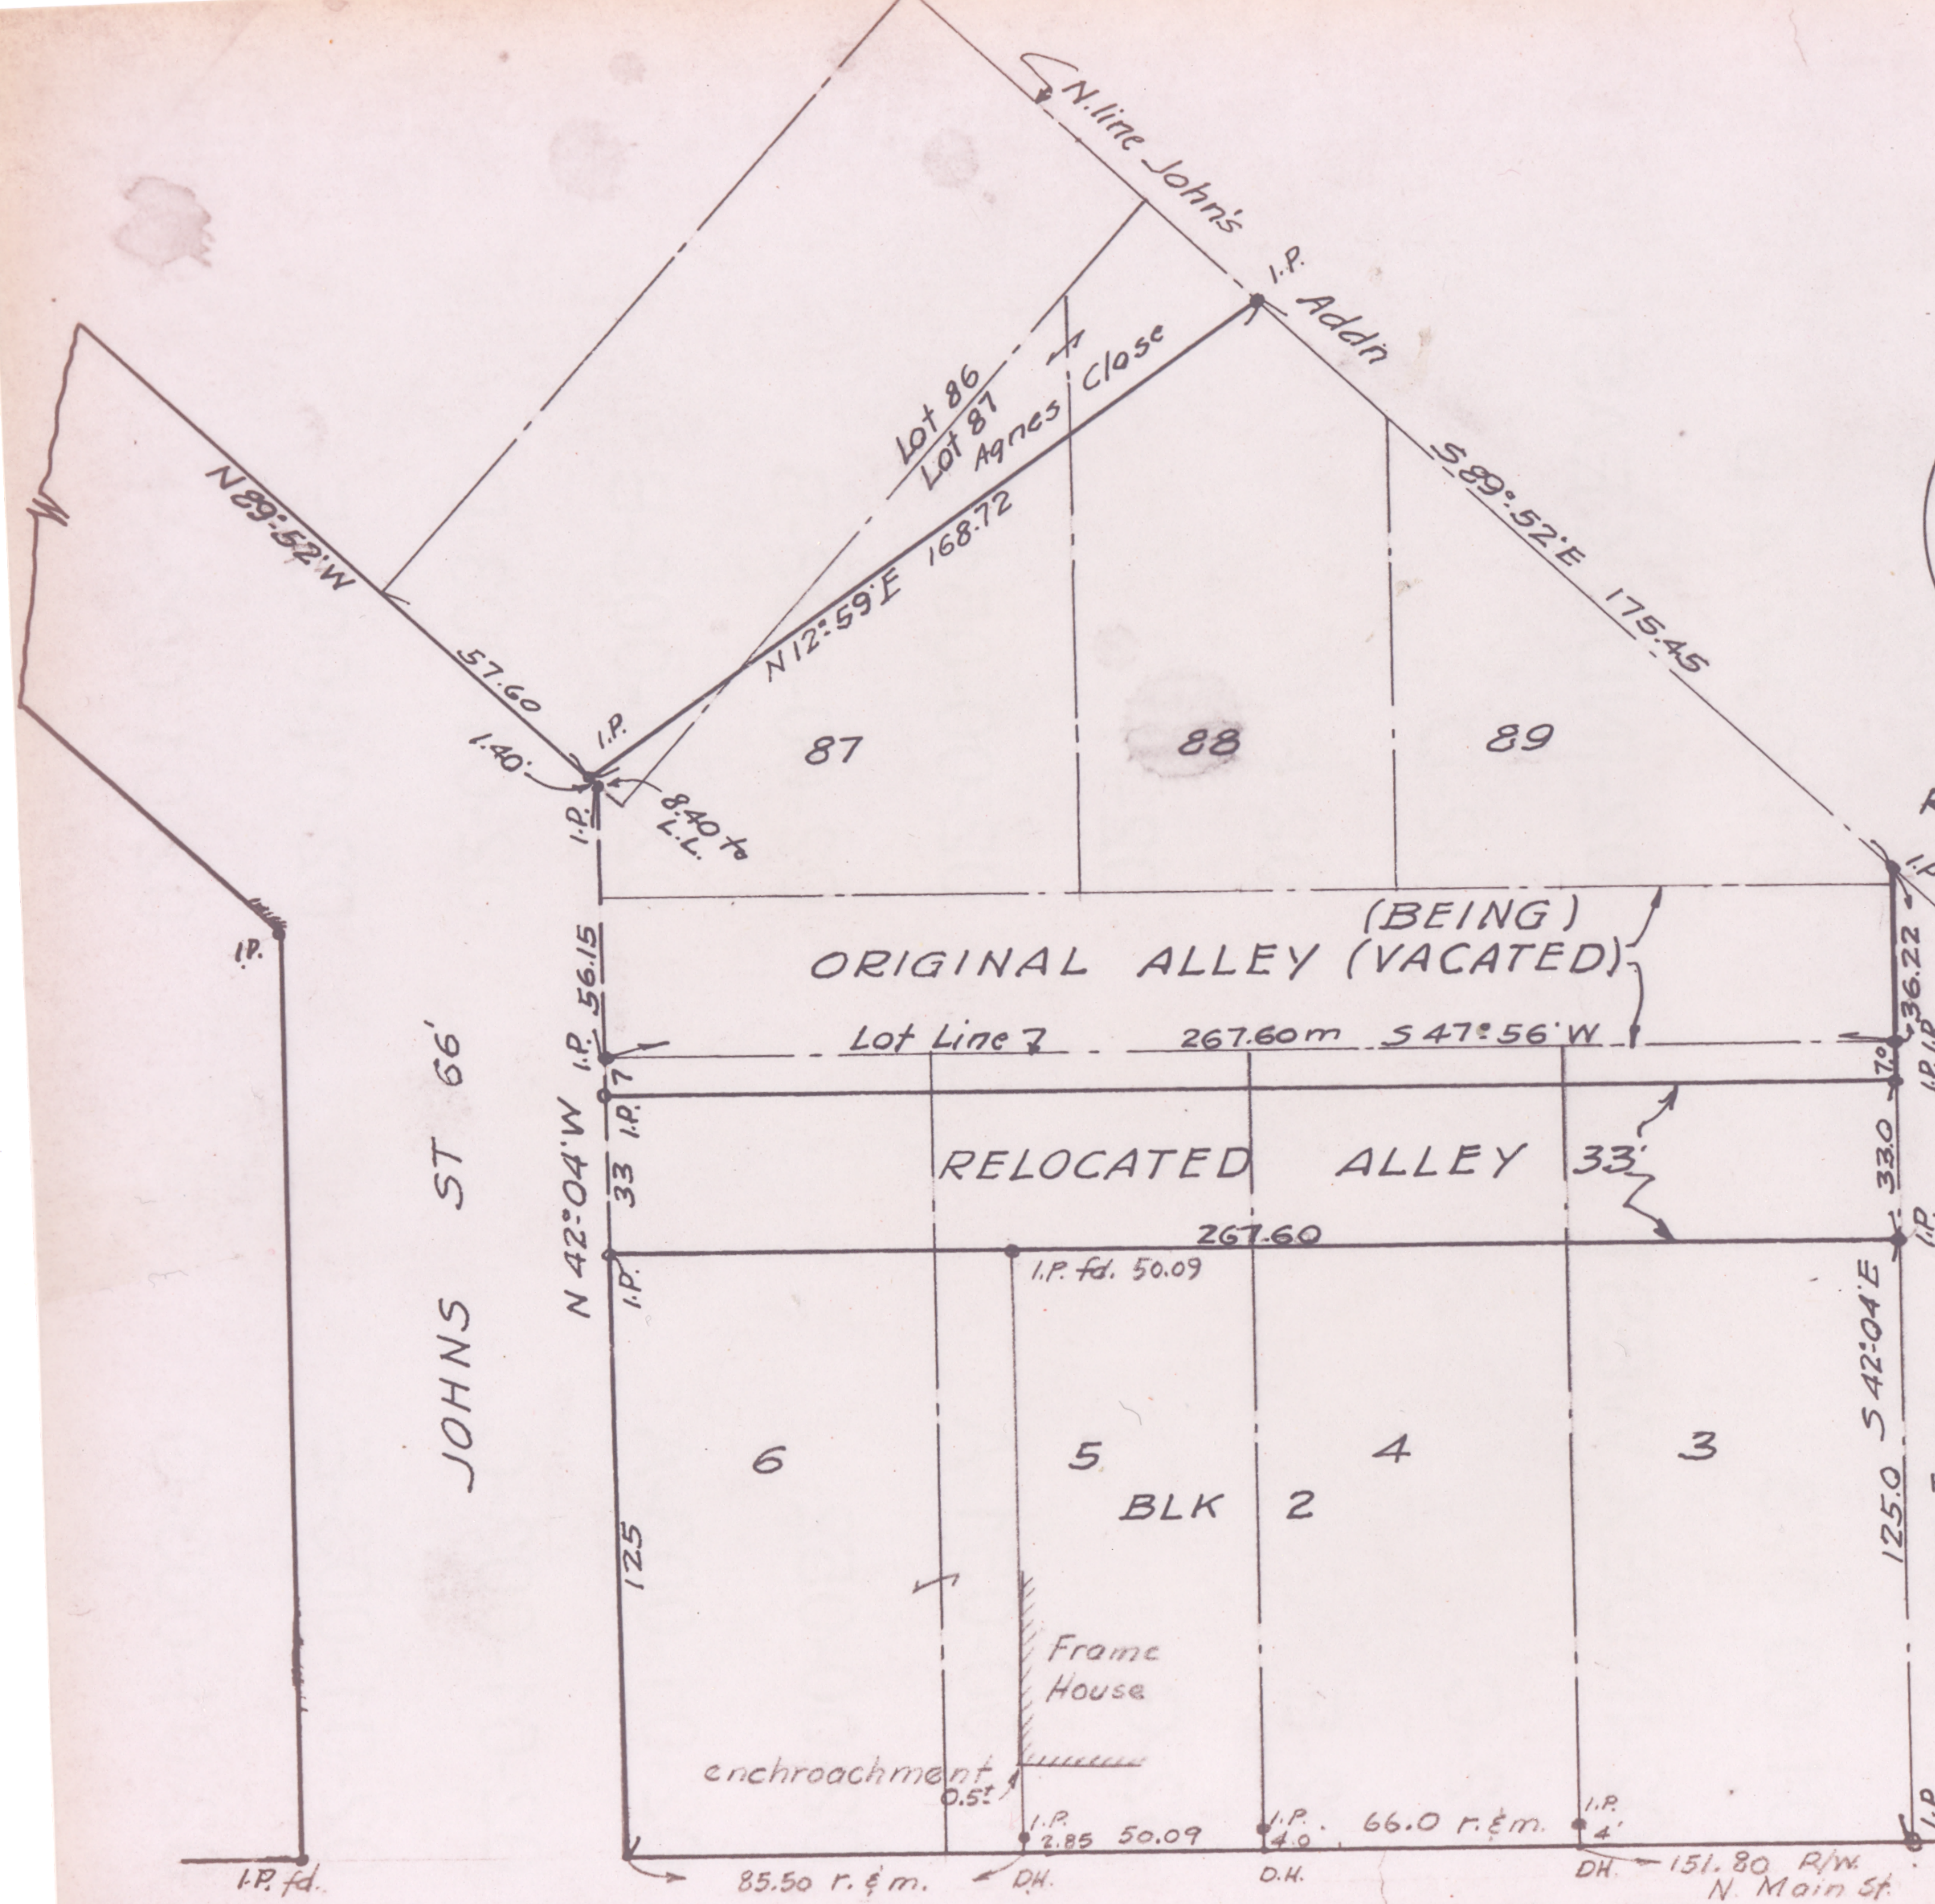

REVISED FOR SURVEY
N.E. PARCEL (50.09') 5/8 5
OCT. 6; 1964

A.B. Jones

SURVEY FOR
BOARD OF PUBLIC AFFAIRS
WELLINGTON VILLAGE
PARTS OF LOTS 3-4-5-6-86-87-
ALL OF LOT 89, BLK 2, DJ JOHN
ADDN. P.V. 1- PG. 36.
WELLINGTON VILLAGE
LORAIN CO. OHIO.