
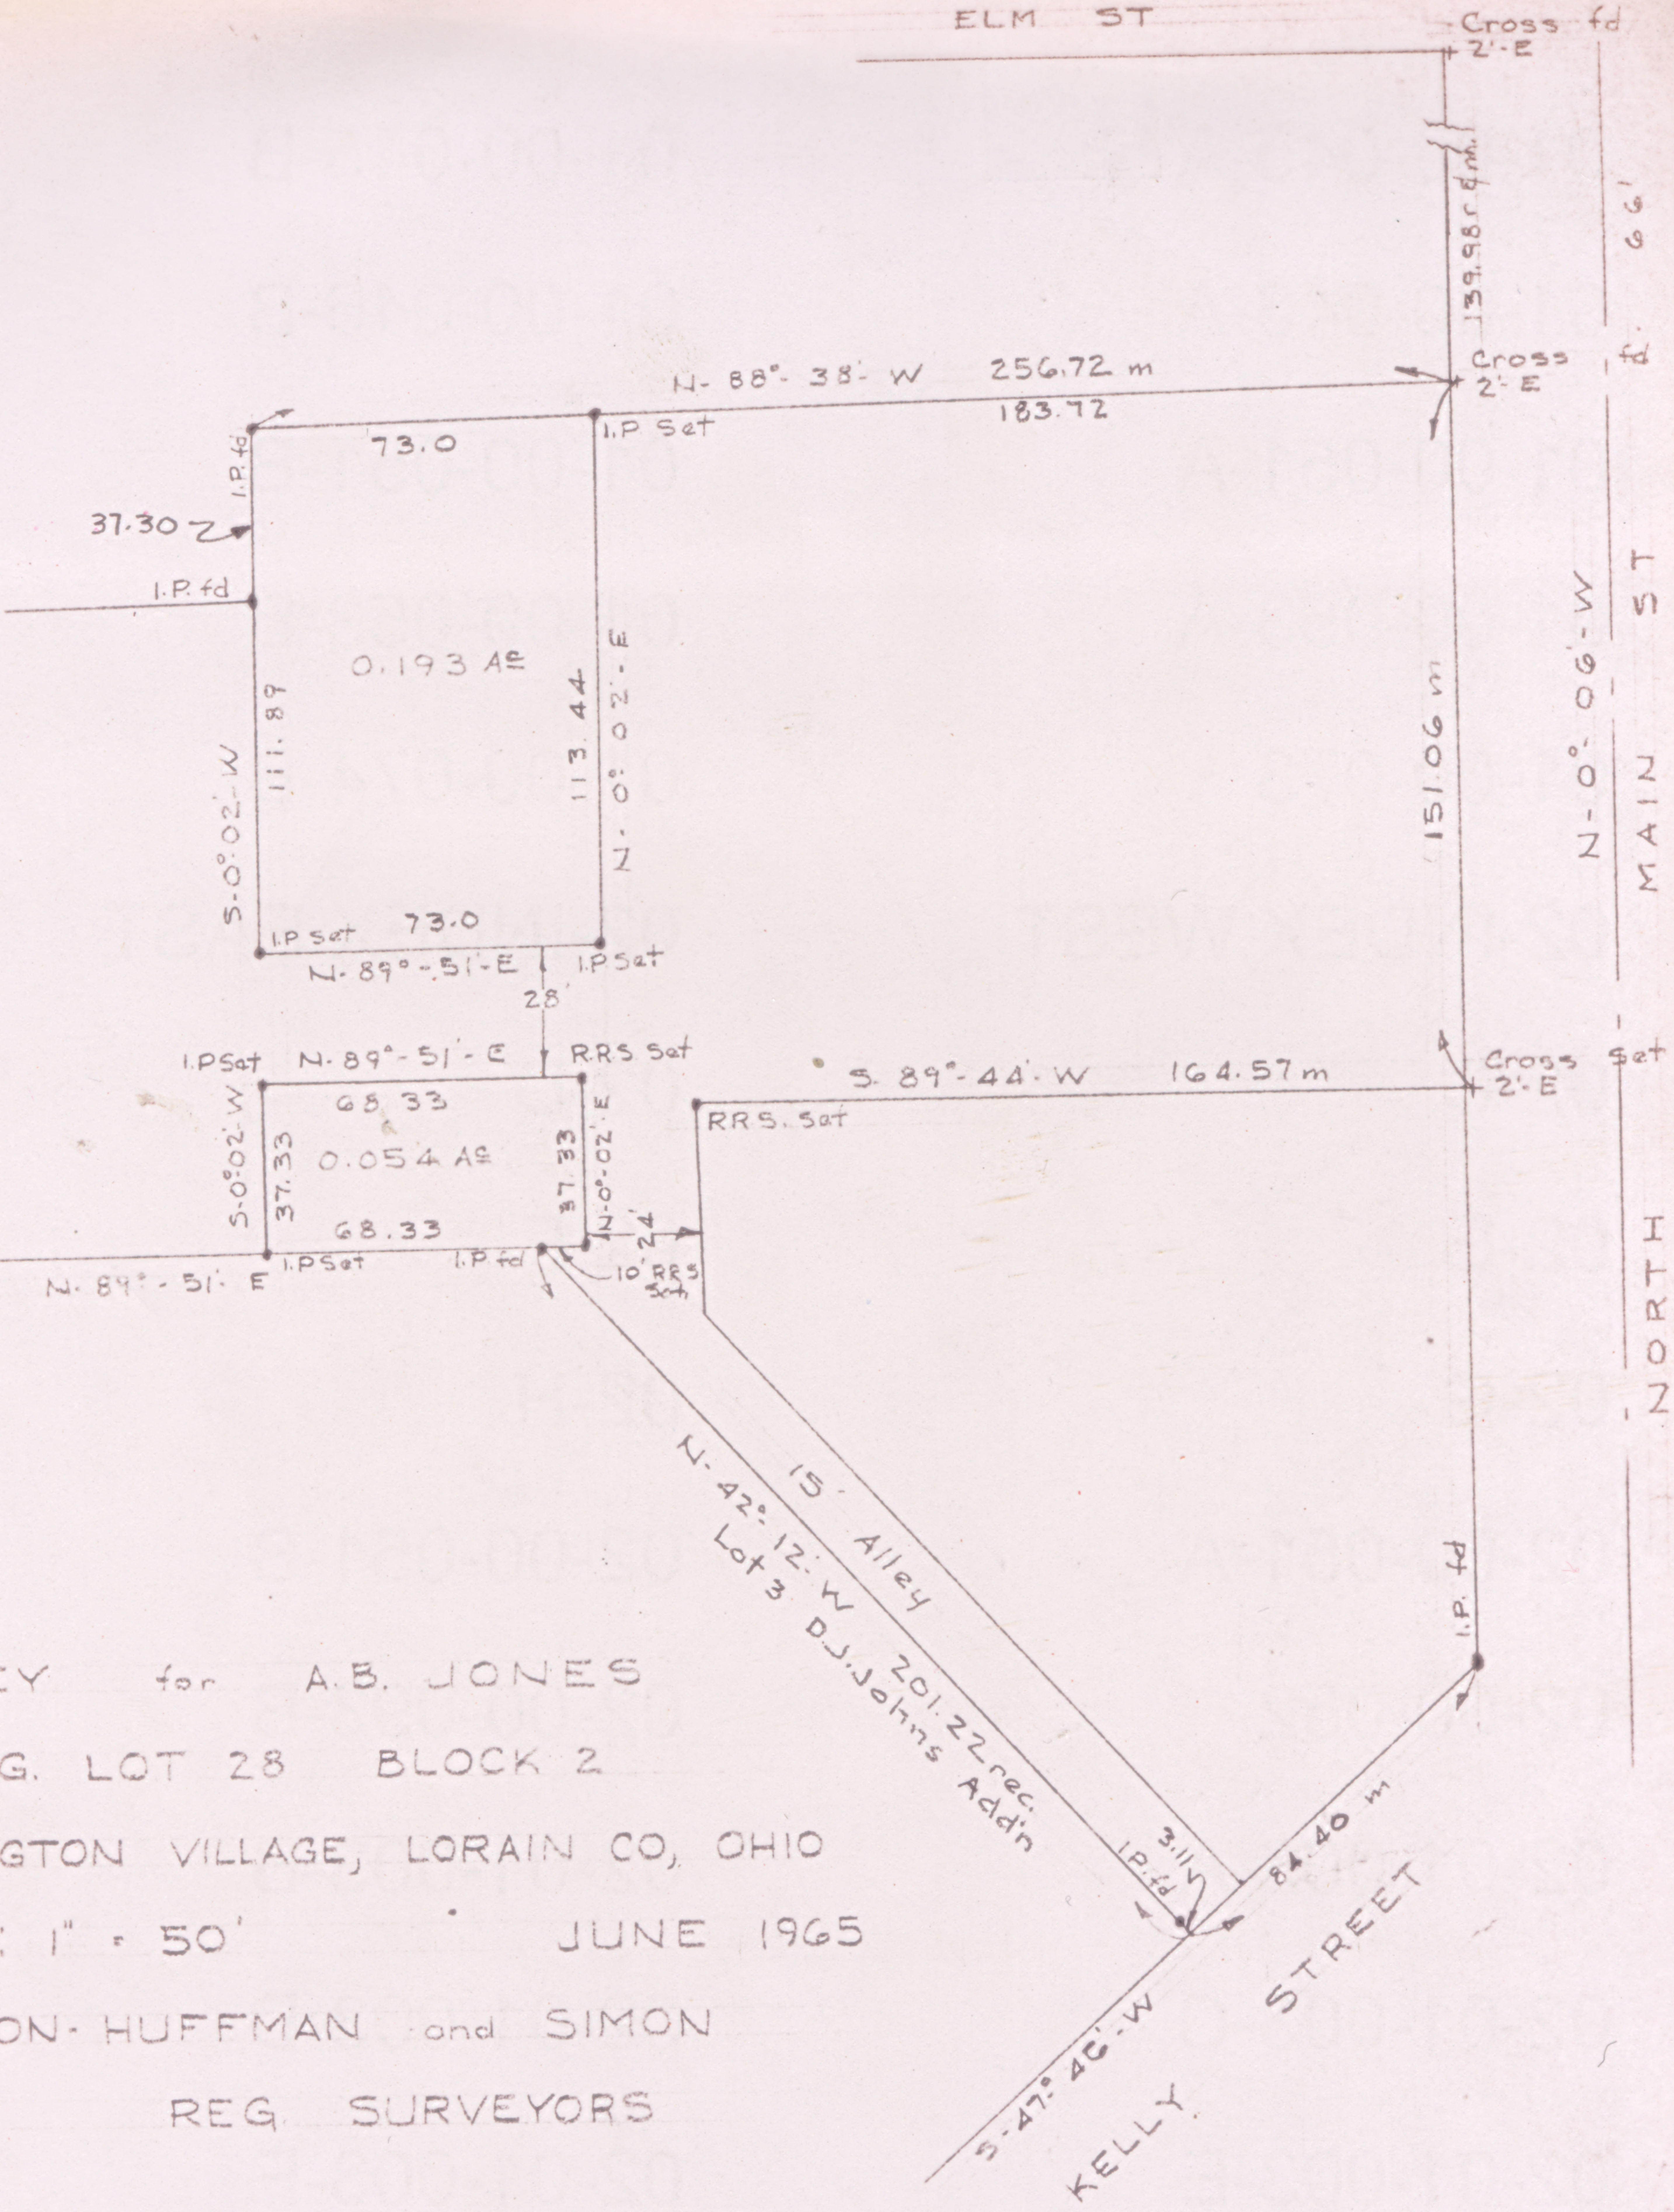


18-00-028-108
 18-00-028-D
 SCAN # 44920

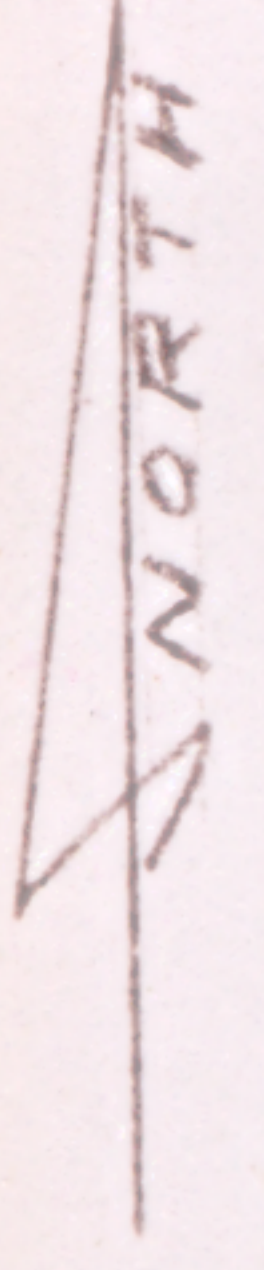

SURVEY for A.B. JONES
 Pt. ORIG. LOT 28 BLOCK 2
 WELLINGTON VILLAGE, LORAIN CO, OHIO
 SCALE: 1" = 50' JUNE 1965
 LAUNDON-HUFFMAN and SIMON
 REG. SURVEYORS