



18-00-028-D
SCAN # 46921

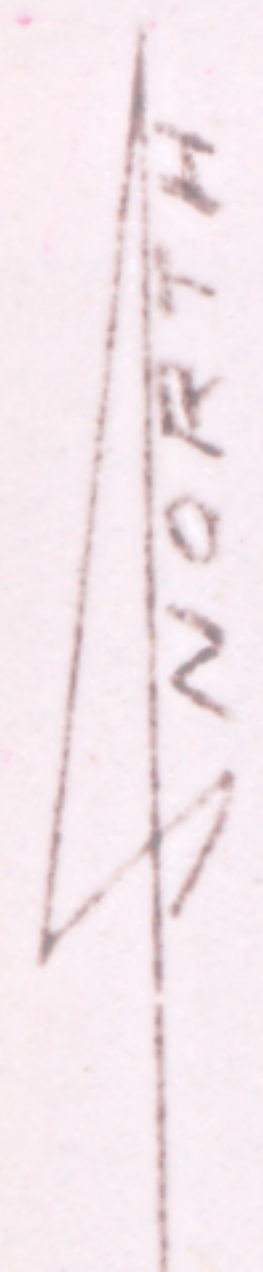

201-22-REC-201

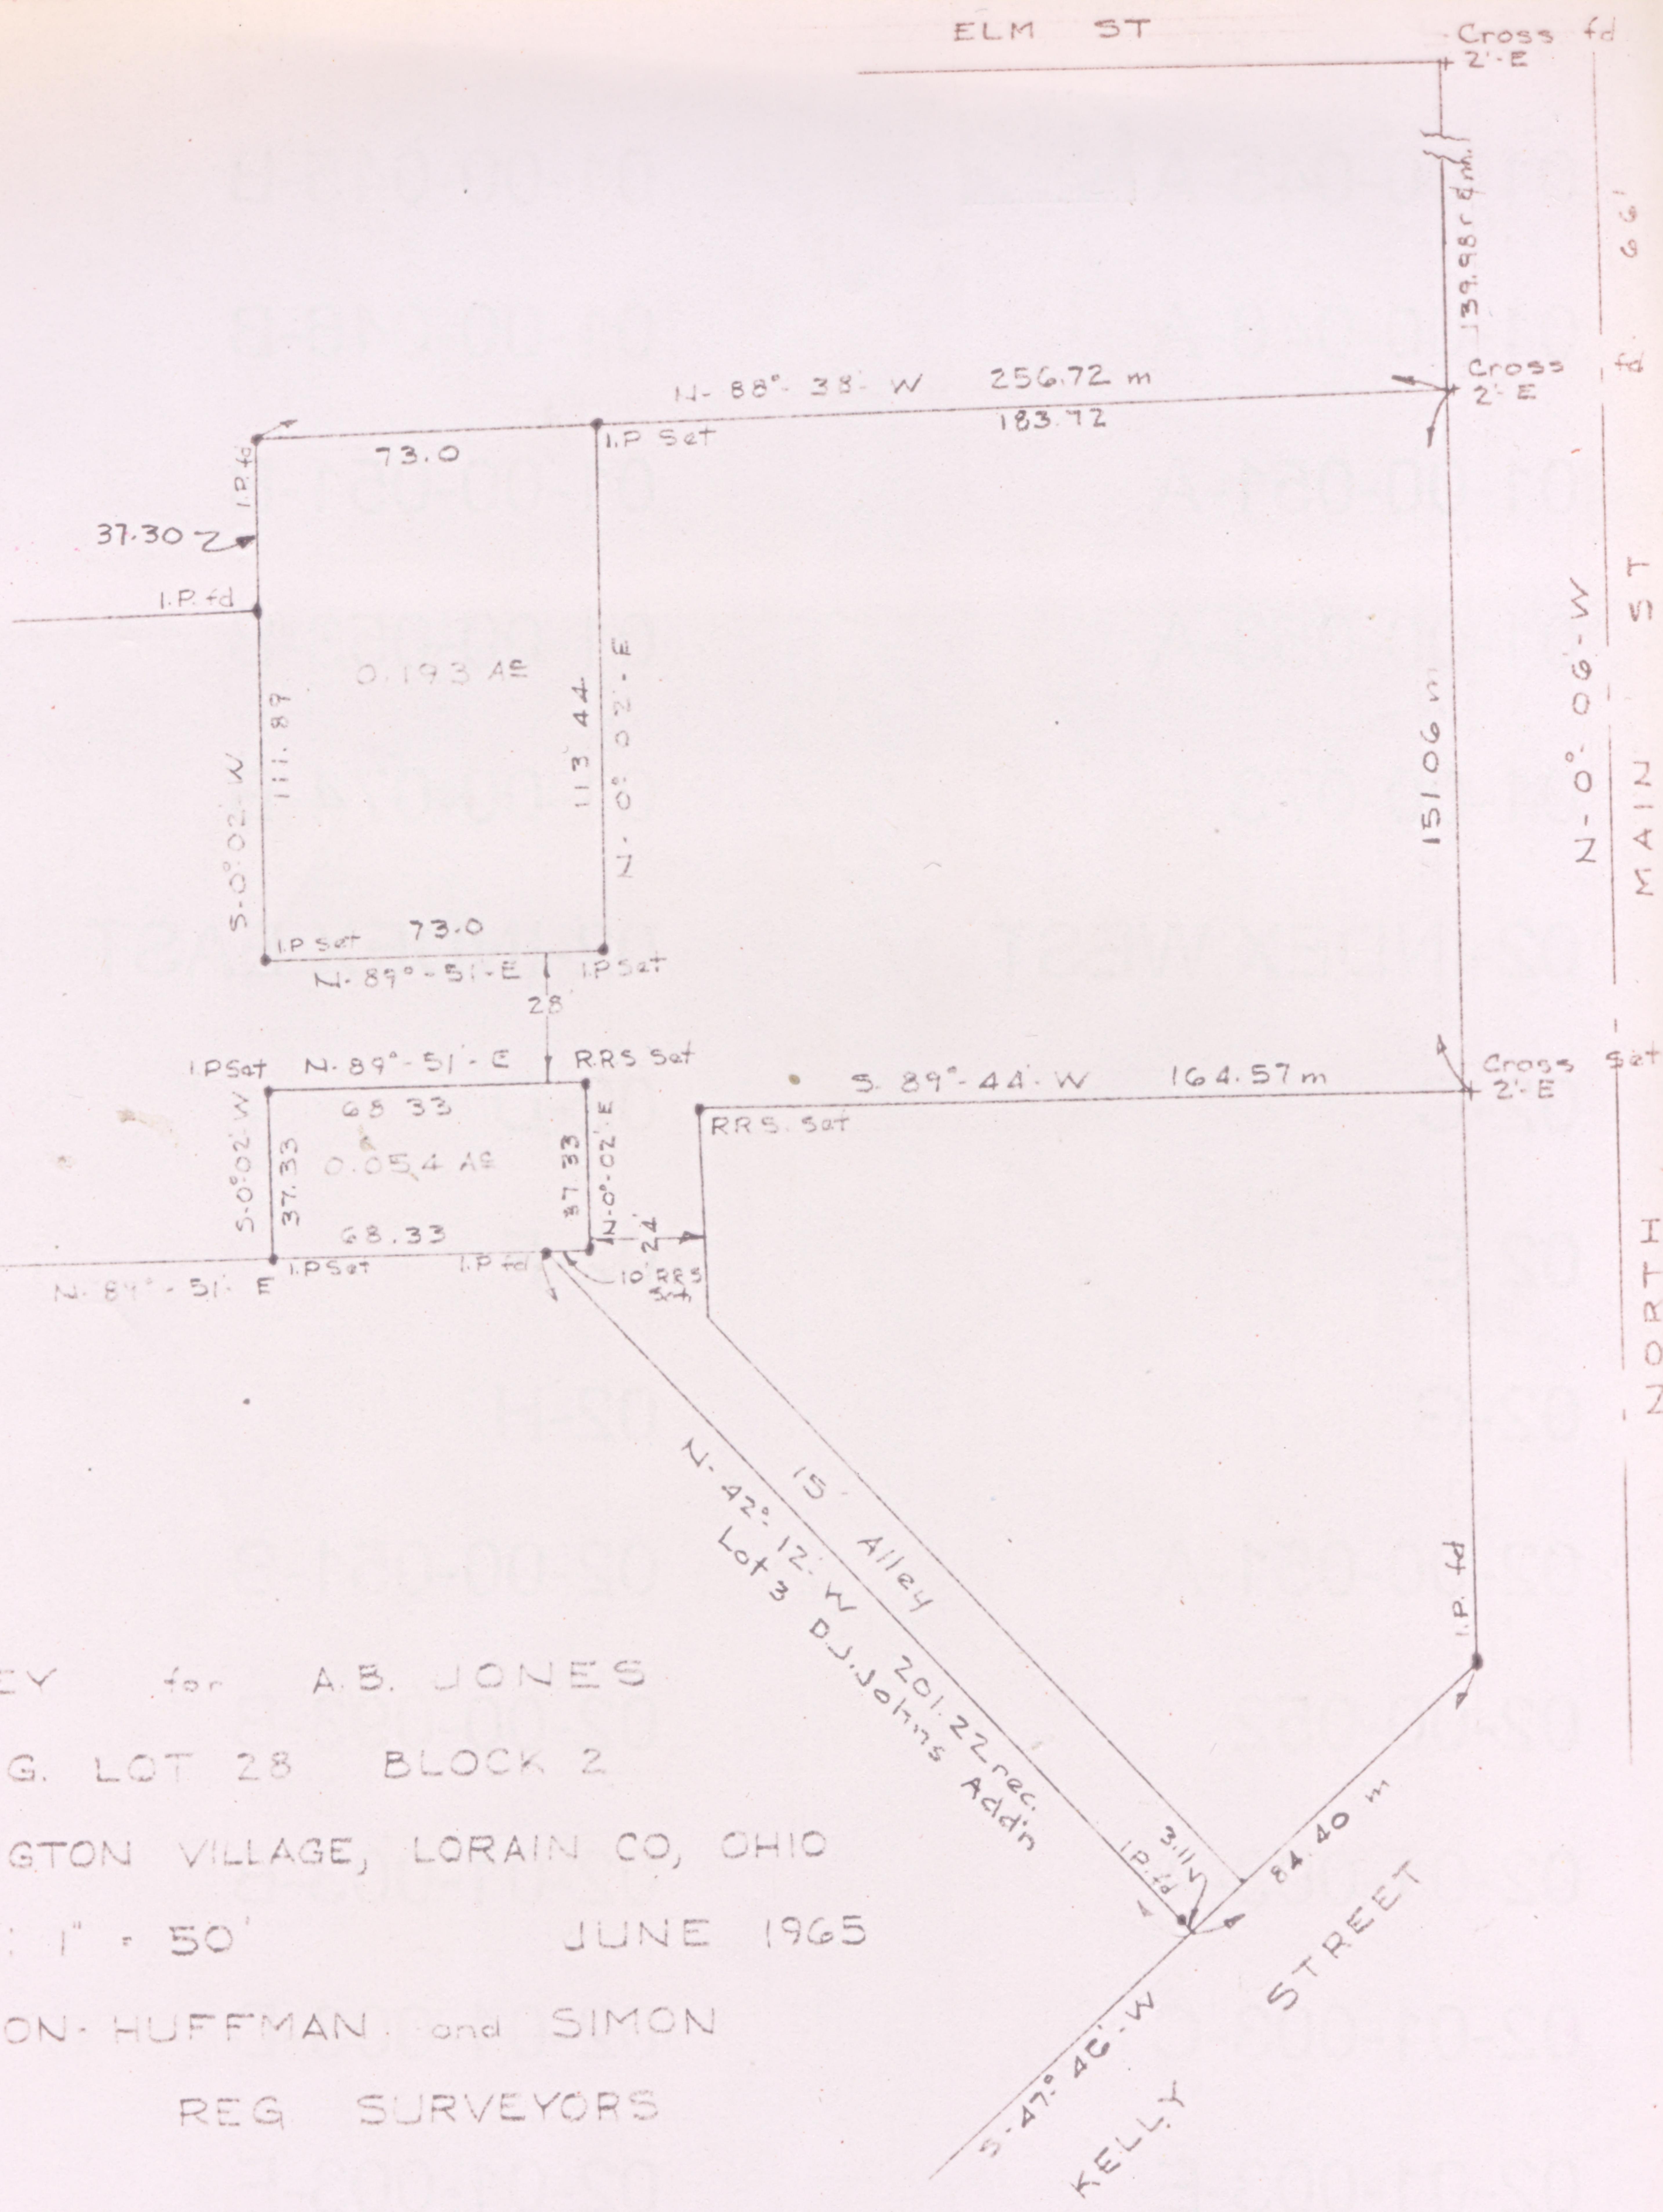

SURVEY for A.B. JONES
 Pt. ORIG. LOT 28 BLOCK 2
 WELLINGTON VILLAGE, LORAIN CO, OHIO
 SCALE: 1" = 50' JUNE 1965
 LAUNDON HUFFMAN and SIMON
 REG. SURVEYORS