

18-00-028-112-025
18-00-028-112-026
18-00-028-0

State of Ohio
Registered Professional
Surveyor

Home Phone 30282
Office

THOMAS W. LAUNDON

CIVIL ENGINEER AND SURVEYOR

405 Elyria Building

ELYRIA OHIO

R.D. 2


Municipal Engineering
Surveys - City of
Sub-division

SCAN # 46929

EMCO Onion Skin

ESCHECK MFG. CO.

MADE IN U.S.A.

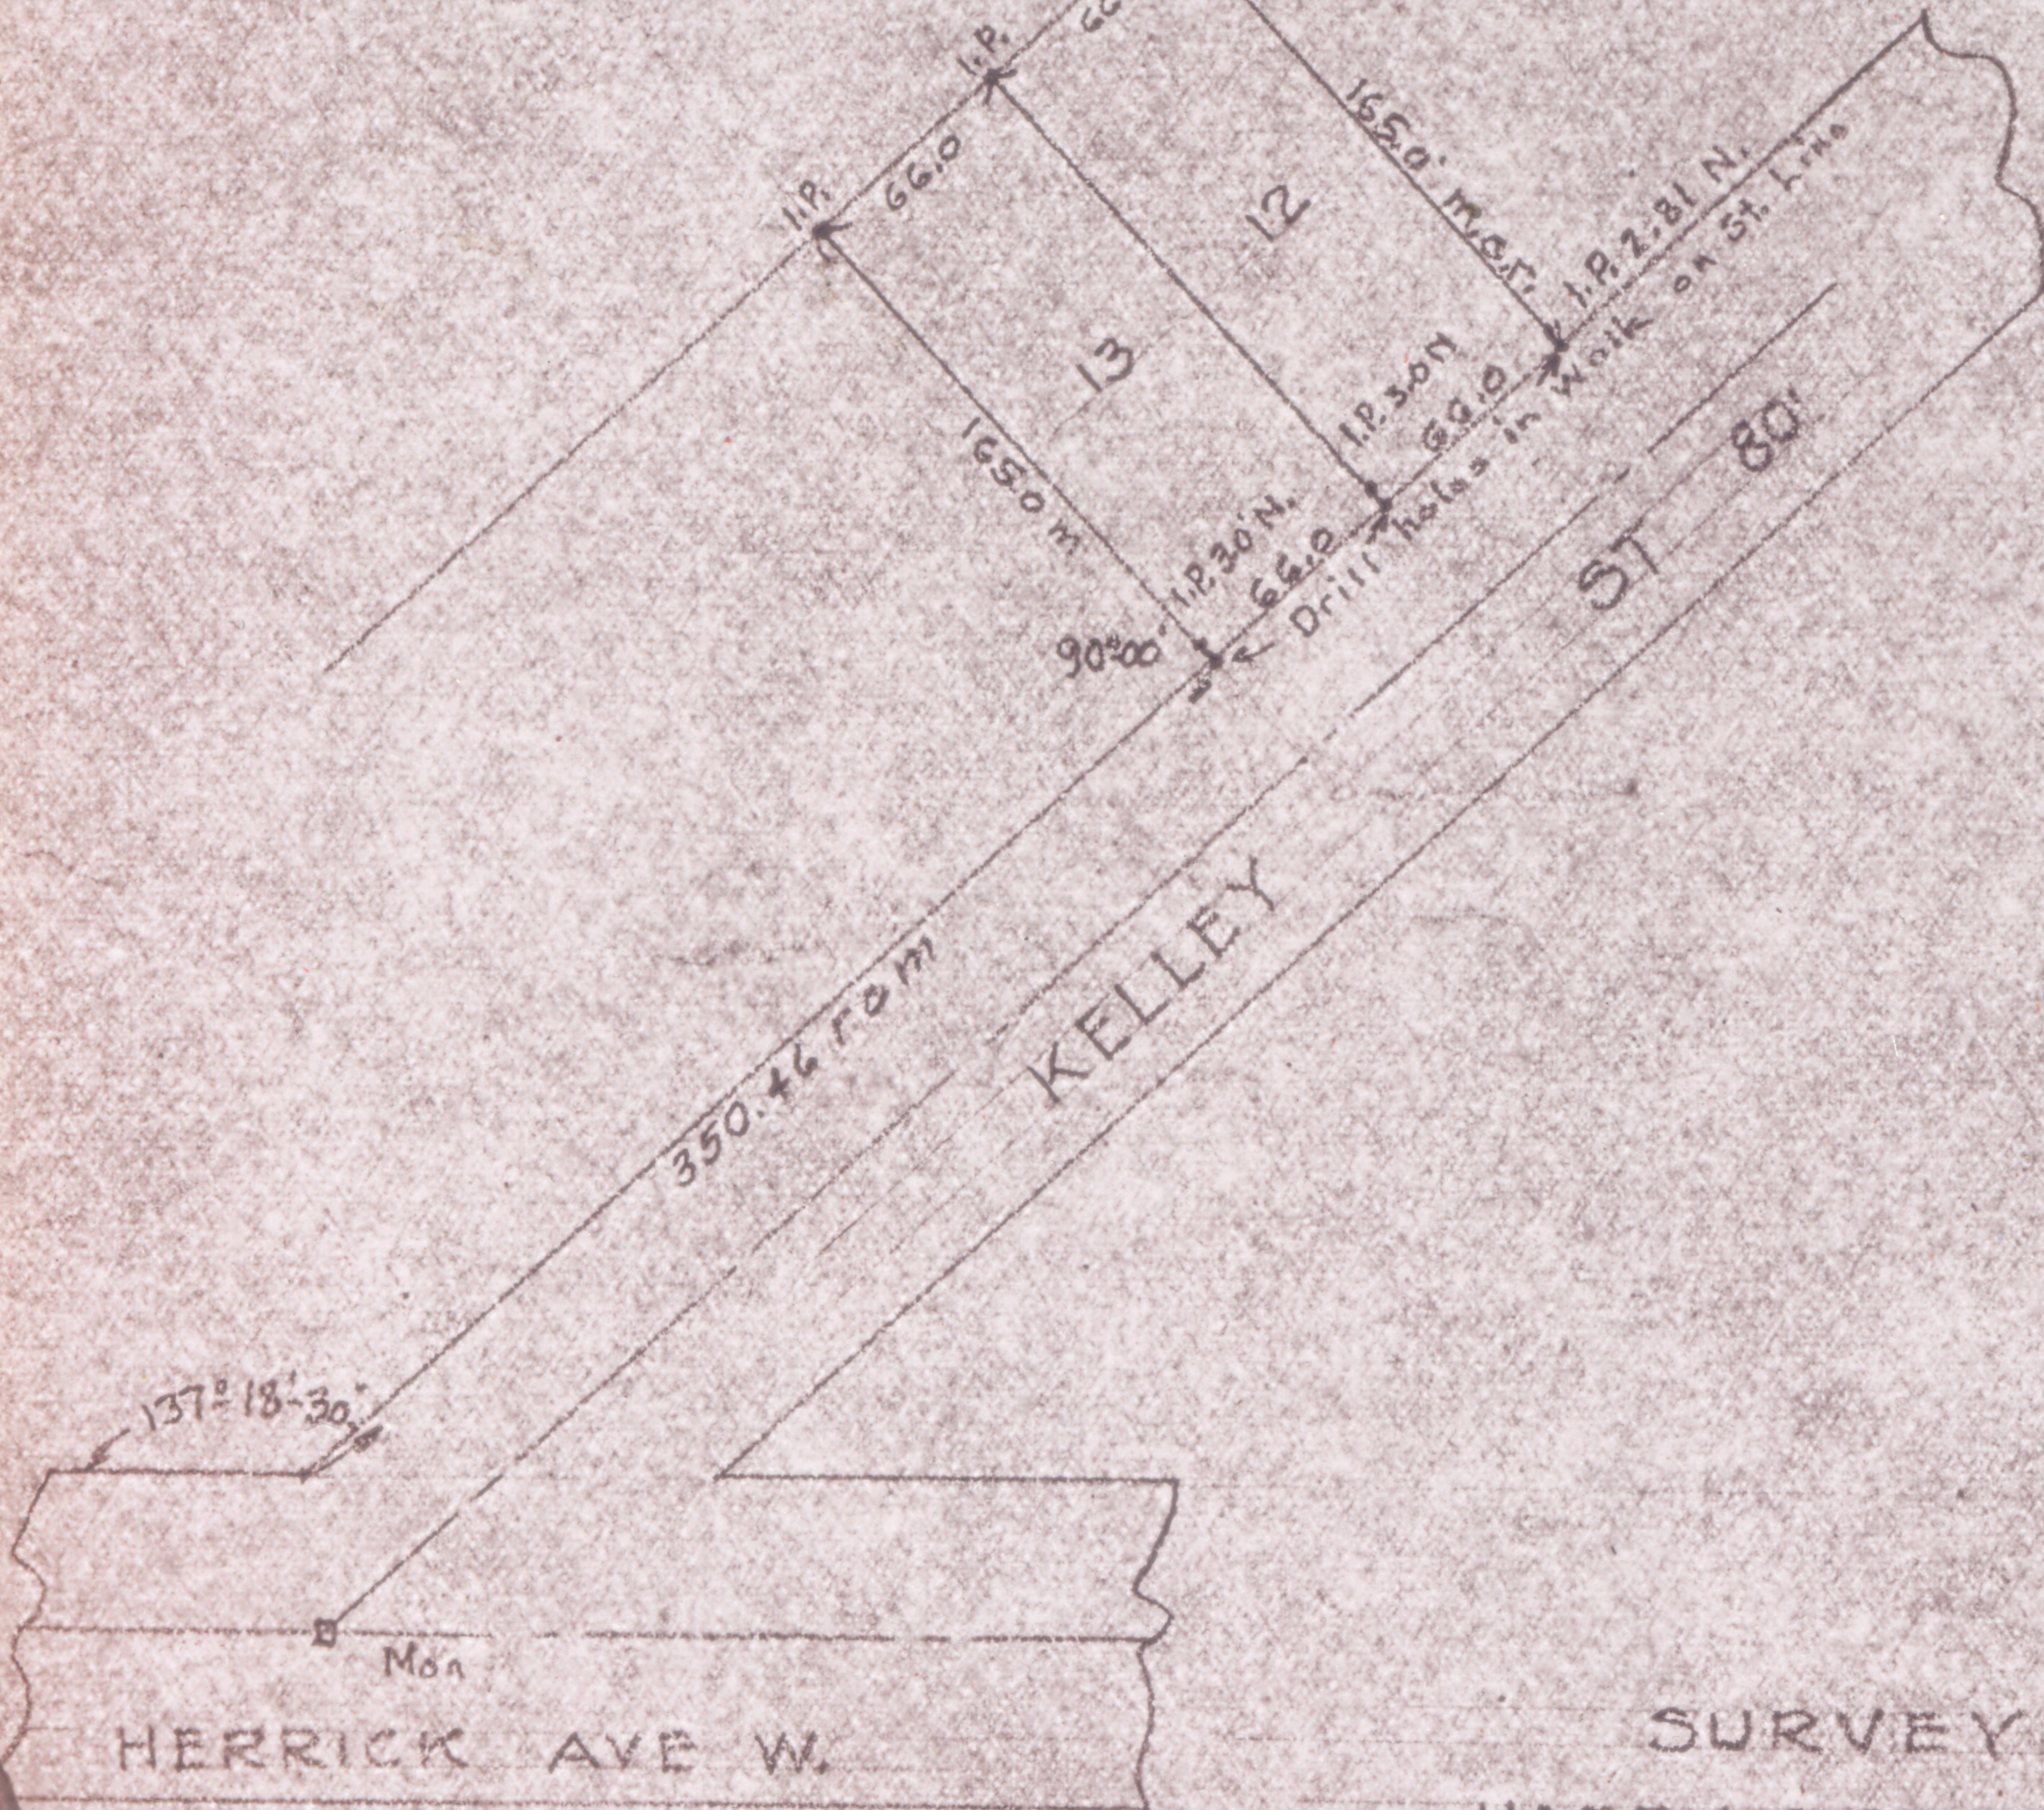

SURVEY FOR
HARRY C. OTTERBACHER

LOTS 12 & 13

WELLINGTON VILLAGE, LORAIN CO. OHIO

T.W. LAUNDON REGISTERED SURVEYOR