



LAUNDON • SIMON • CAHL and ASSOC.  
ENGINEERS  
504 MIDDLE AVE.

SURVEYORS  
ELYRIA, OHIO 4035

FOR: ATTY. HARRISON L. COMSTOCK and LORAIN CO. SAV. & TR. CO. TRUSTEE

TOWNSHIP WELLINGTON  
ORIG. LOT or SEC. 33  
CITY


VILLAGE  
COUNTY LORAIN  
STATE OHIO

DATE APRIL 23, 1981  
SCALE 1" = 100'  
JOB NO. 81-1049 F.B. 156/49

18-B

18-00-033-000  
SCAN # 46927

PITTS RD.

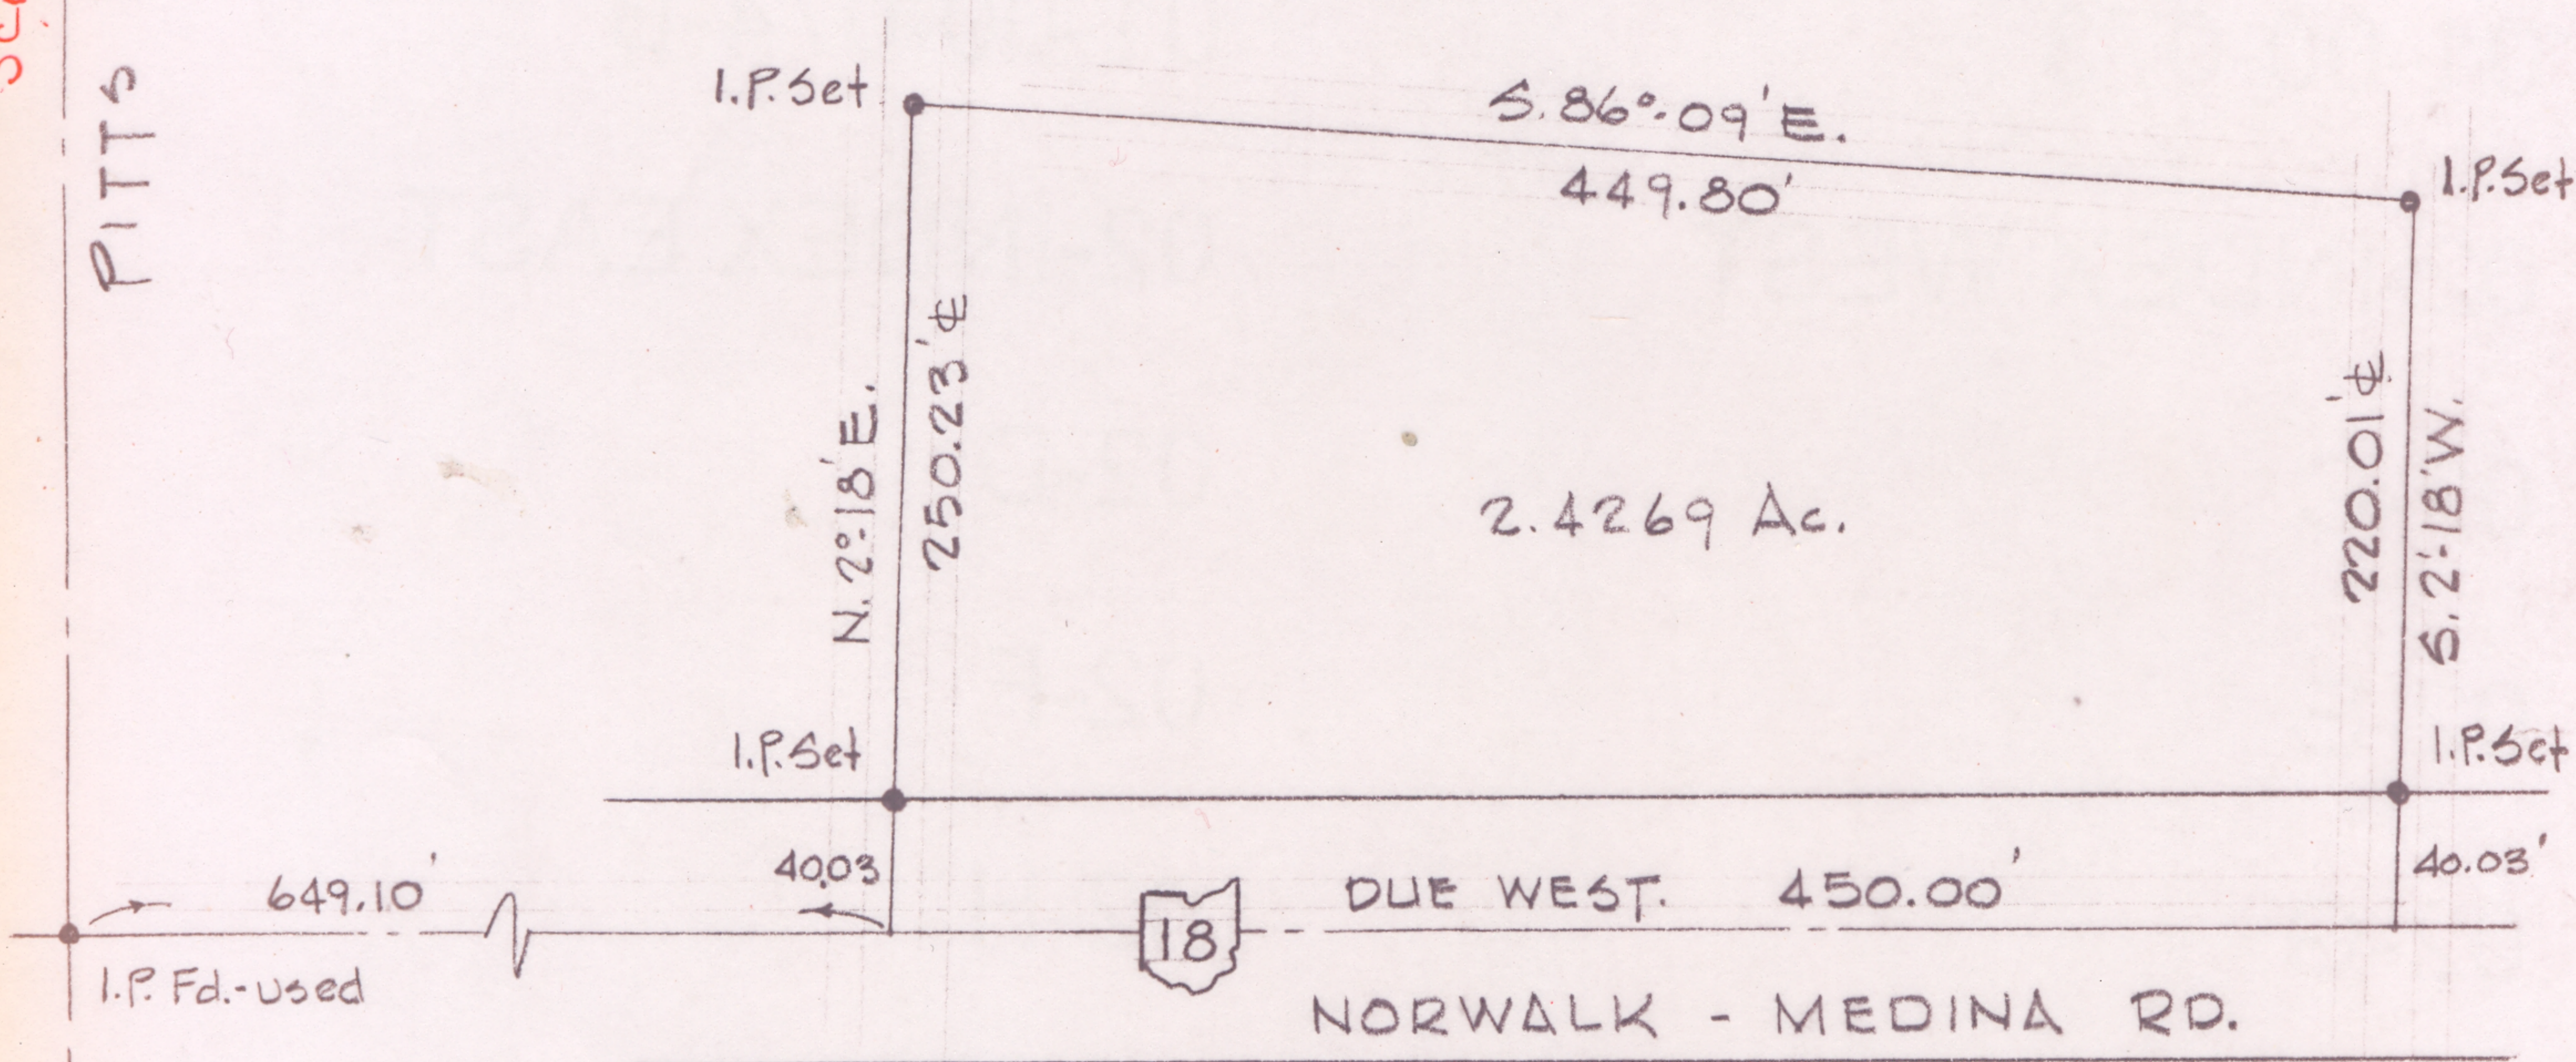

BEARINGS SHOWN ARE ASSUMED AND  
USED FOR DESCRIPTIVE PURPOSES ONLY.