


20-04-012-000-011

20-G

Scan # 46935

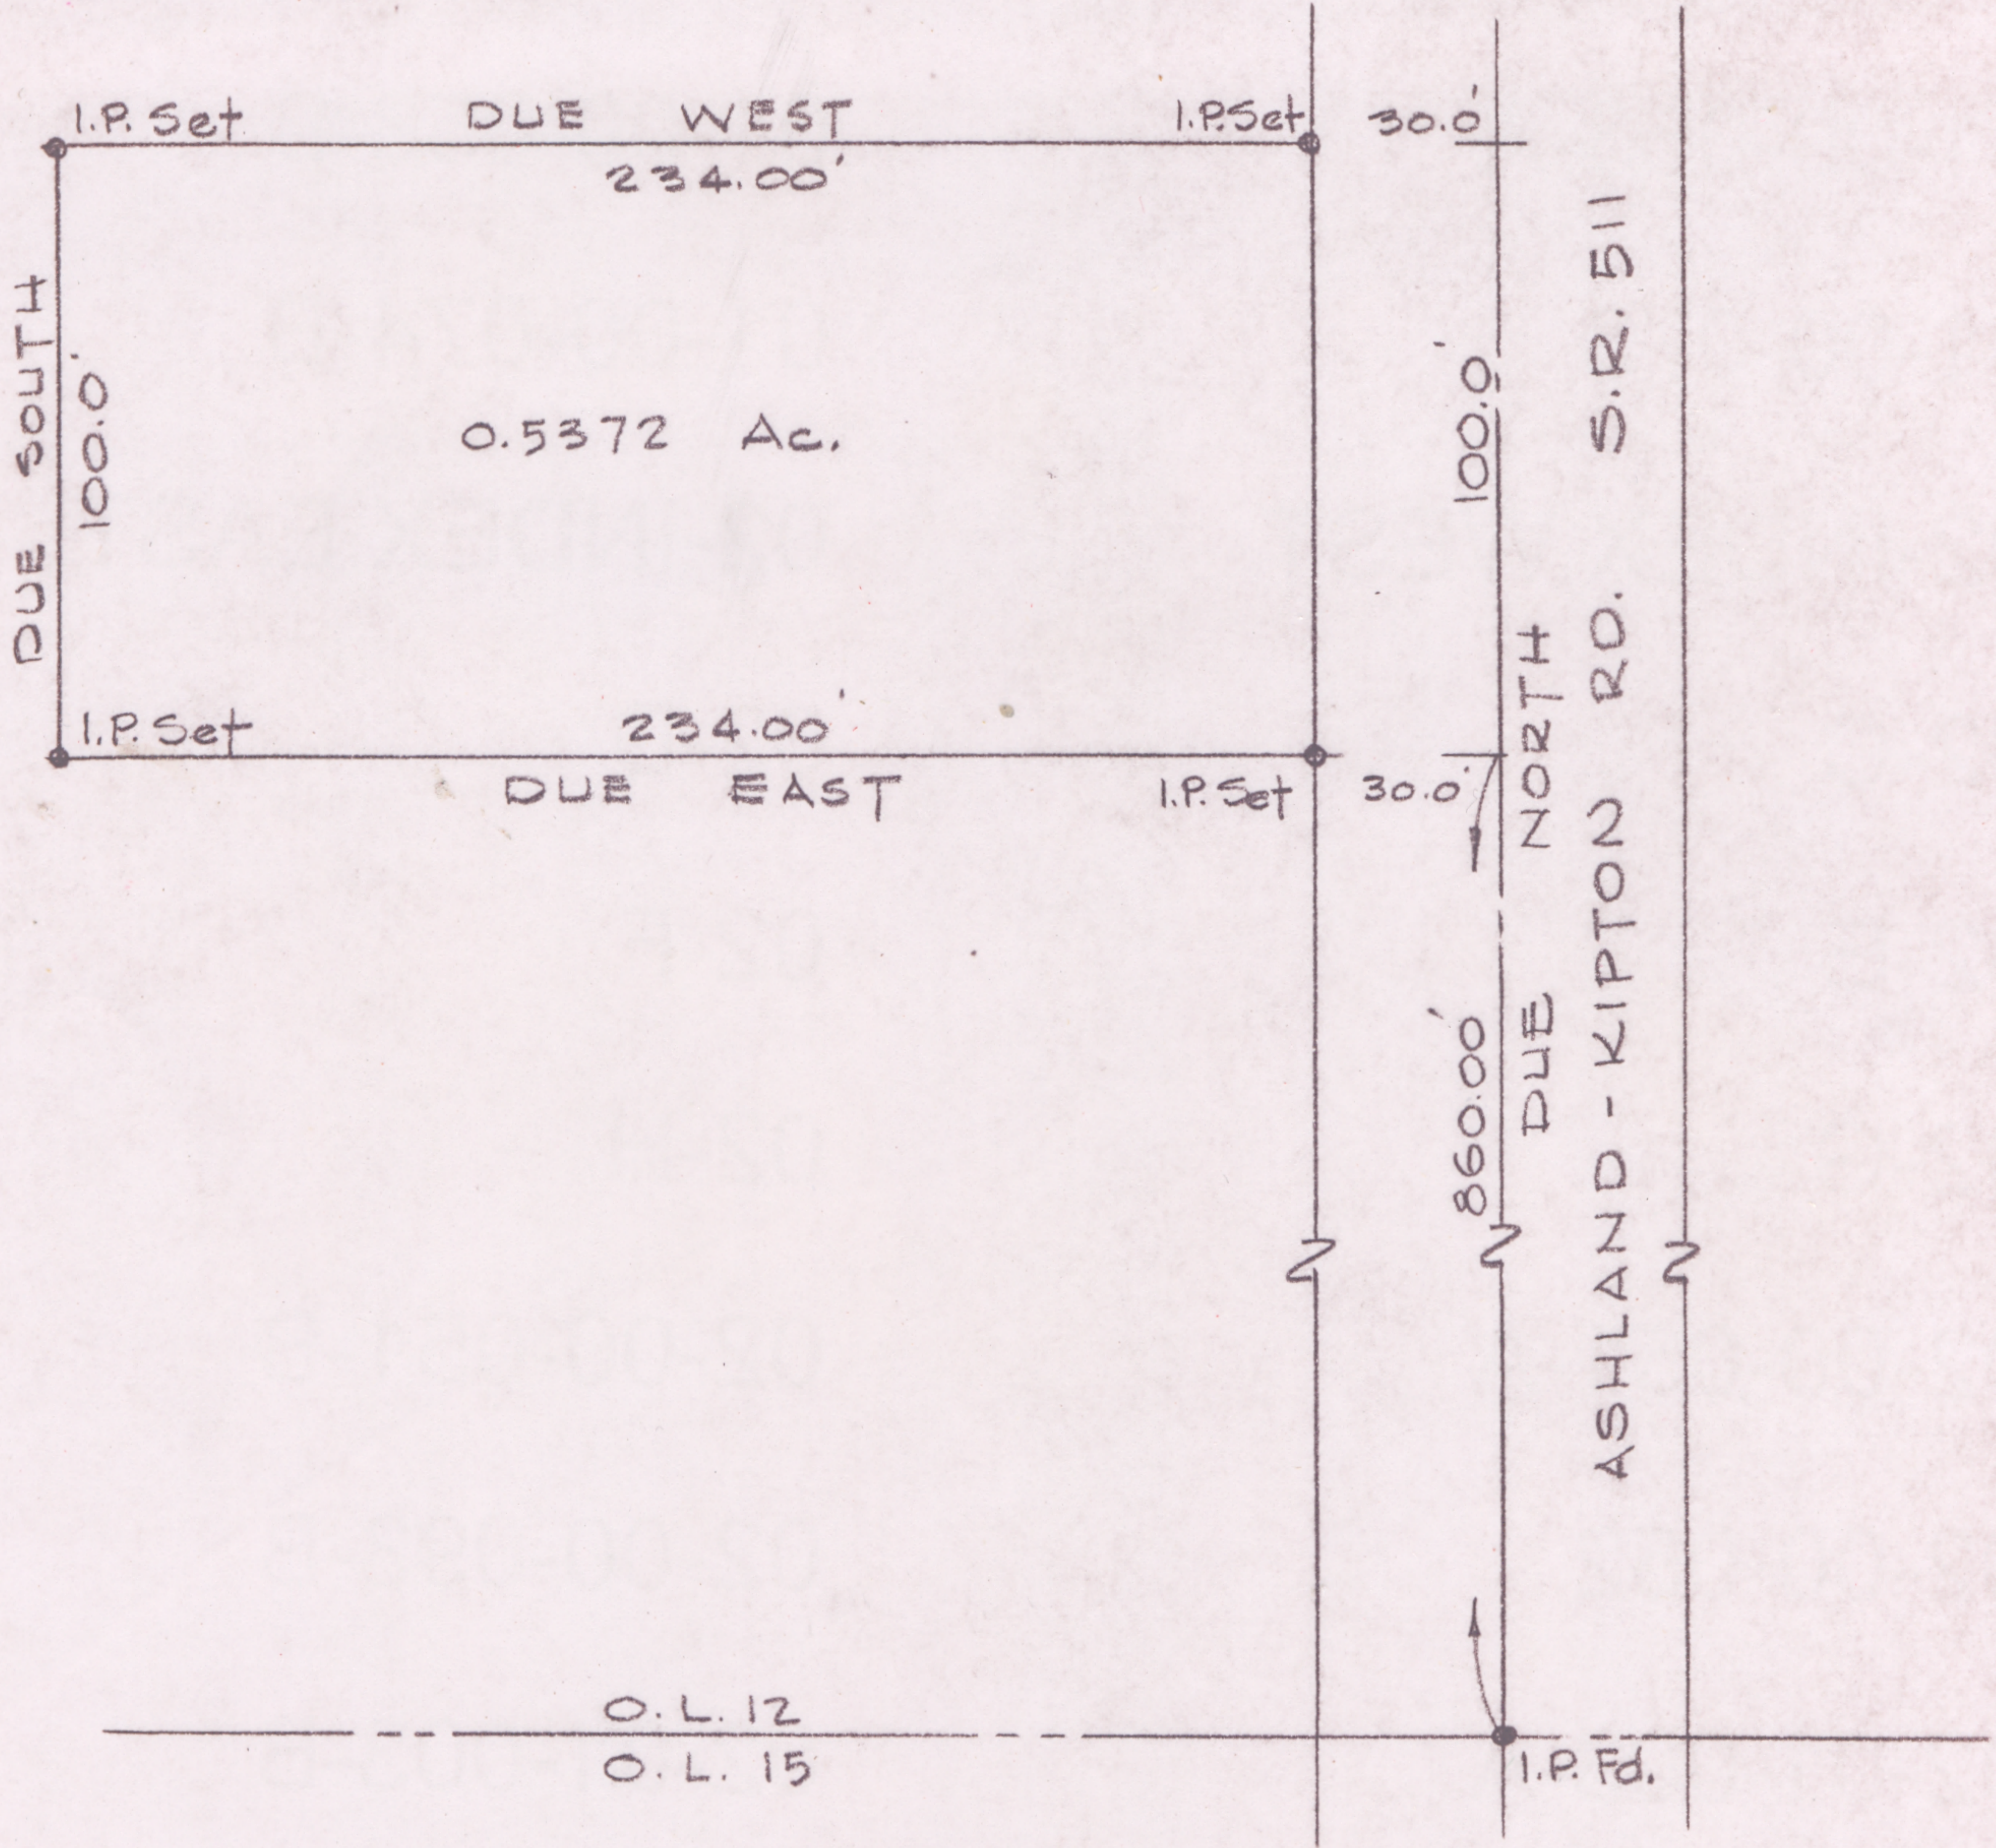

SURVEY FOR FRANK AND BERTHA ROERIG

O.L. 12 TRACT 4 ROCHESTER TWP.
 LORAIN COUNTY OHIO
 SCALE 1"=100' JULY, 1974
 LAUNDON • SIMON • CAHL & ASSOC.
 ENGINEERS & SURVEYORS