


21-02-006-000-002

21-F

Scan # 46940

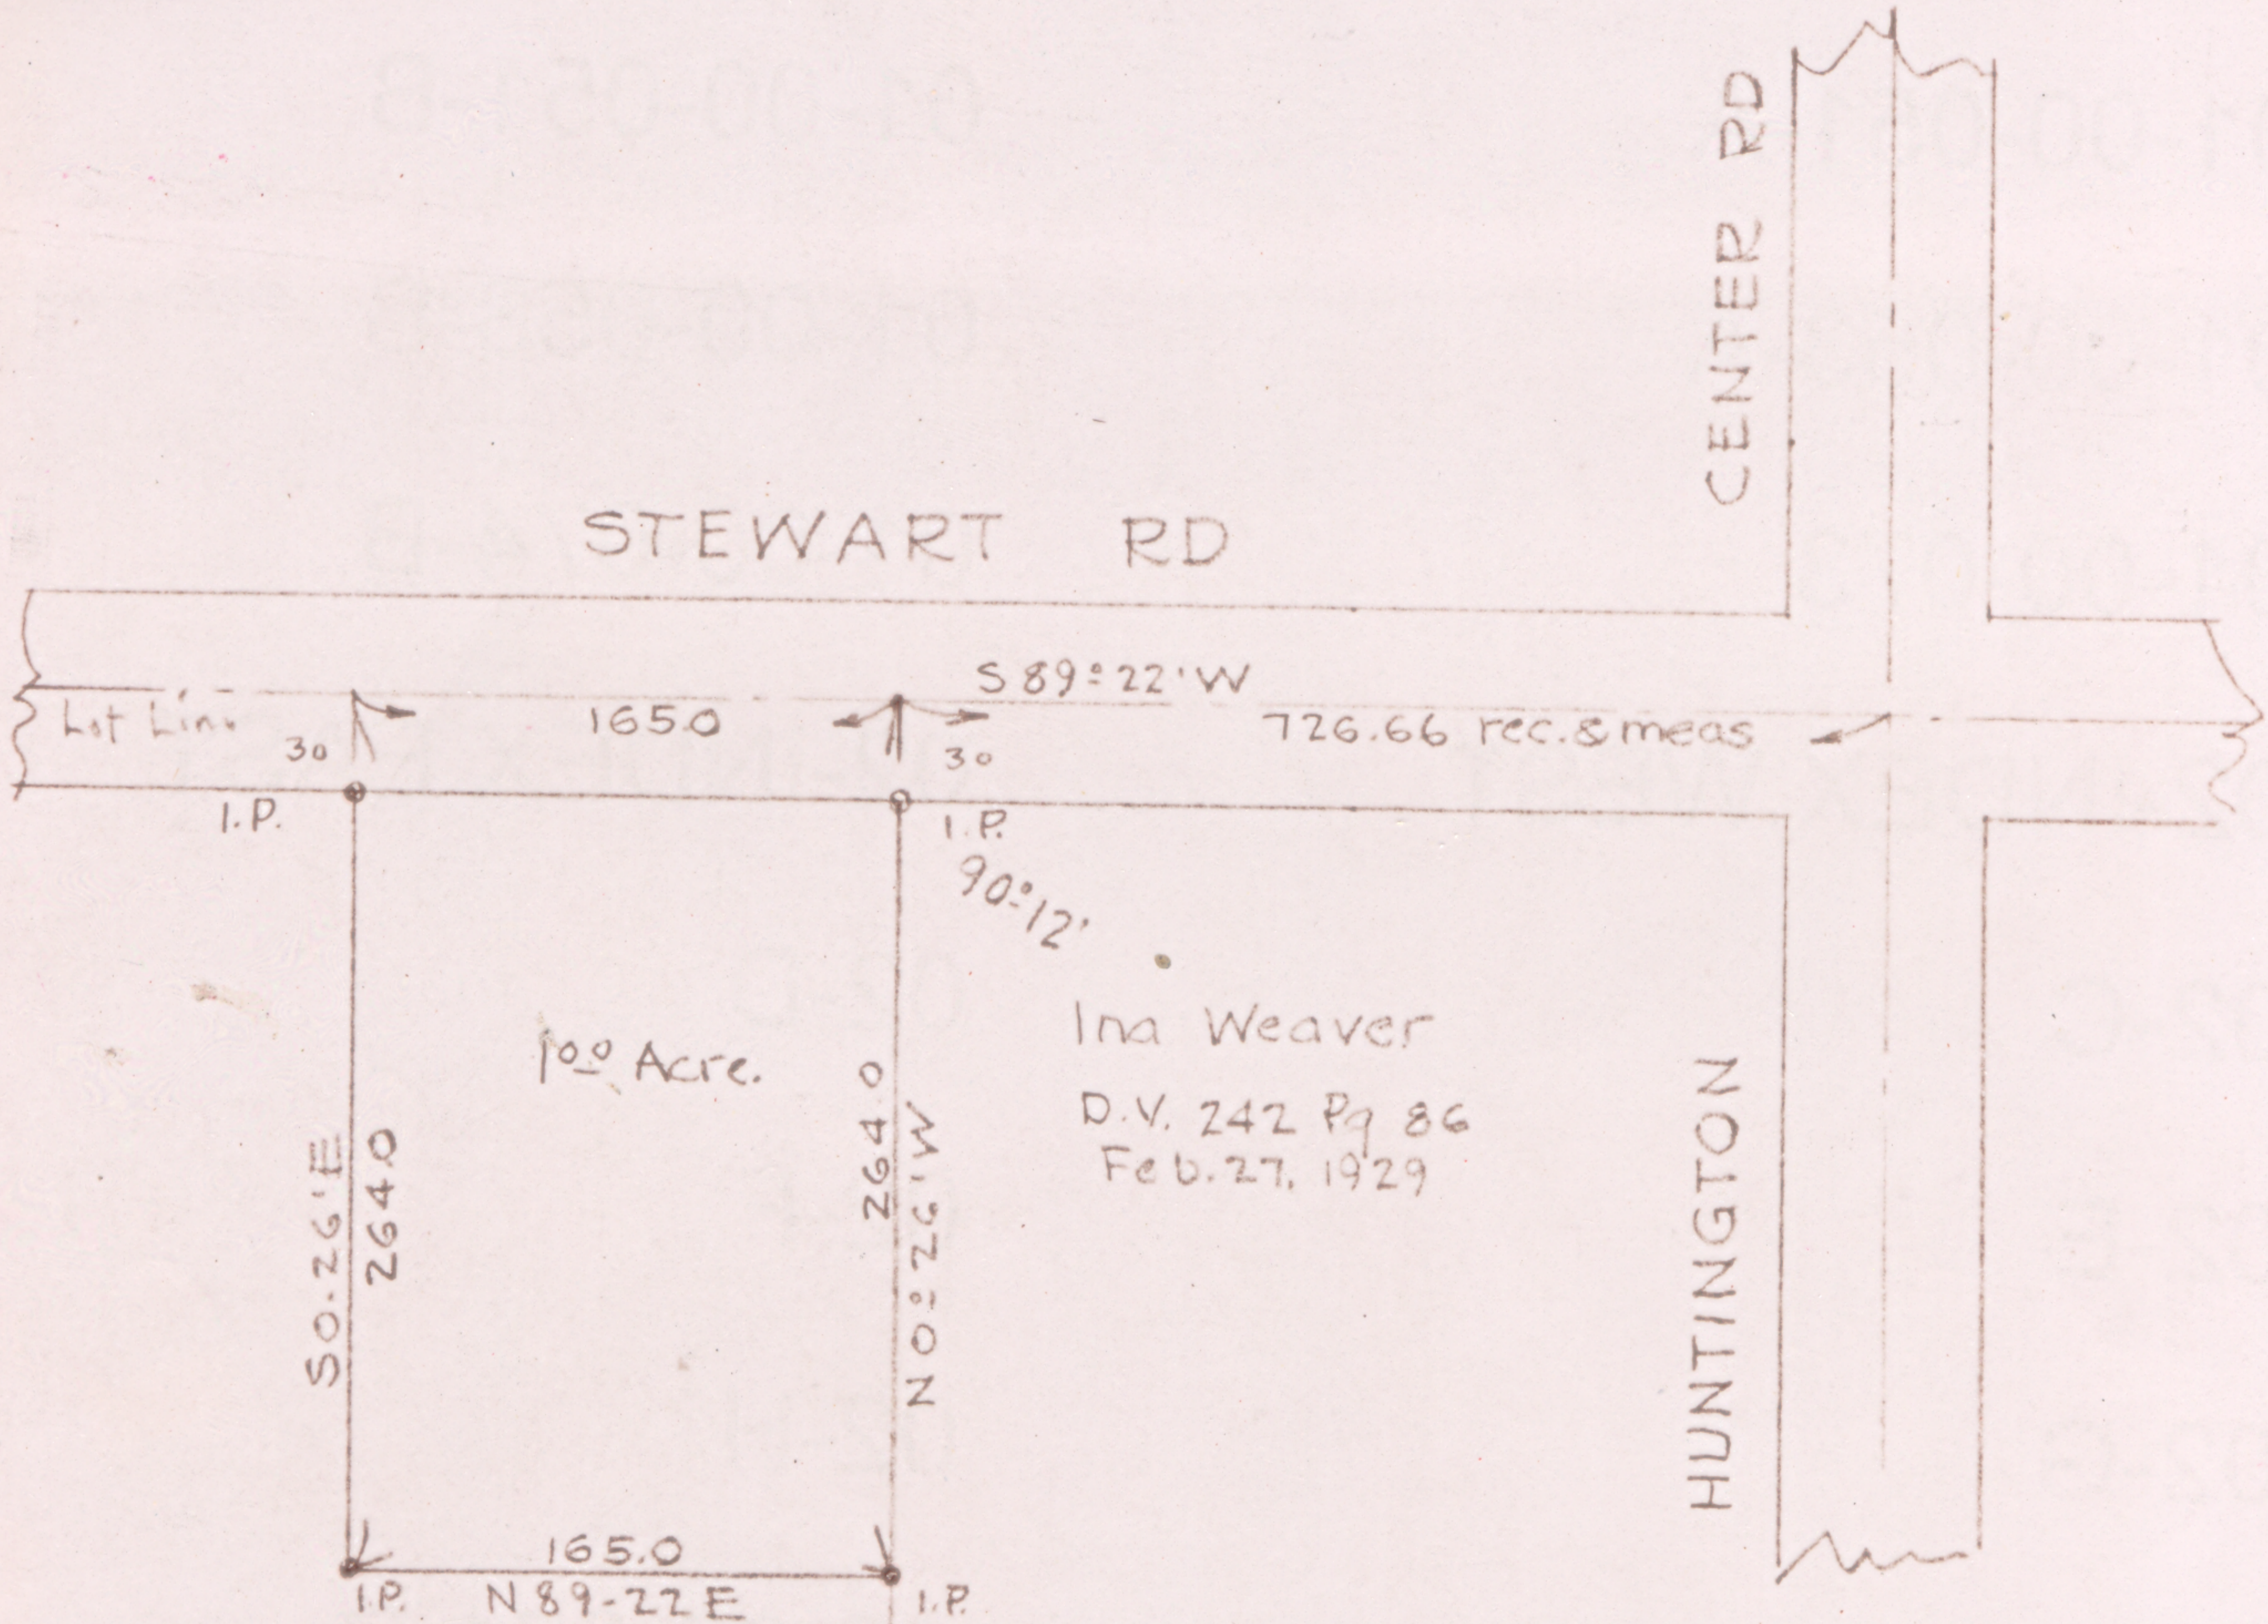

Glenn & Treva Rollin
 D.V. 305 Pg. 33
 Feby. 14, 1940

SURVEY FOR OLIVER BIGELOW
 PART OF LOT 6 TR 2 HUNTINGTON
 TWP. LORAIN CO. OHIO.
 SCALE 1"=100 SEPT. 5. 53
 T.W. LAUNDON REG. SURVEYOR

