


21-02-019-000-017
21-E
SCAN # 46943

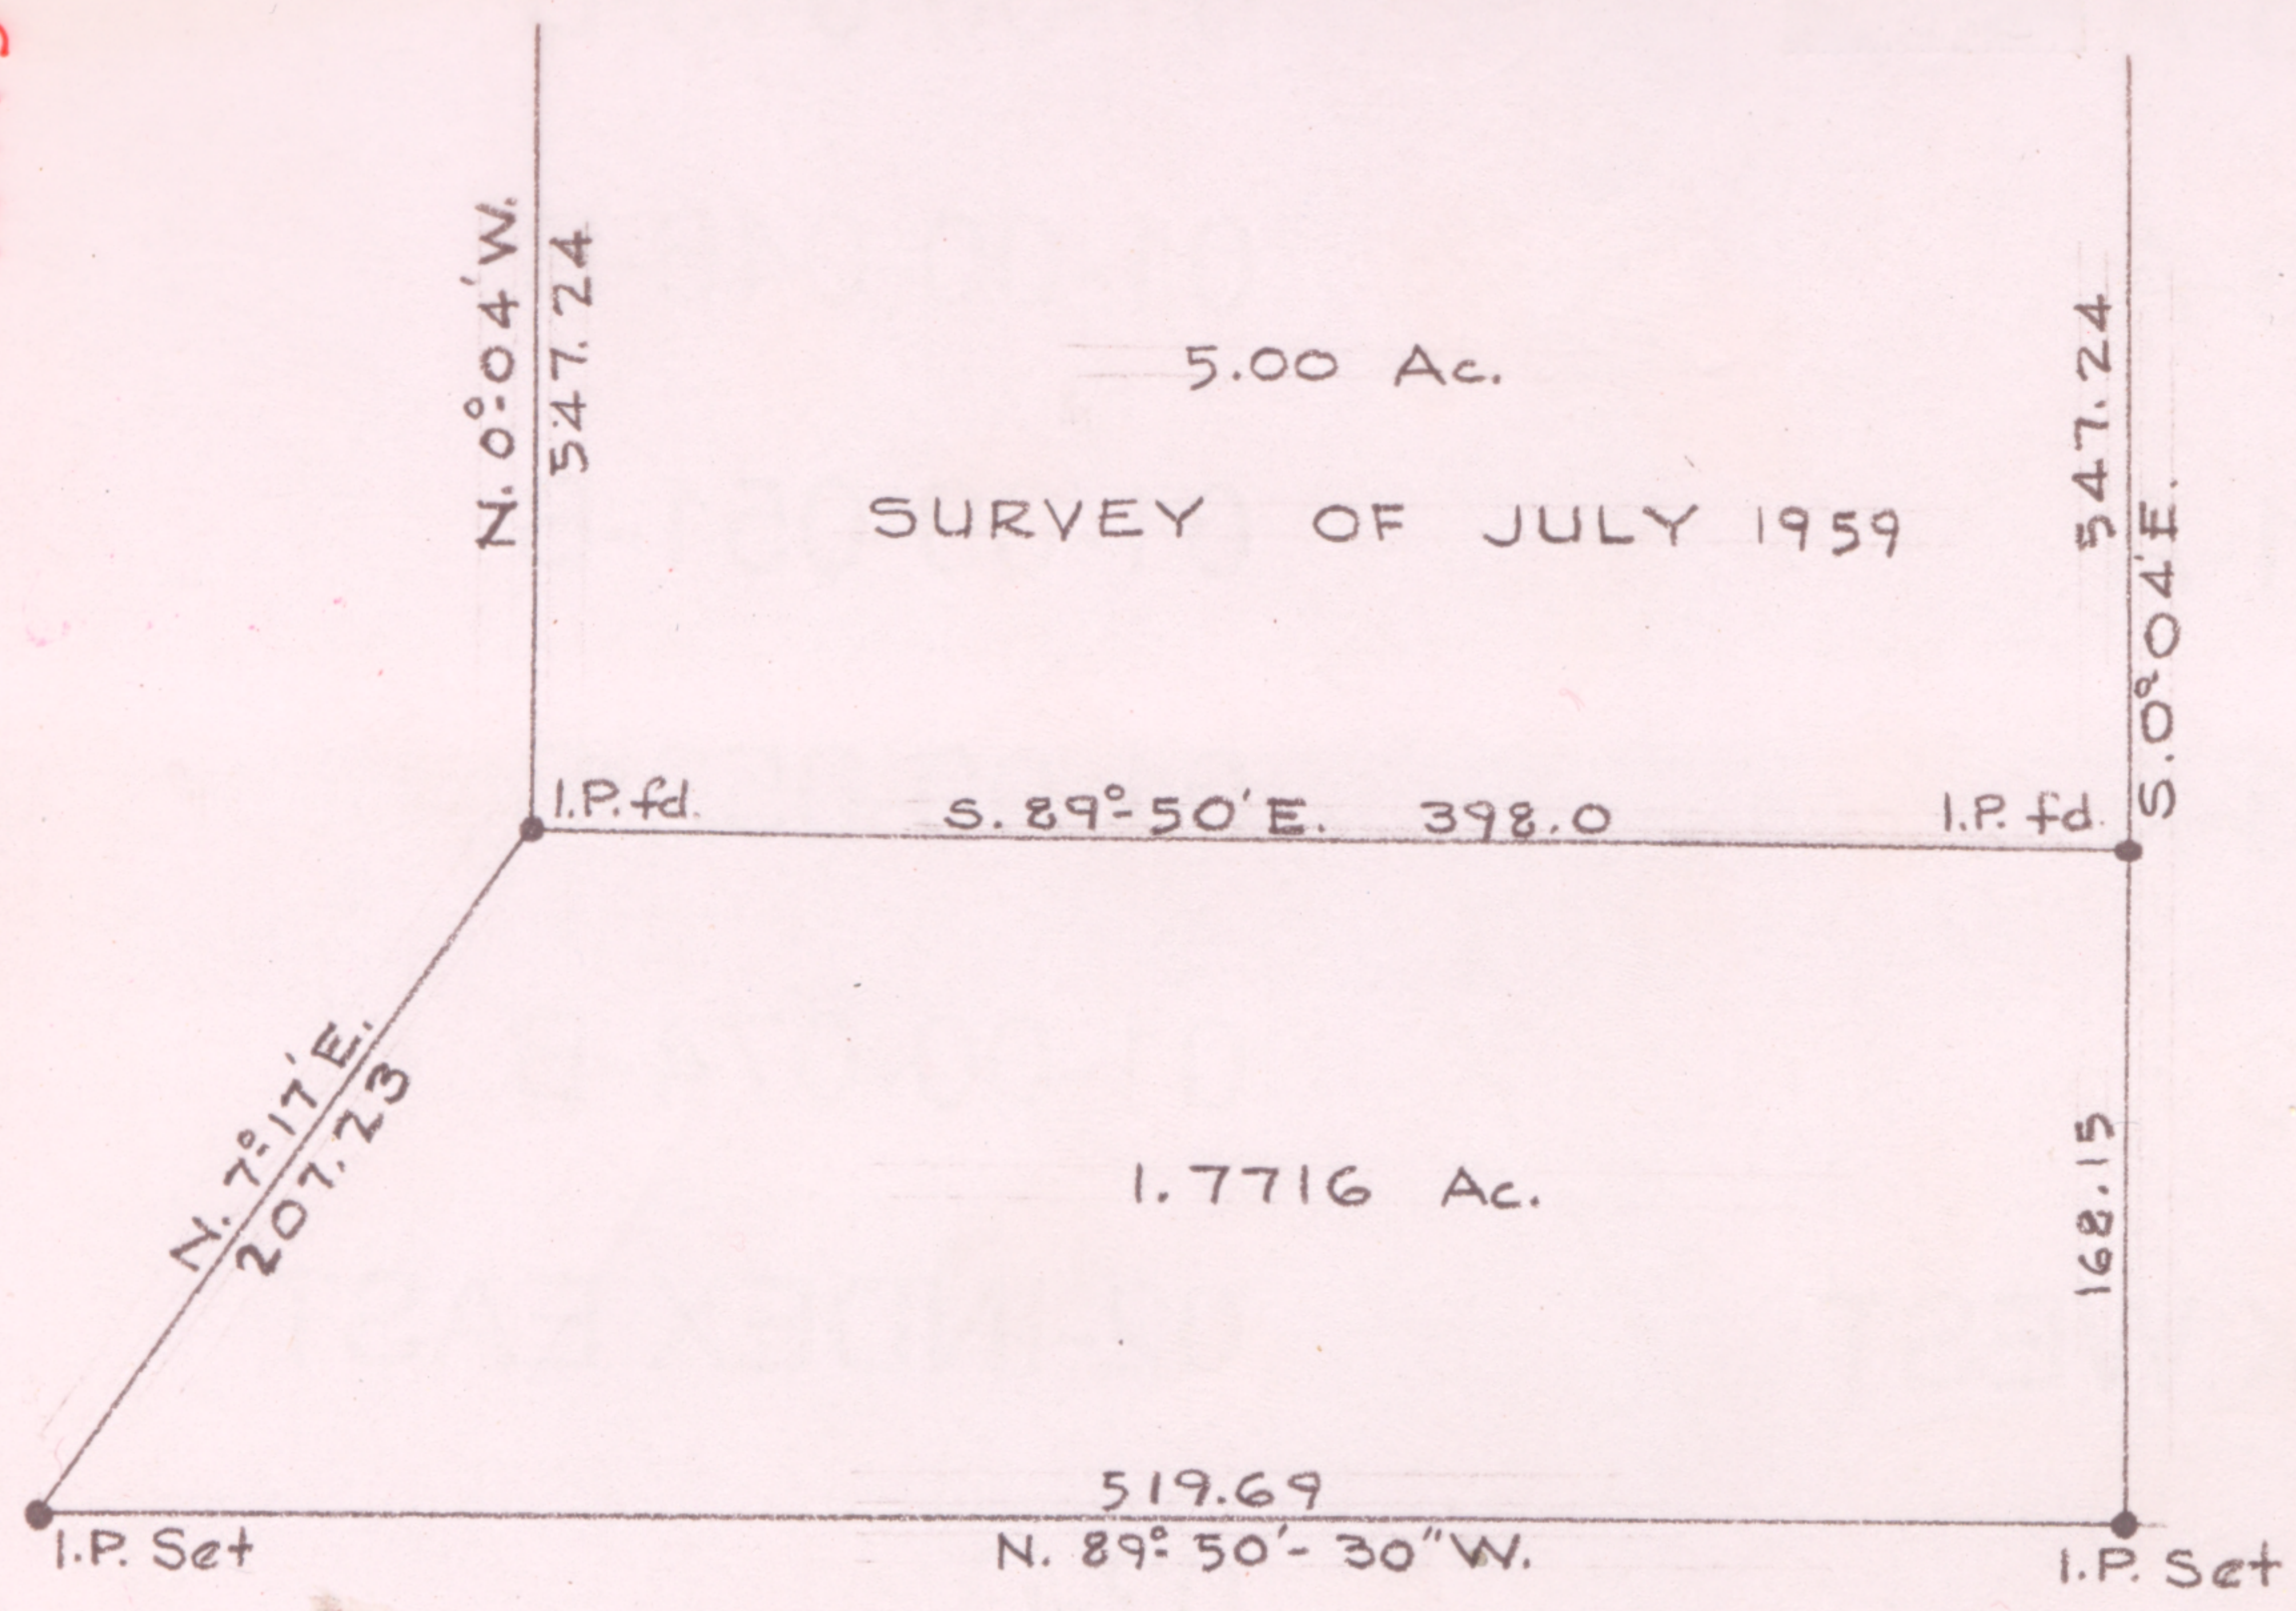

E. R. WEBBER - GRANTOR
D.V. 332-95

SURVEY FOR LORAIN HUNT CLUB
TRACT 2 LOT 19 HUNTINGTON TWP.
LORAIN COUNTY OHIO
SCALE 1"=100' SEPT. 1961
LAUNDON & HUFFMAN SURVEYORS