


21-17-012-000-001
 21-17-012-000-005
 21-17-018-000-005
 21-H
 SCAN # 46946

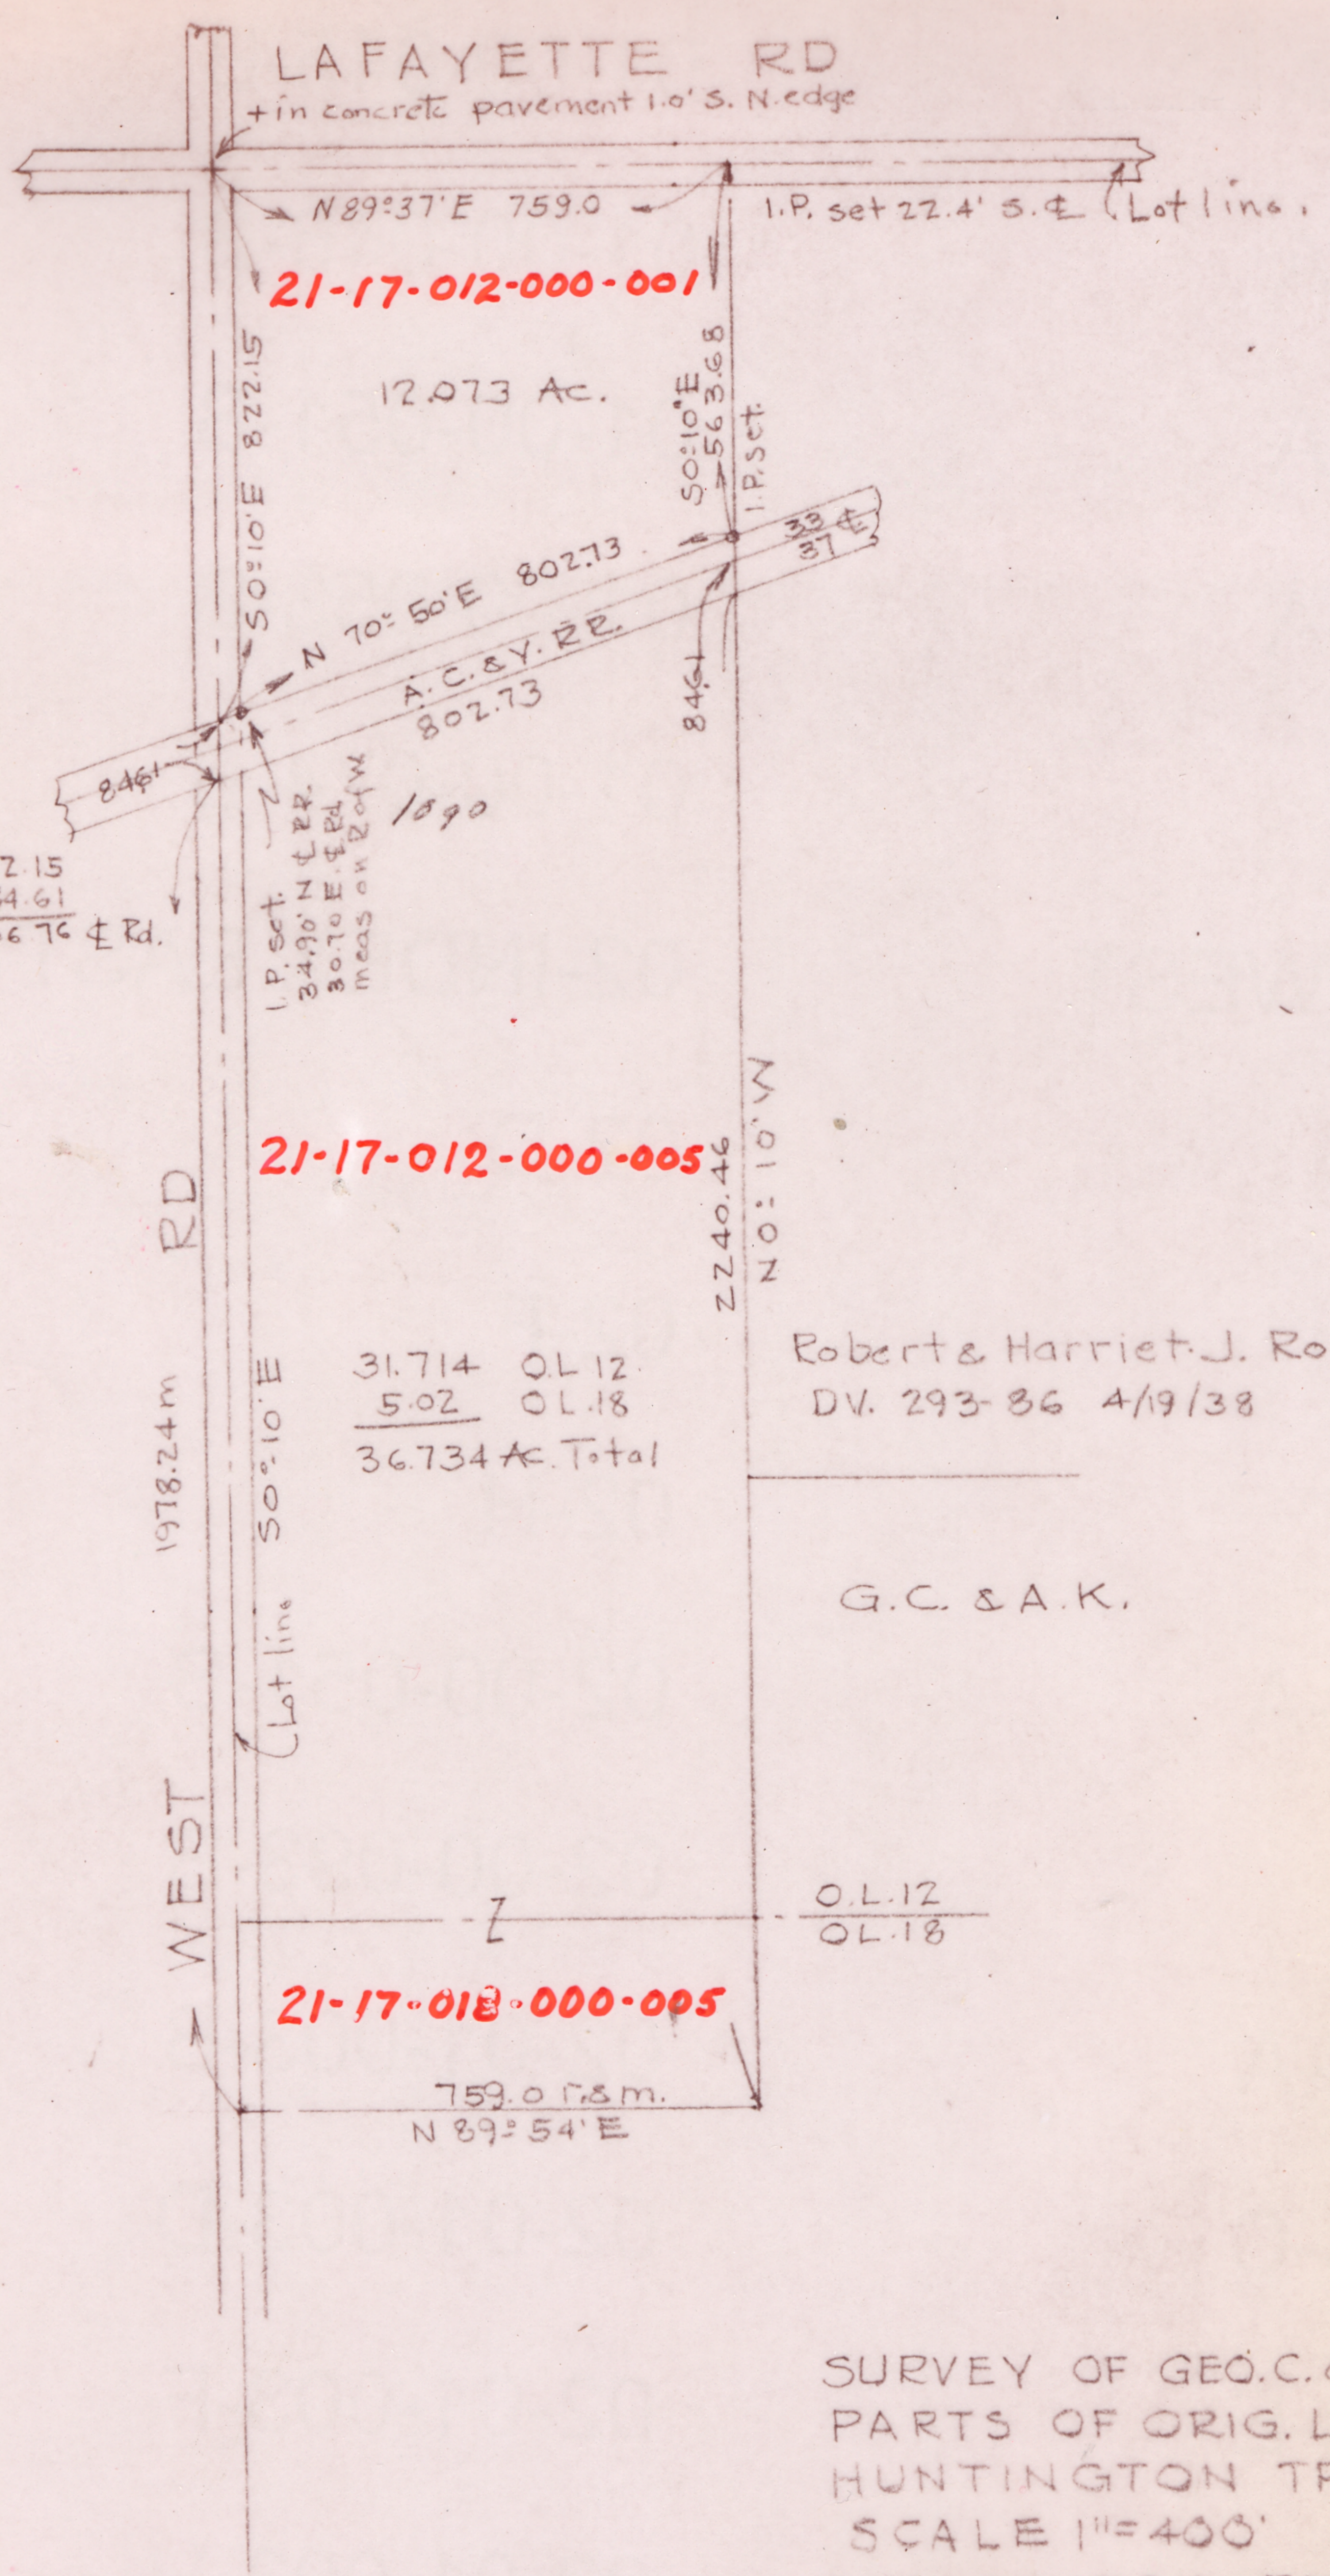

SURVEY OF GEO. C. & ANNA KRUECK LANDS
 PARTS OF ORIG. LOTS 12 & 18 TR. 17
 HUNTINGTON TP. LORAIN CO. OHIO
 SCALE 1" = 400' OCT. 21, 1953
 T.W. LAUNDON REG. SURVEYOR.