

State of Ohio
Registered Professional
Engineer and Surveyor


Phone Home 2024
Office 3247

THOMAS W. LAUNDON
CIVIL ENGINEER AND SURVEYOR

~~405 Elyria Building~~
ELYRIA - OHIO
R.D. 2

Municipal Engineering
Surveys - City, Farm,
Sub-divisions

21-07-000-000-009
21-C
SCAN # 46947

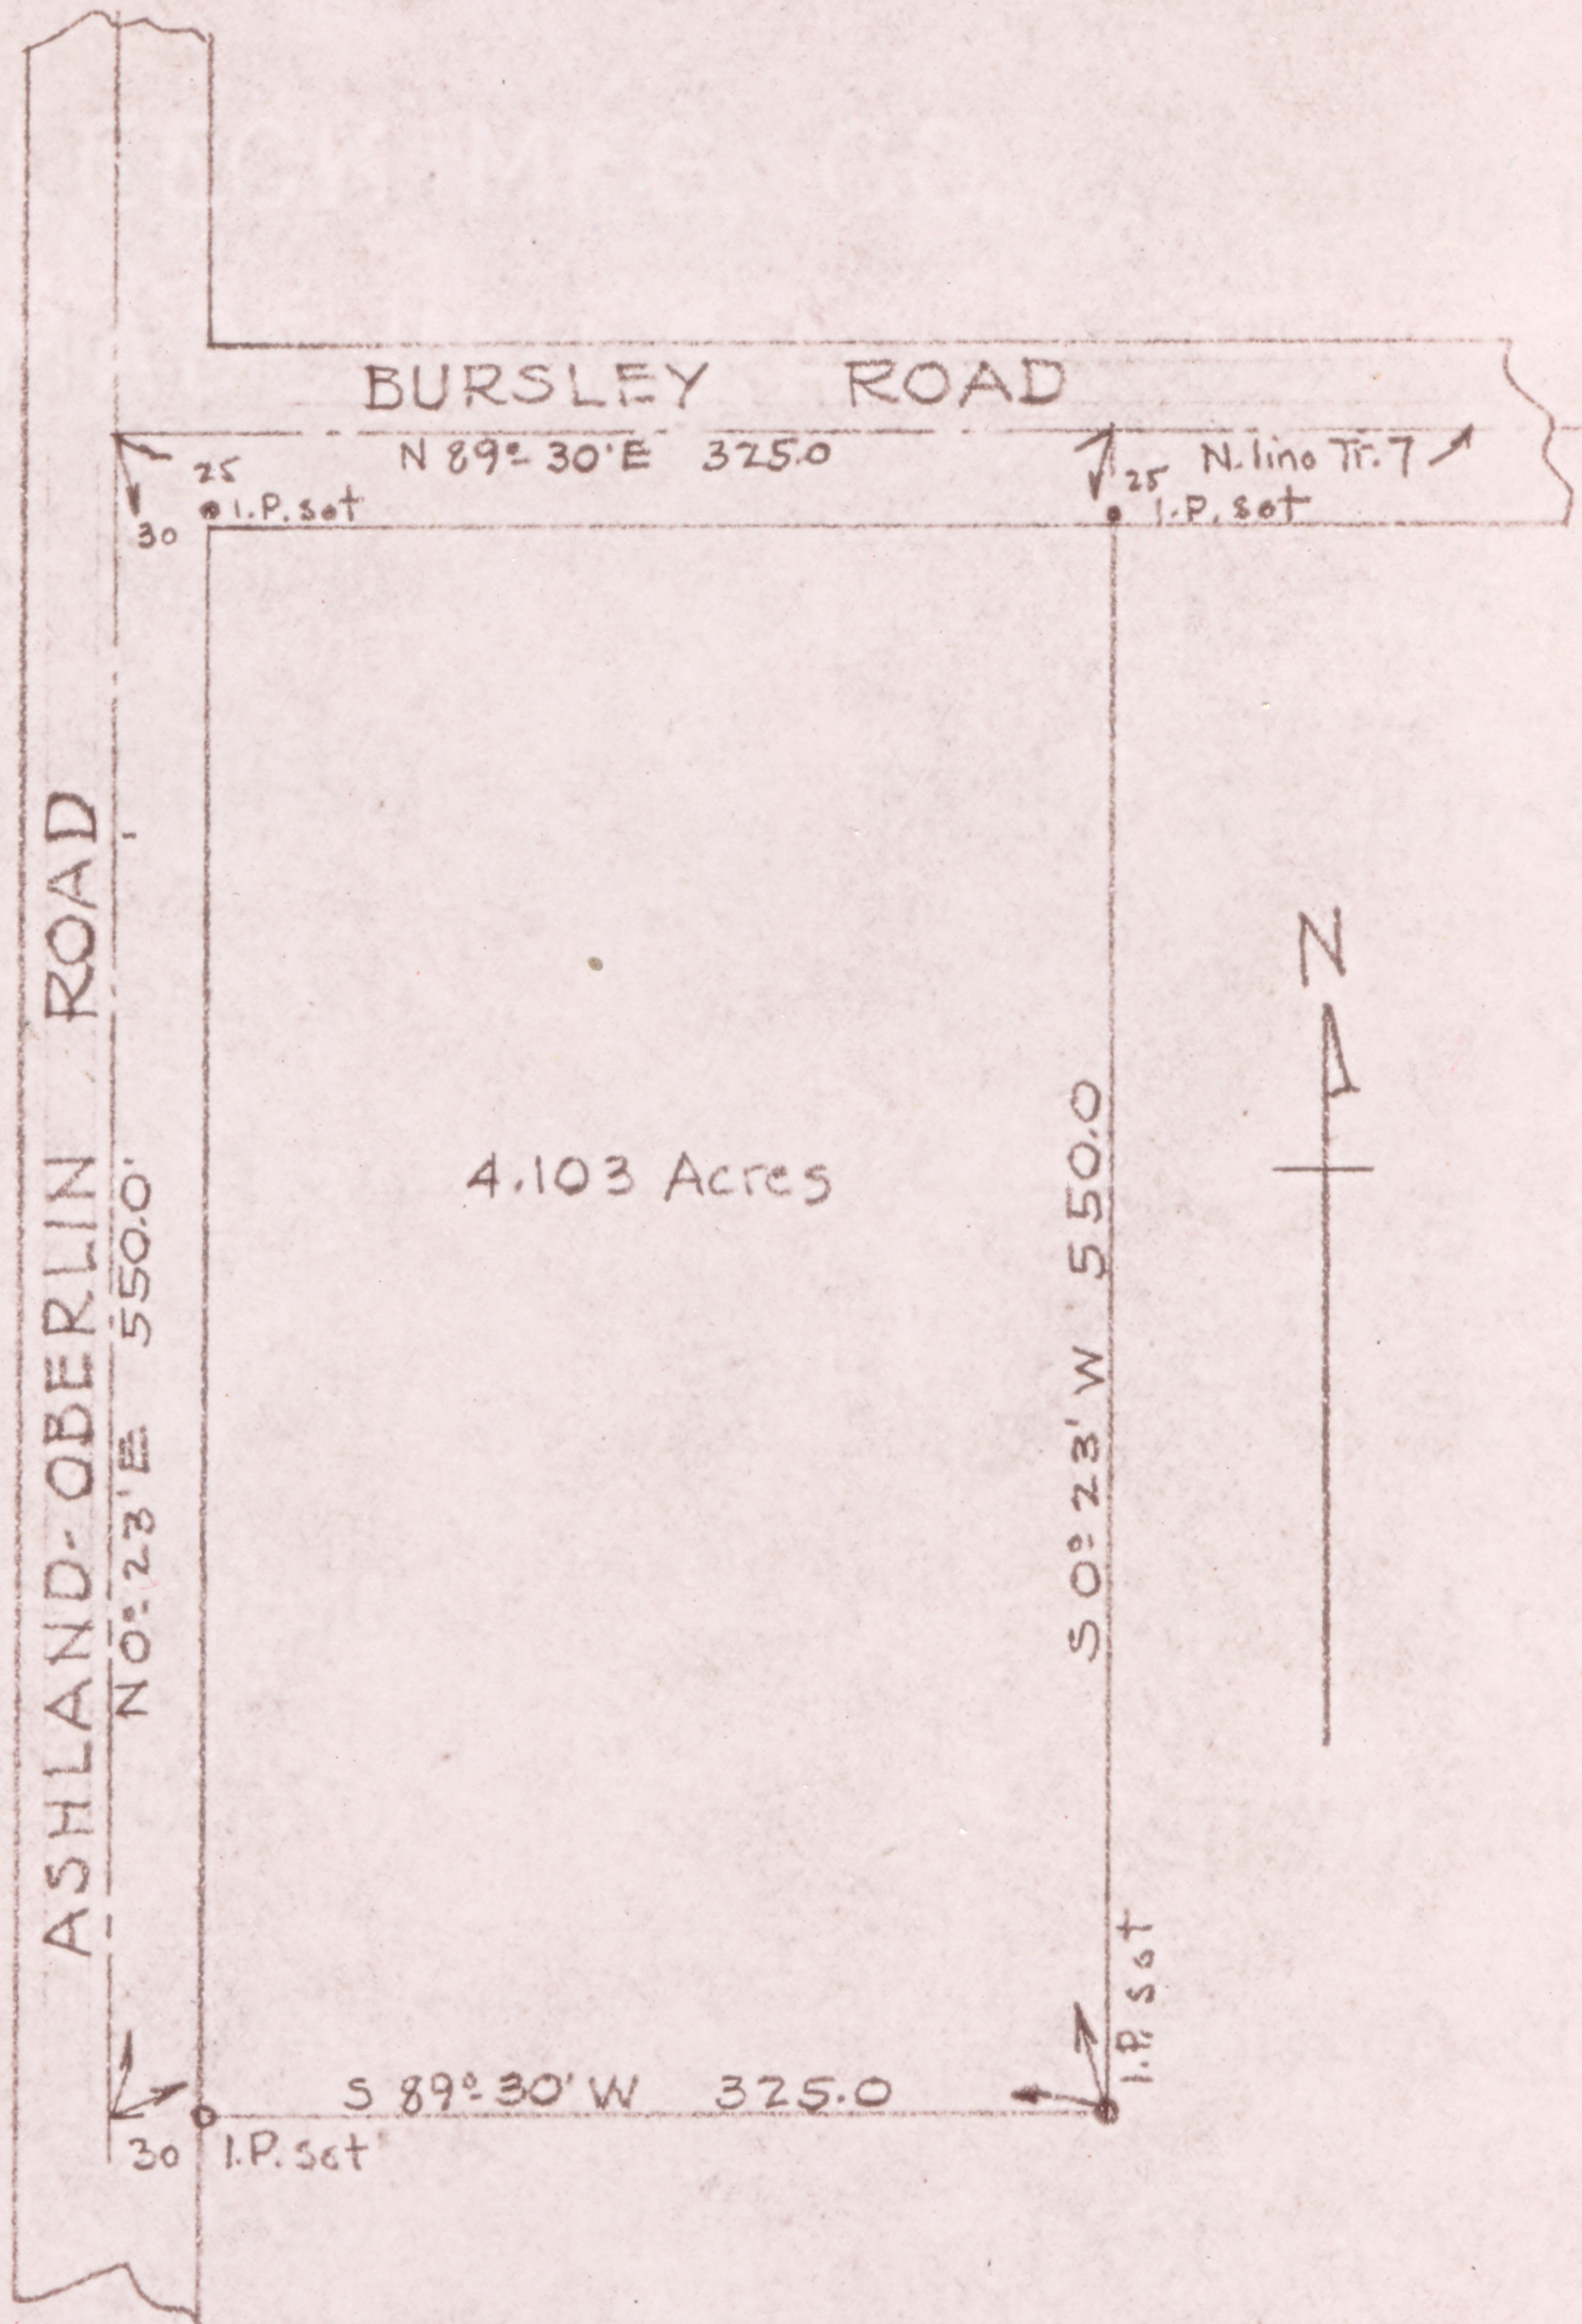

Survey for Urban A. Leonard
Part of Tract No. 7 Huntington Twp.
Lorain Co Ohio Scale 1" = 100'
Feb'y 27, 1946 T.W. Laundon Registered Surveyor