


21-02-019-000-017

21-E

Scan # 46950

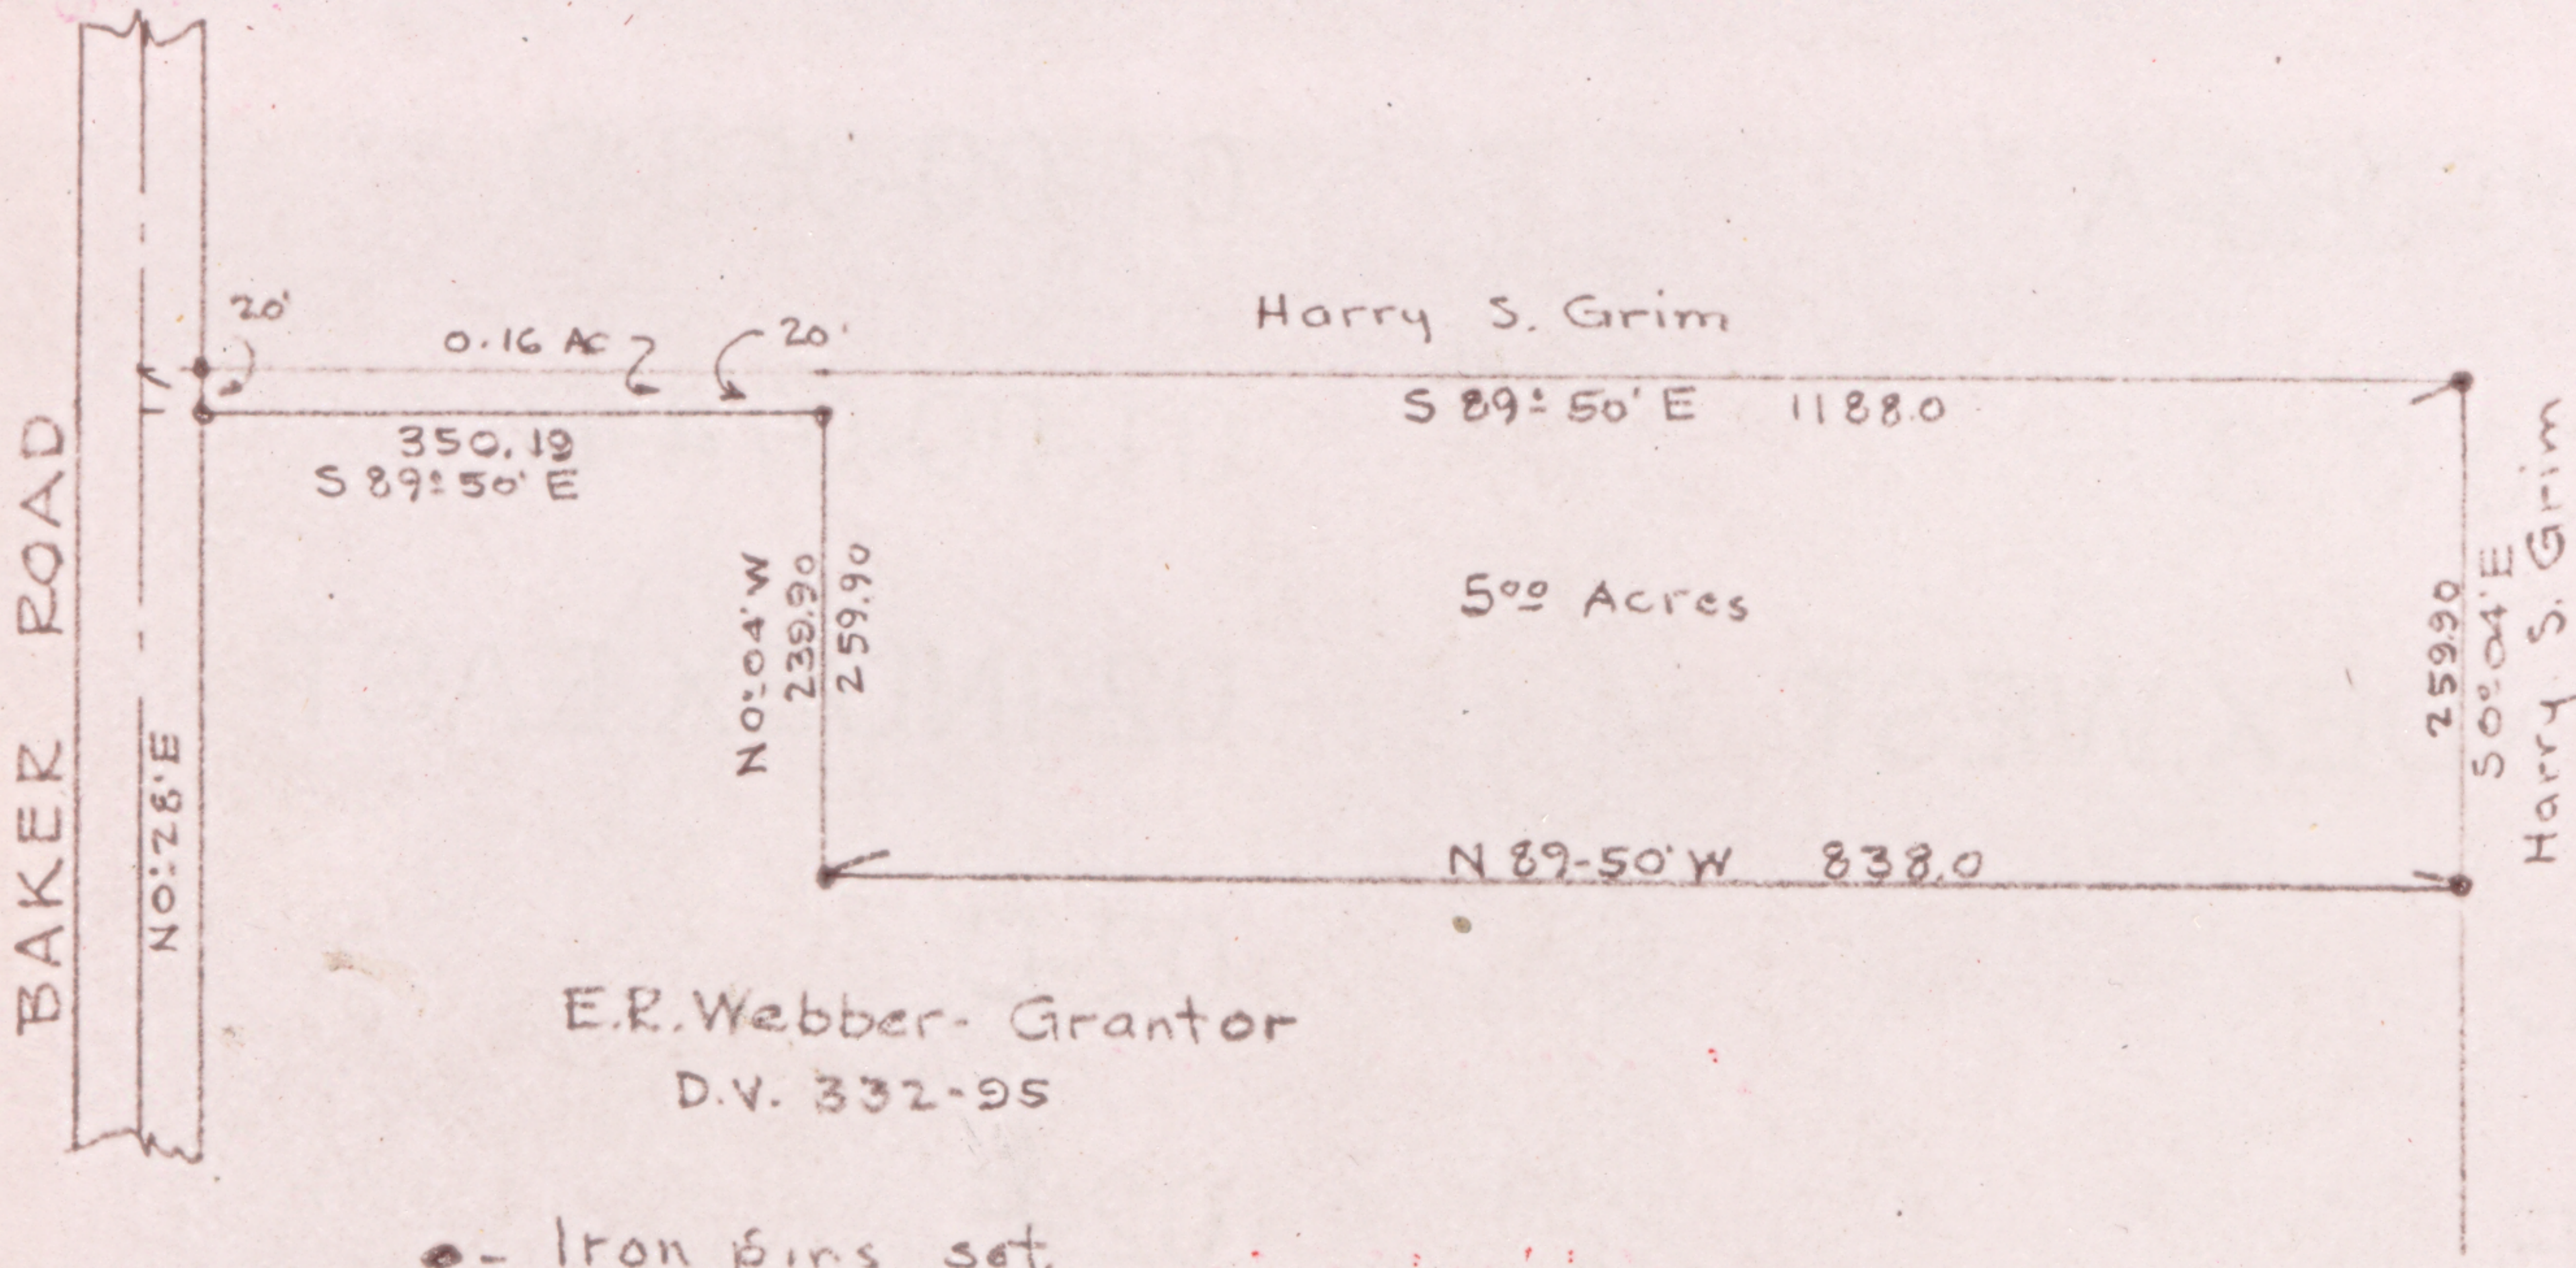

● - Iron pins set.



SURVEY FOR
 LORAIN HUNT CLUB
 TRACT 2 LOT 19 HUNTINGTON
 TWP. LORAIN CO., OHIO.
 SCALE 1" = 200' JUNE 3, 1959
 LAUNDON & HUFFMAN, SURVEYORS