MAP OF SURVEY

for

741 ABBE ROAD

Known as being Sublot No. 1 in Falcon Homes Subdivision, of part of Original Elyria Township Lot No. 28, East of River, now situated in the

CITY OF ELYRIA
COUNTY OF LORAIN – STATE OF OHIO

by

McSTEEN & ASSOCIATES, INC.
ENGINEERS & SURVEYORS
1415 East 286th Street
Wickliffe, Ohio 44092
(440) 585–9800

This survey is a boundary survey prepared in accordance with Chapter 4733–37, Ohio Administrative Code. The basis of bearings for this survey is South 01°–39'–30" West as the centerline of Abbe Road, as evidenced by monuments found, and is the same bearing as found in Volume 23, Page 46 of the Lorain County Records of Plats. Distances are given in feet and decimal parts thereof. All iron pins shown as set are 30" long 5/8" rebar with an identification cap stamped "McSTEEN 7104".

ROBERT A. DORNER — REG. PROF. SURV. No. 6943

Job No.: 11–136
Site No.: 2999
Field Date: July 13, 2011
Survey Date: August 3, 2011

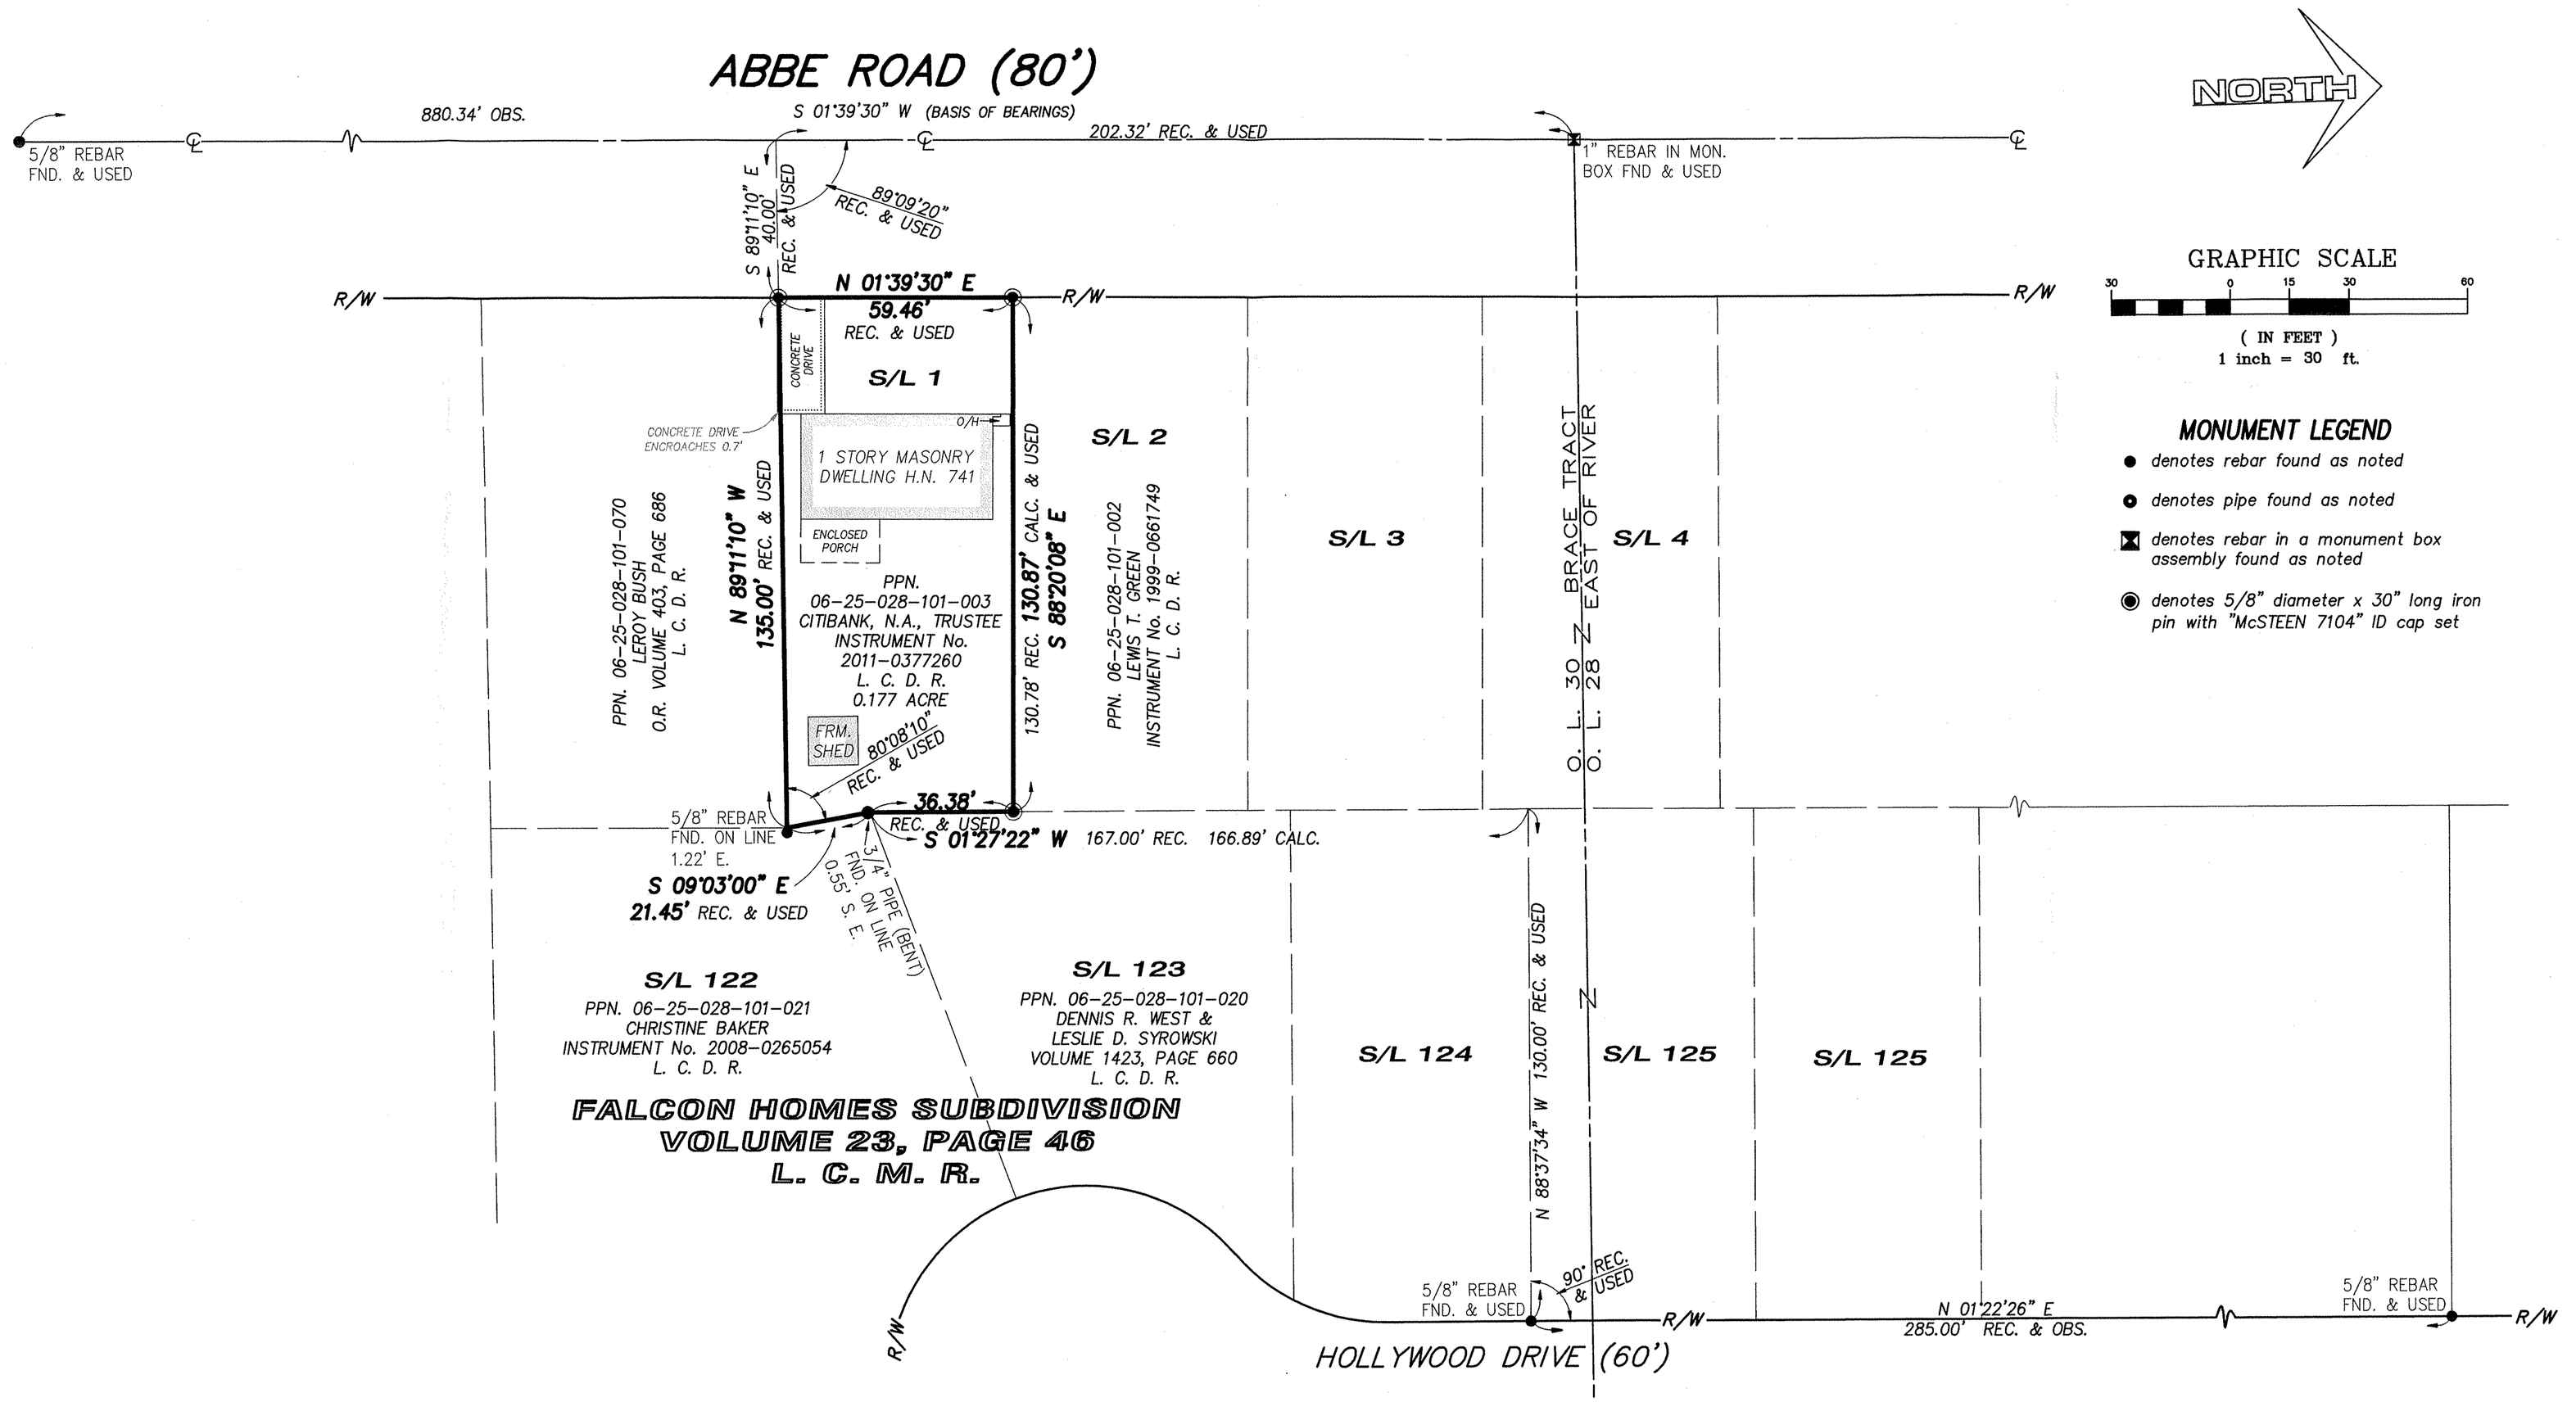

P:\Land Projects 2004\11–136\dwg\11–136.dwg 9/12/2011 4:07:52 PM EDT