DIMENSIONS SHOWN ON THIS PLAT ARE EXPRESSED IN FEET AND DECIMAL PARTS THEREOF. ALL BEARINGS ARE TO AN ASSUMED MERIDIAN AND ARE USED TO INDICATE ANGLES ONLY. PERMANENT MONUMENTS WERE FOUND OR SET AT ALL POINTS INDICATED HEREON, ALL OF WHICH I CERTIFY TO BE CORRECT.

STATE OF OHIO THOMAS A. SIMON S-7775 REGISTERED SURVEYOR

THOMAS A. SIMON
REG. PROFESSIONAL SURVEYOR
NO. S-7775

100 0 100 200 300
GRAPHIC SCALE - FEET

-N-

BASIS OF BEARINGS IS THE CENTERLINE OF CASE ROAD (NORTH 12°12'01" WEST).

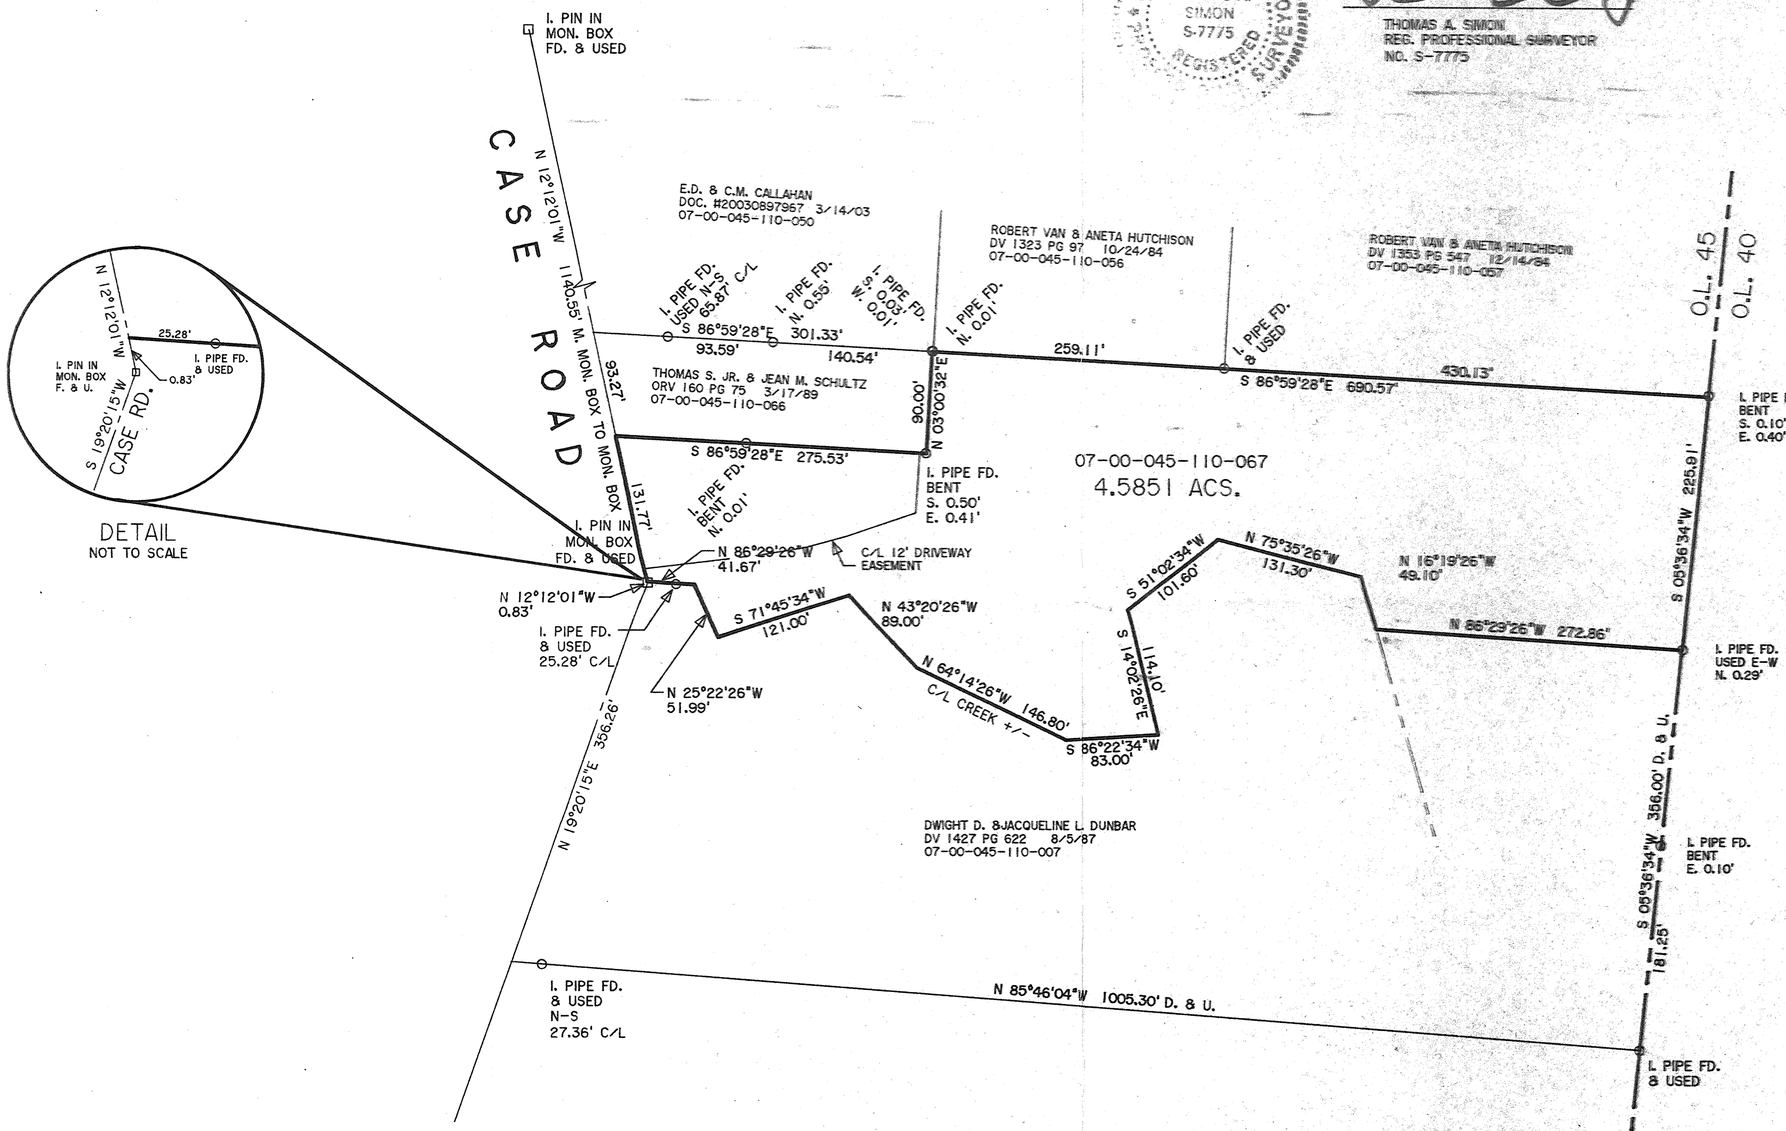

07-00-045-110-067
07-00-045-B
SCAN # 47007

PLAT OF SURVEY FOR JEAN SCHULTZ

BEING KNOWN AS PART OF ORIGINAL RIDGEVILLE TOWNSHIP LOT NO. 45

CITY OF NORTH RIDGEVILLE COUNTY OF LORAIN
STATE OF OHIO

JULY, 2009 SCALE: 1" = 100'

THOMAS SIMON & ASSOCIATES, INC.
PROFESSIONAL LAND SURVEYORS

150 SOUTH OLIVE STREET
ELYRIA, OHIO 44035

(440) 327-2925
FAX 327-2964

APPROVED
LORAIN CO.
MAP DEPT.
DATE 11/28/11
PAGE 7-00-045-B
BY T. SPILLMAN
ORDER #11-102394-C

JOB NO. 2009-024