05-00-083-000-019
020
05-00-083

Note: Bearings shown are to an assumed Meridian and are used to describe angles only.

Being known as part of Amherst Township, Original Lot 83, County of Lorain and the State of Ohio, and also Known as Lorain County Tax Map Number 05-00-083-000-004.

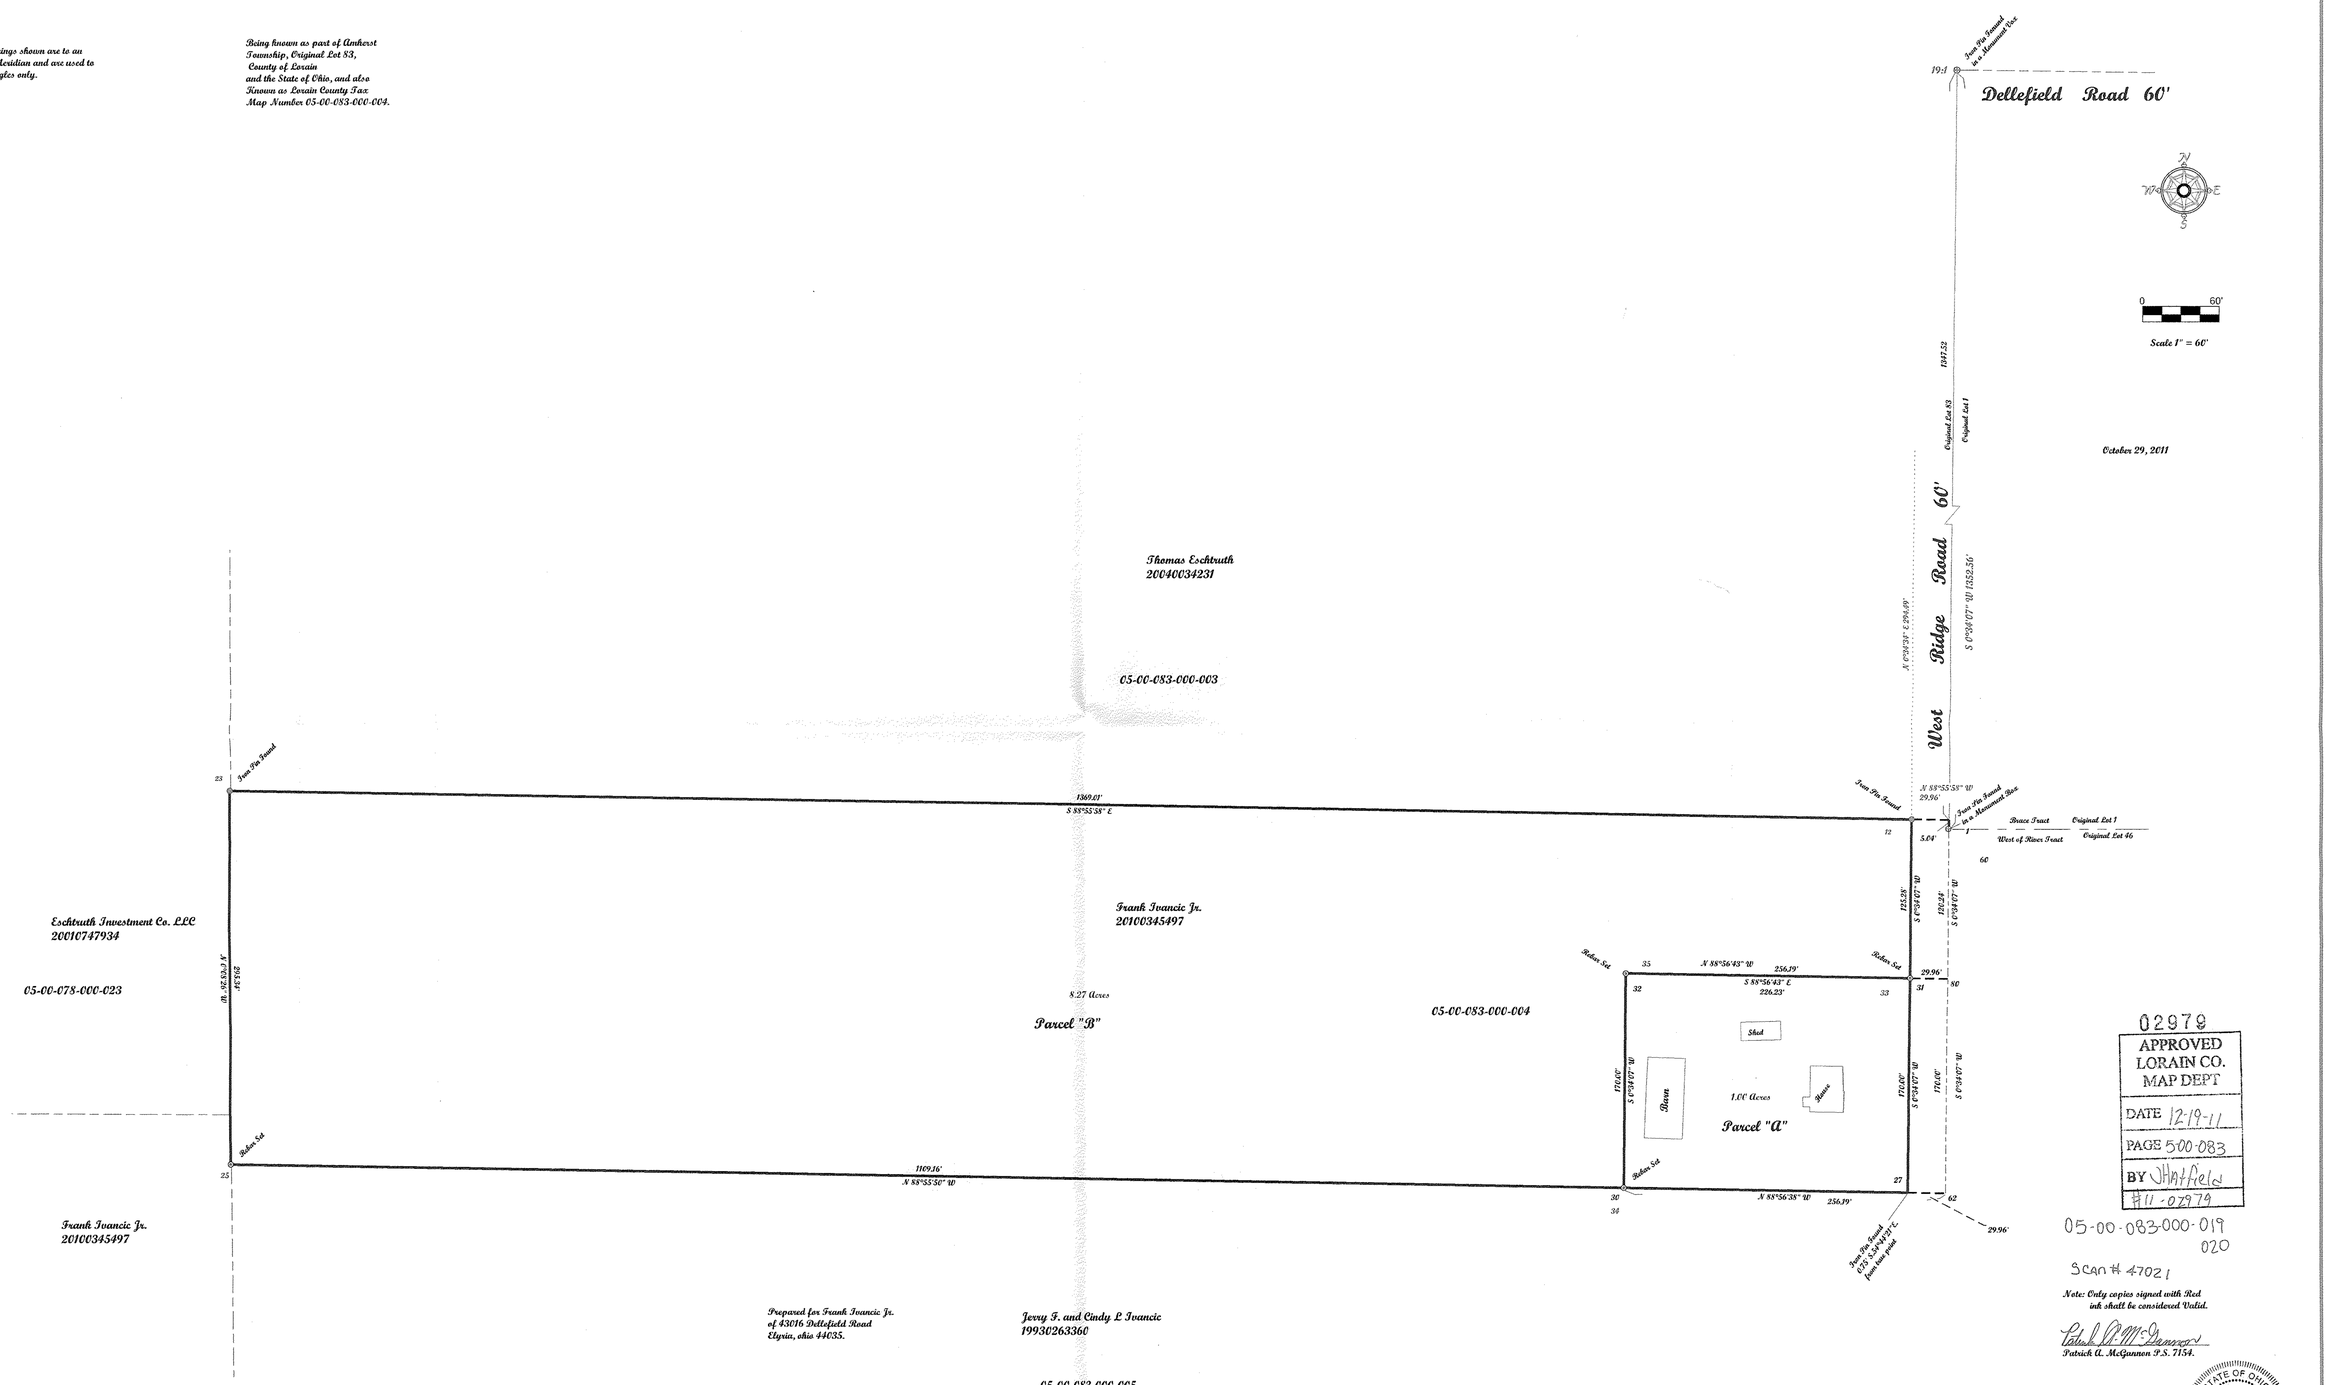

02979
APPROVED
LORAIN CO.
MAP DEPT
DATE 12-19-11
PAGE 500-083
BY JHatfield
#11-02979

05-00-083000-019
020

Scan # 47021

Note: Only copies signed with Red ink shall be considered Valid.

Patrick A. McGannon P.S. 7154.

STATE OF OHIO
PATRICK A. McGANNON
7154
REGISTERED
PROFESSIONAL SURVEYOR

Note: Dimensions shown in Blue are record values and those shown in red are field observed values.

Boundary Survey

Patrick A. McGannon
Registered Professional Surveyor
1731 Gettysburg Drive, Lorain, Ohio 44053 (440) 282-2712
www.mcgannonsurveying.com

Traverse PC