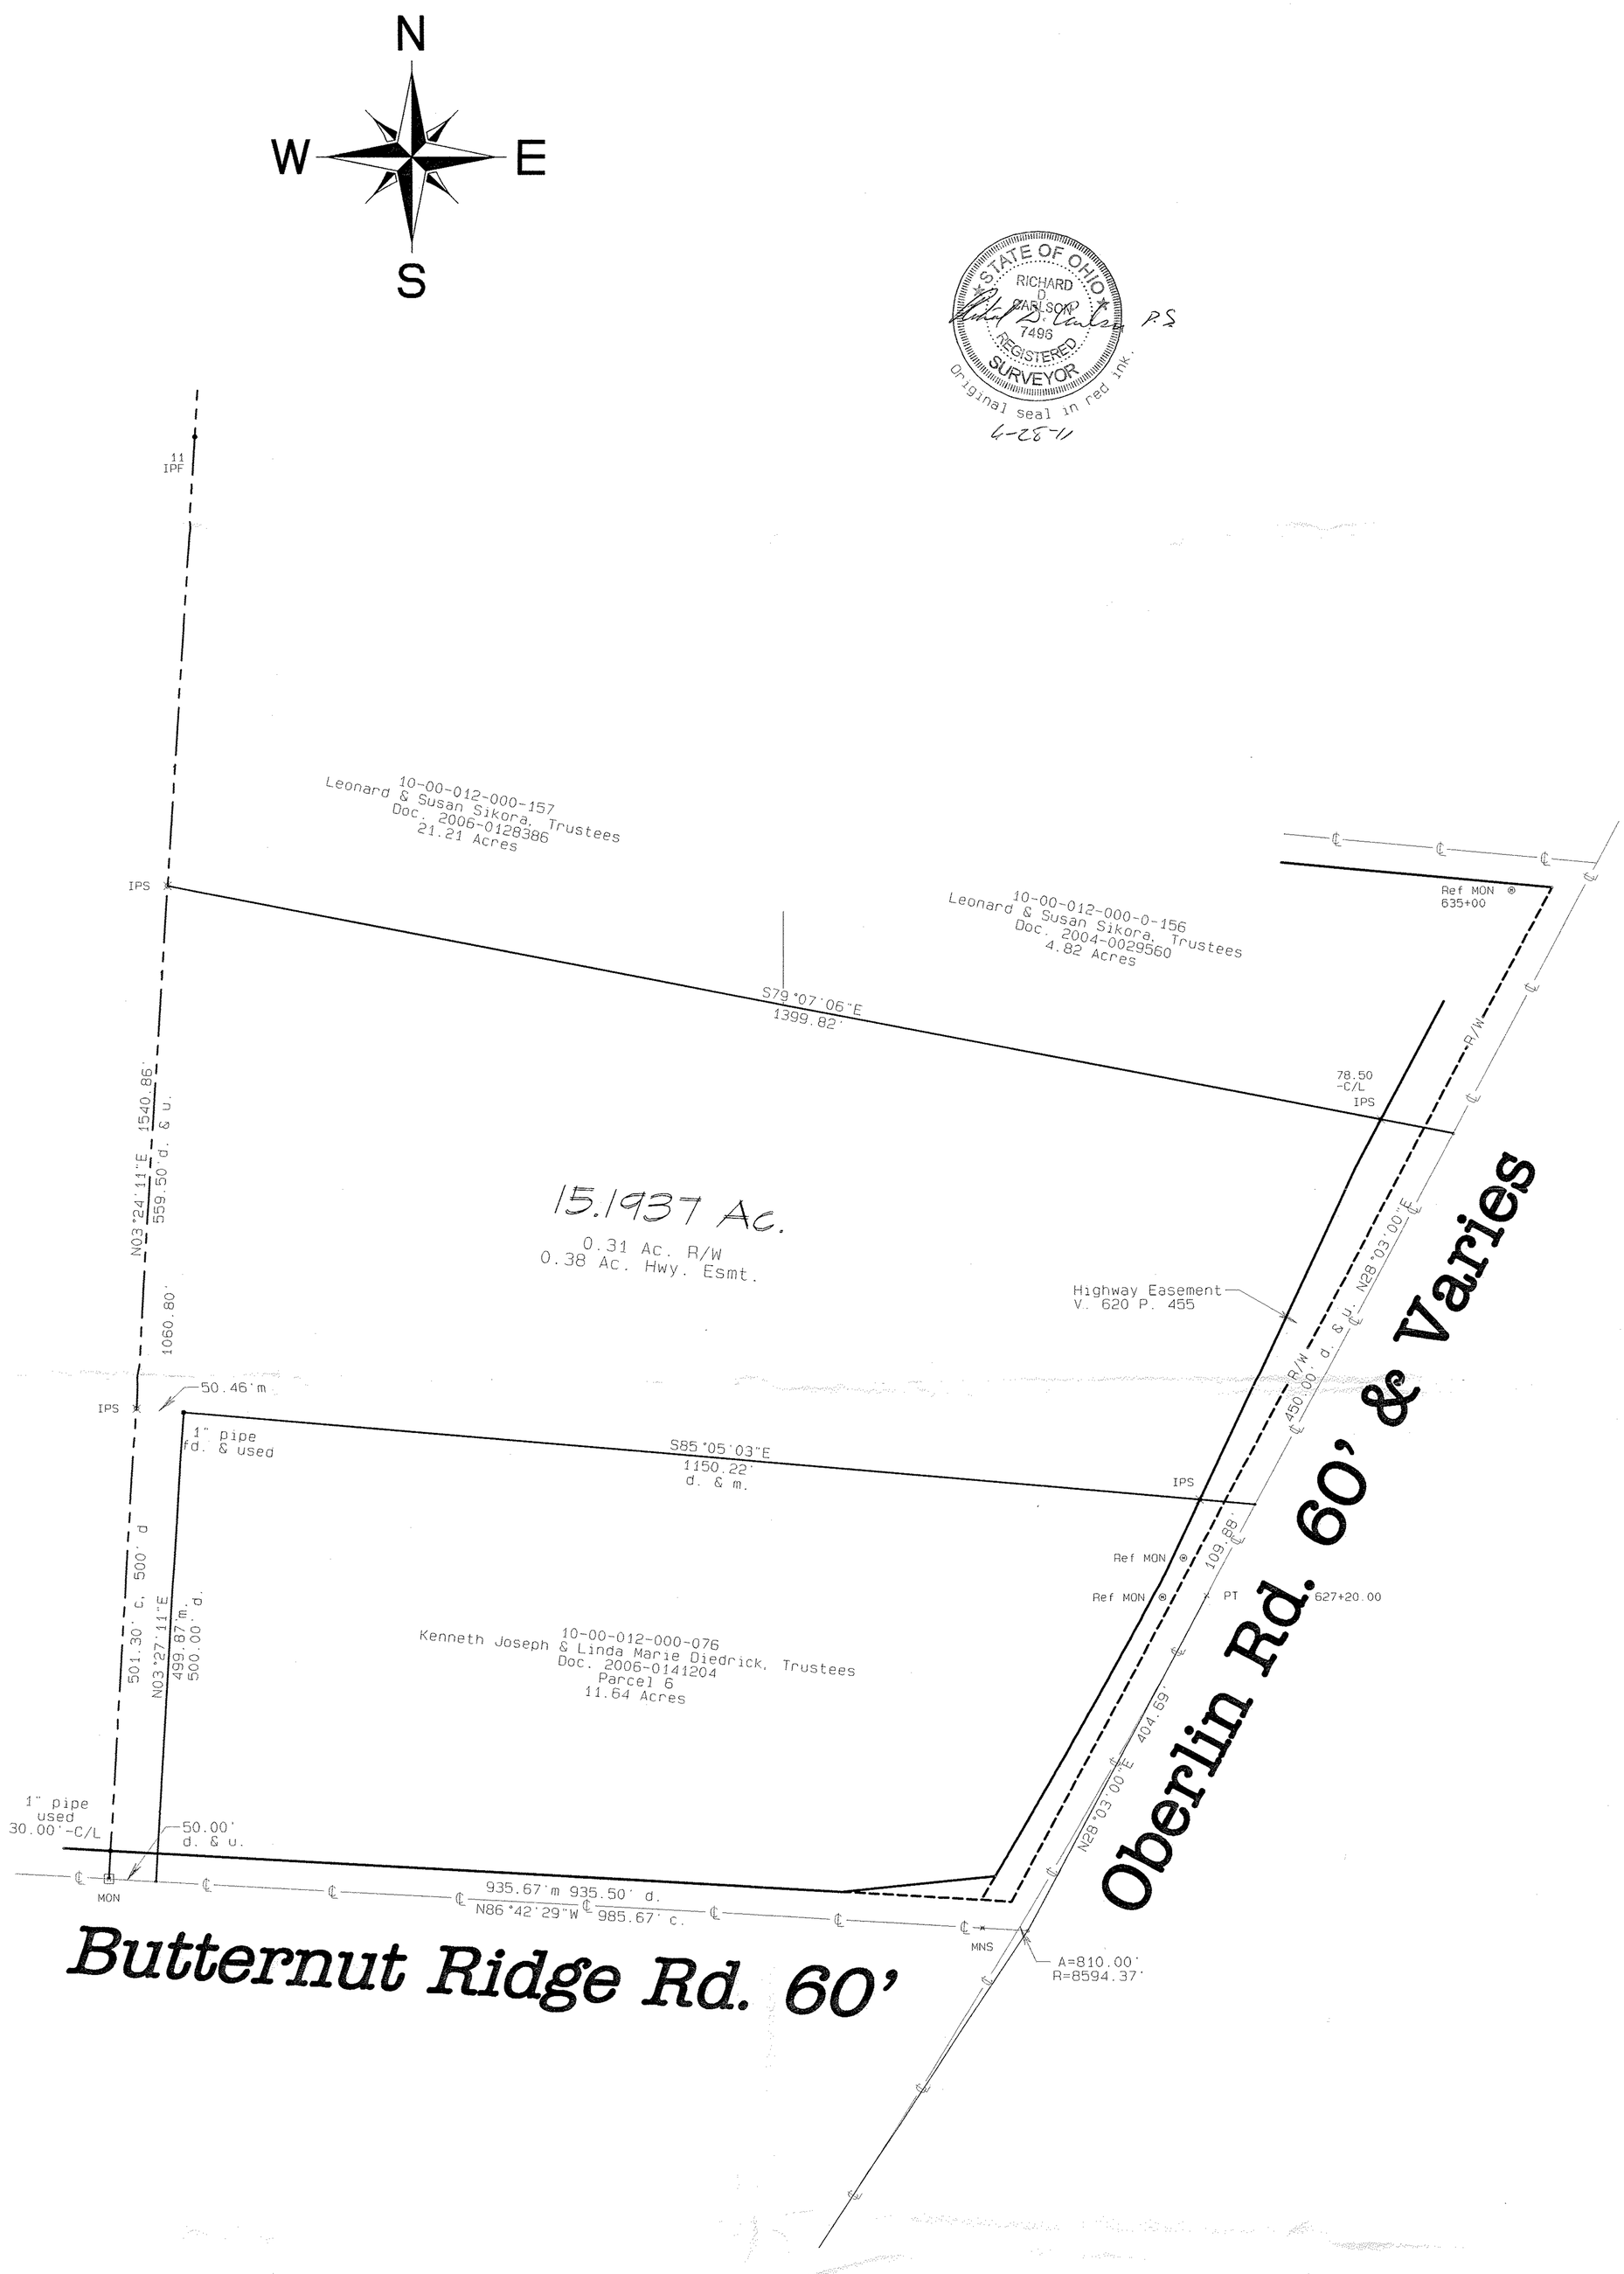

Plat of Survey

Ken & Linda Diedrick

Carlisle Twp.
Lorain Co.

Section 12
Ohio

Carlson Surveys

May 2011

Job: 1003-07R

APPROVED
LORAIN CO.
MAP DEPT
DATE 7-14-11
PAGE 10-00-012-A
BY R. MAINES
#11-02320-D

10-00-012-000-059
Scan # 47025

GRAPHIC SCALE 1"=100'

0 100 200 300

10-00-012-000-059
10-00-012-A
Scan # 47025