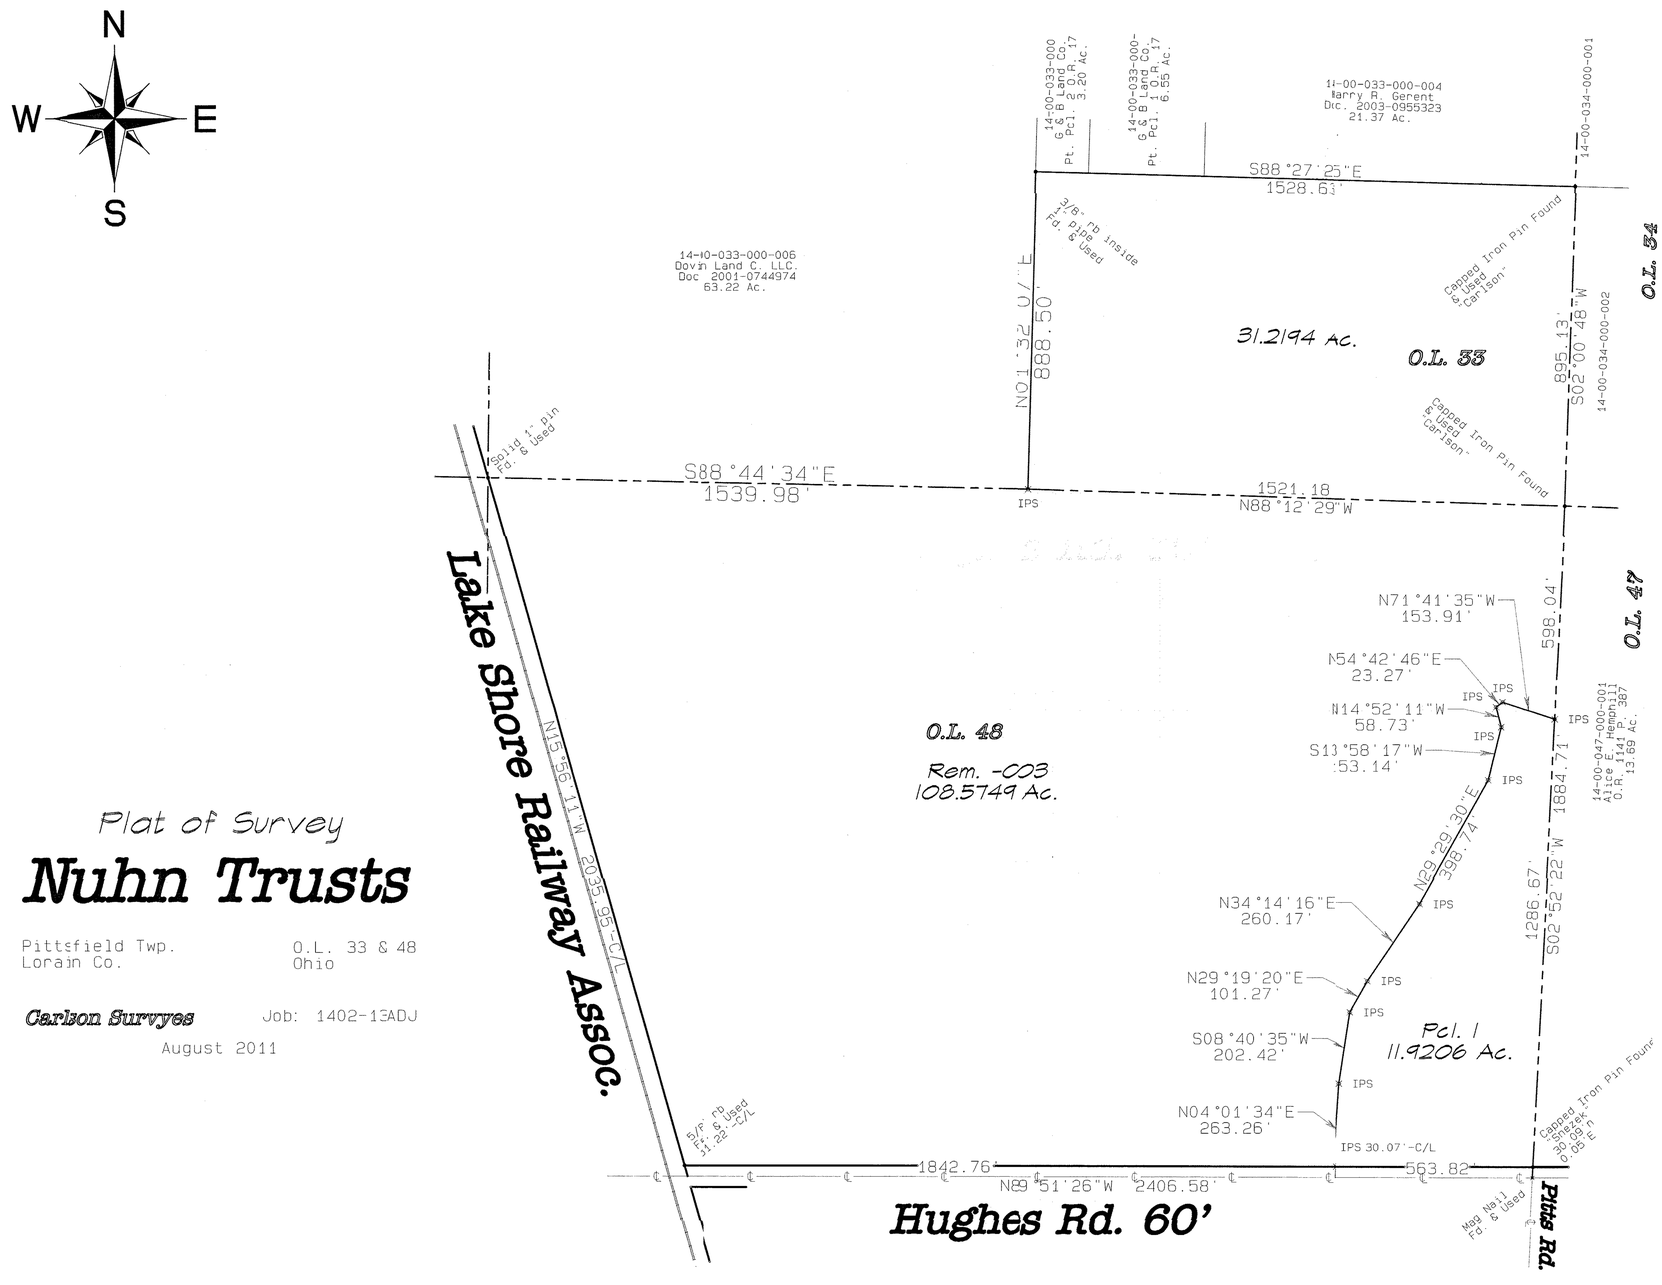

Plat of Survey

Nuhn Trusts

Pittsfield Twp. O.L. 33 & 48
Lorain Co. Ohio

Carlson Surveyes Job: 1402-13ADJ

August 2011

GRAPHIC SCALE 1"=200'

0 200 400 600

03018
APPROVED
LORAIN CO.
MAP DEPT
DATE 4-27-12
MAP 14-B
BY J Hatfield
#12-03018

14-00-048-000-006
007
14-00-033-000-005

STATE OF OHIO
RICHARD D. CARLSON
No. 7841
REGISTERED
SURVEYOR

Original seal in red ink.
9-30-11