Rafter A LTD
10980 Lagrange Road
Elyria, OH 44035
440-309-5275

Plat of Survey
State of Ohio
County of Lorain
Township of Carlisle
Section No. 1
PP # 10-00-001-101-058
Remainder from
DV 1036 PG 531
Owner
Leonard J. Shinsky
&
Carol L. Shinsky
2.3394 acres as surveyed

Legend

- ○ iron pin or pipe found as noted
- ● 5/8" rebar w/ cap "Rafter A. LTD" set
- • magnetic nail set
- ⊠ monument box with brass capped pin
- —x— fence line

SCALE 1"=50'
0 50 100

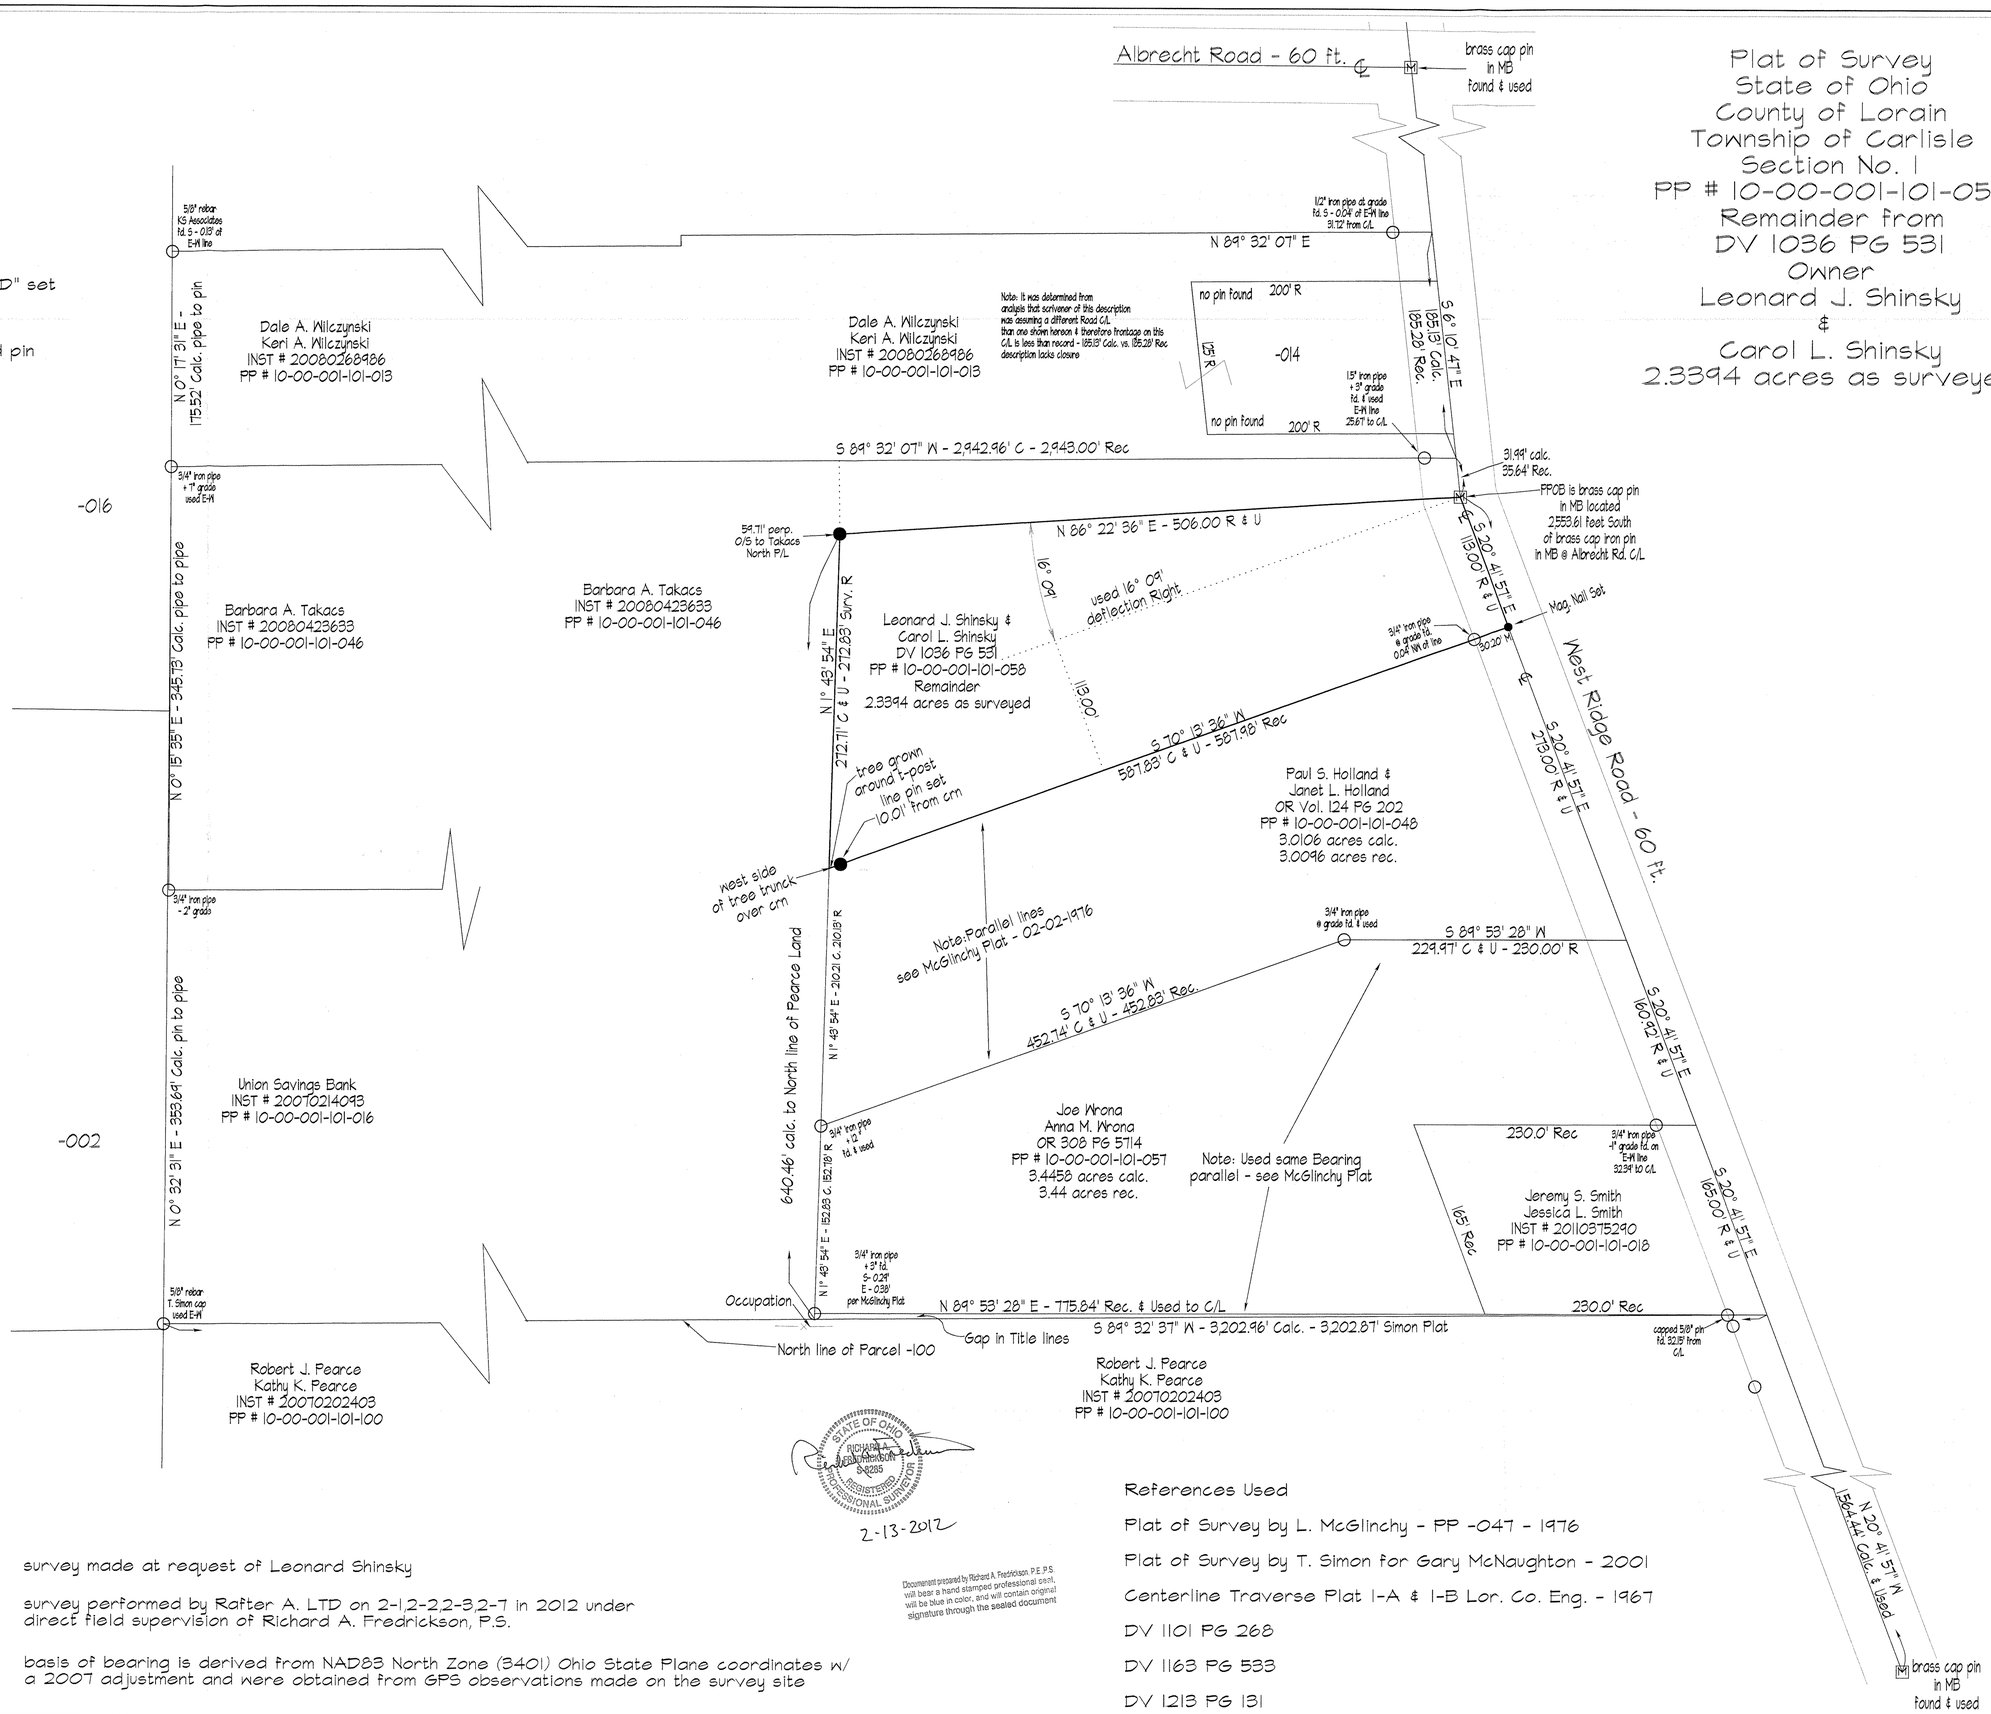

STATE OF OHIO
RICHARD A. FREDRICKSON
S-8285
REGISTERED
PROFESSIONAL SURVEYOR

2-13-2012

Document prepared by Richard A. Fredrickson, P.E. P.S. will bear a hand stamped professional seal, will be blue in color, and will contain original signature through the sealed document

survey made at request of Leonard Shinsky

survey performed by Rafter A. LTD on 2-1,2-2,2-3,2-7 in 2012 under direct field supervision of Richard A. Fredrickson, P.S.

basis of bearing is derived from NAD83 North Zone (3401) Ohio State Plane coordinates w/ a 2007 adjustment and were obtained from GPS observations made on the survey site

References Used

Plat of Survey by L. McGlinchy - PP -047 - 1976

Plat of Survey by T. Simon for Gary McNaughton - 2001

Centerline Traverse Plat 1-A & 1-B Lor. Co. Eng. - 1967

DV 1101 PG 268

DV 1163 PG 533

DV 1213 PG 131

APPROVED
LORAIN CO.
MAP DEPT
DATE 3-21-12
MAP 10-00-001-8
BY R. Mylnes
12-024635-B
10-00-001-101-058
10-00-001-101-058
scan #47092