

SURVEY
OF PART OF
ORIGINAL RIDGEVILLE TWP.
LOTS NOS 13 & 24
CITY OF N. RIDGEVILLE CO. OF LORAIN
STATE OF OHIO

PREPARED FOR:

MICHAEL ZUNICH & ASSOC.
ENGINEER

AND

KEITH JOHNSON


34805 CENTER RIDGE RD
N. RIDGEVILLE, O

DATE: JUNE 1983
SCALE: 1" = 40'
LAND SPLIT DEC 1981
LINT ADDED 12/18/81

THE CAVALIER GILLING WILSON CO
1091/105

PARCEL ACRES

- A - 0.0423
- B - 0.2170
- C - 0.3085
- D - 0.3411
- E - 0.4353
- F - 0.0037
- G - 0.1924
- H - 0.4874
- I - 0.5157
- J - 0.5145

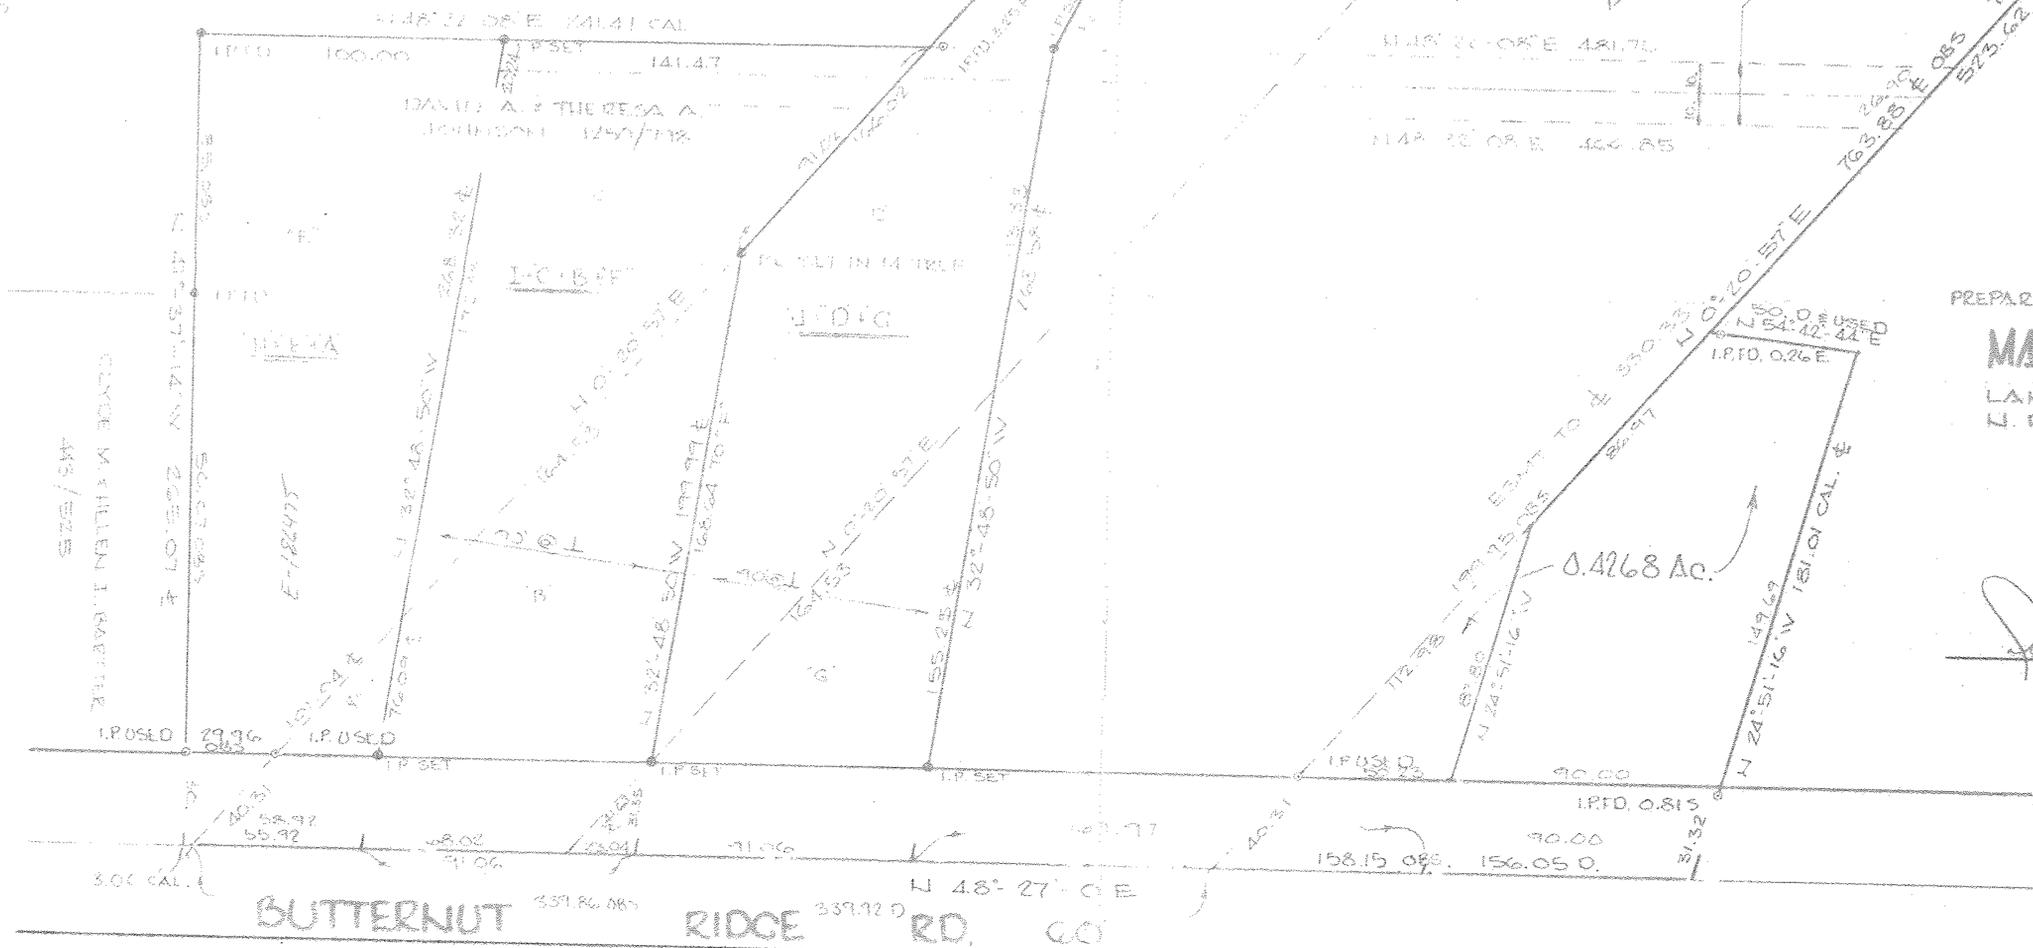

PREPARED BY:

MARTINI-HAPONEK & ASSOC.

LAND SURVEYORS
N. RIDGEVILLE, O

