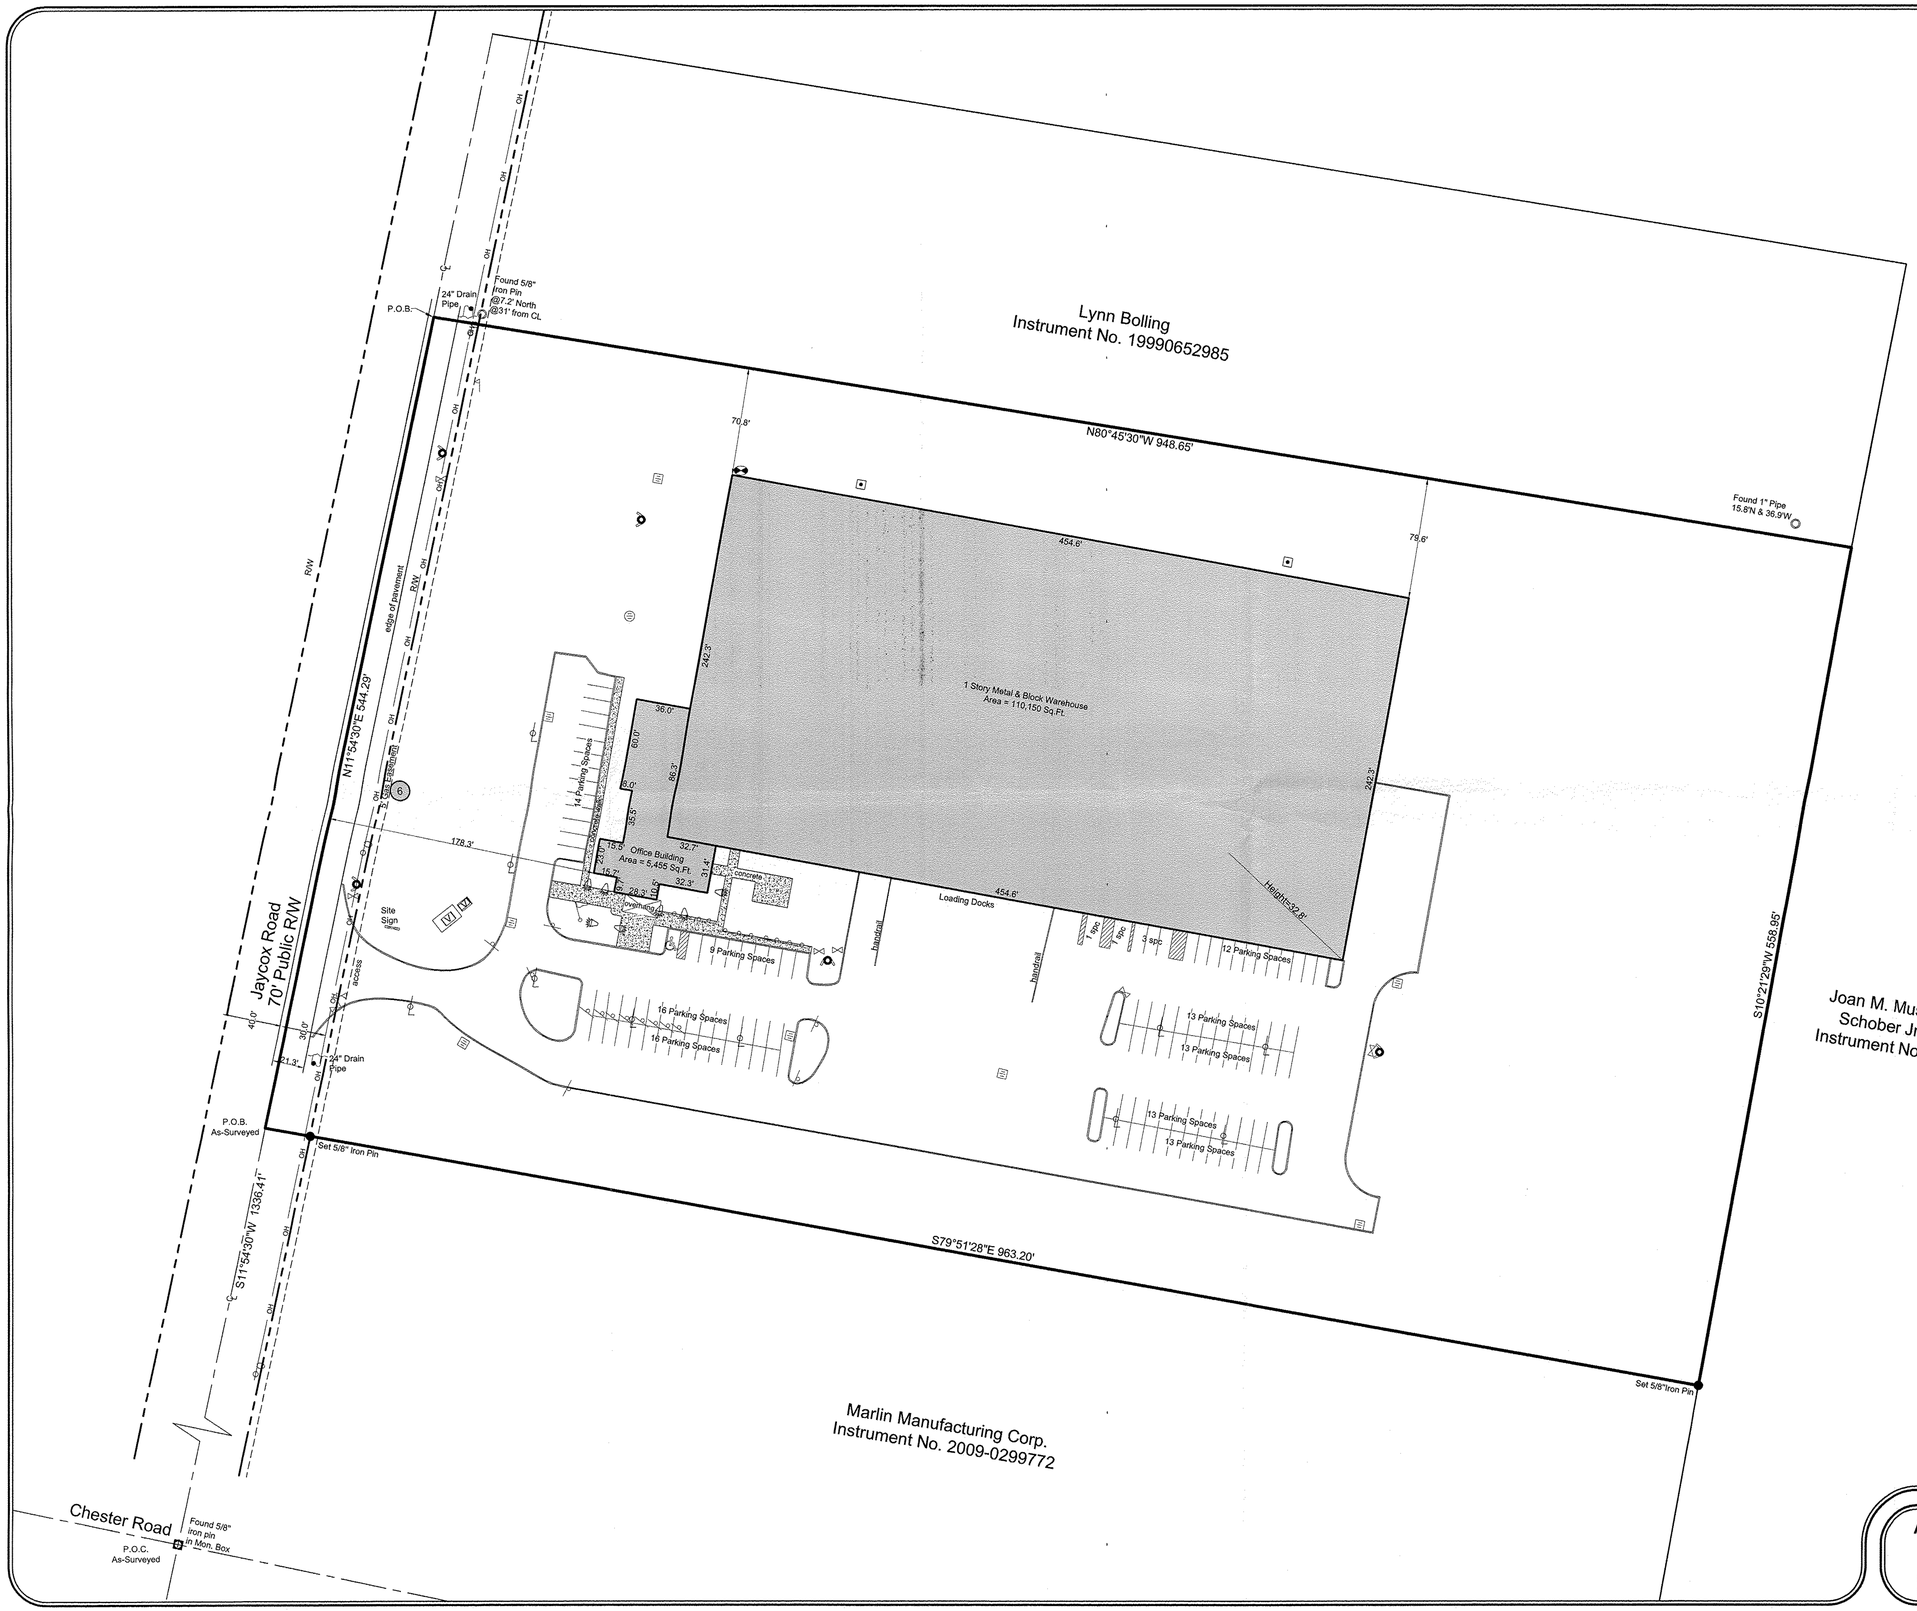

LEGEND OF SYMBOLS & ABBREVIATIONS

- Power Pole
- Light Pole
- Guy Wire
- Power Pole w/ Light
- Utility Pole
- Ground Light
- Electric Manhole
- Electric Meter
- Electric Vault
- Transformer
- Air Conditioner Unit
- Telephone Manhole
- Telephone Pedestal
- Cable Box
- Sight Light
- Set Iron Pin
- Found Iron Pin
- Found Concrete Monument
- Traffic Signal Box
- Signal Light Pole
- Signal Light
- Vault
- Sign (as Noted)
- Tower
- Monitoring Well
- Flag Pole
- Satellite Dish
- Water Valve
- Fire Hydrant
- Siamese Fire Hydrant
- Water Manhole
- Backflow Preventer
- Water Meter
- Well Head
- Sprinkler Head
- Found PK Nail
- Found Railroad Spike
- Sanitary Manhole
- Clean Out
- Gas Manhole
- Gas Valve
- Gas Meter
- Gas Line Marker
- Handicapped Parking
- Mailbox
- Bollard
- Storm Drain Manhole
- Storm Drain Inlet Square
- Storm Drain Inlet Round
- Storm Pipe
- Curb Storm Inlet
- Grease Trap
- R/W Right-of-Way
- Centerline

SCALE : 1" = 50'

0' 25' 50' 100'

APPROVED
REVISED
REVISED

DATE 12-19-11
PROJECT 400-021-C
BY R.MAINES
11-02408-D

Scan# 47174

Bock & Clark's National Surveyors Network
National Coordinators of ALTA/ACSM Land Title Surveys
537 North Cleveland-Massillon Road, Akron, Ohio 44333
Phone: (800) SURVEYS (787-8397), Fax: (330) 666-3606 www.bockandclark.com

ALTA/ACSM LAND TITLE SURVEY

PREPARED FOR:

Malt Properties Project

DATE: October 21, 2011

NETWORK PROJECT NO. 201101711-1

SHEET 2 OF 2

BOCK & CLARK
Commercial Real Estate
Due Diligence
EST. 1973