

# PLOT PLAN

JOB No


Surveyors & Land Planners

SUBLOT PARTS OF 5 & 6

SUBDIVISION WEST EDGE ESTATES NE. 1

OTHER

Split-06-24-002-000-080 # 7117

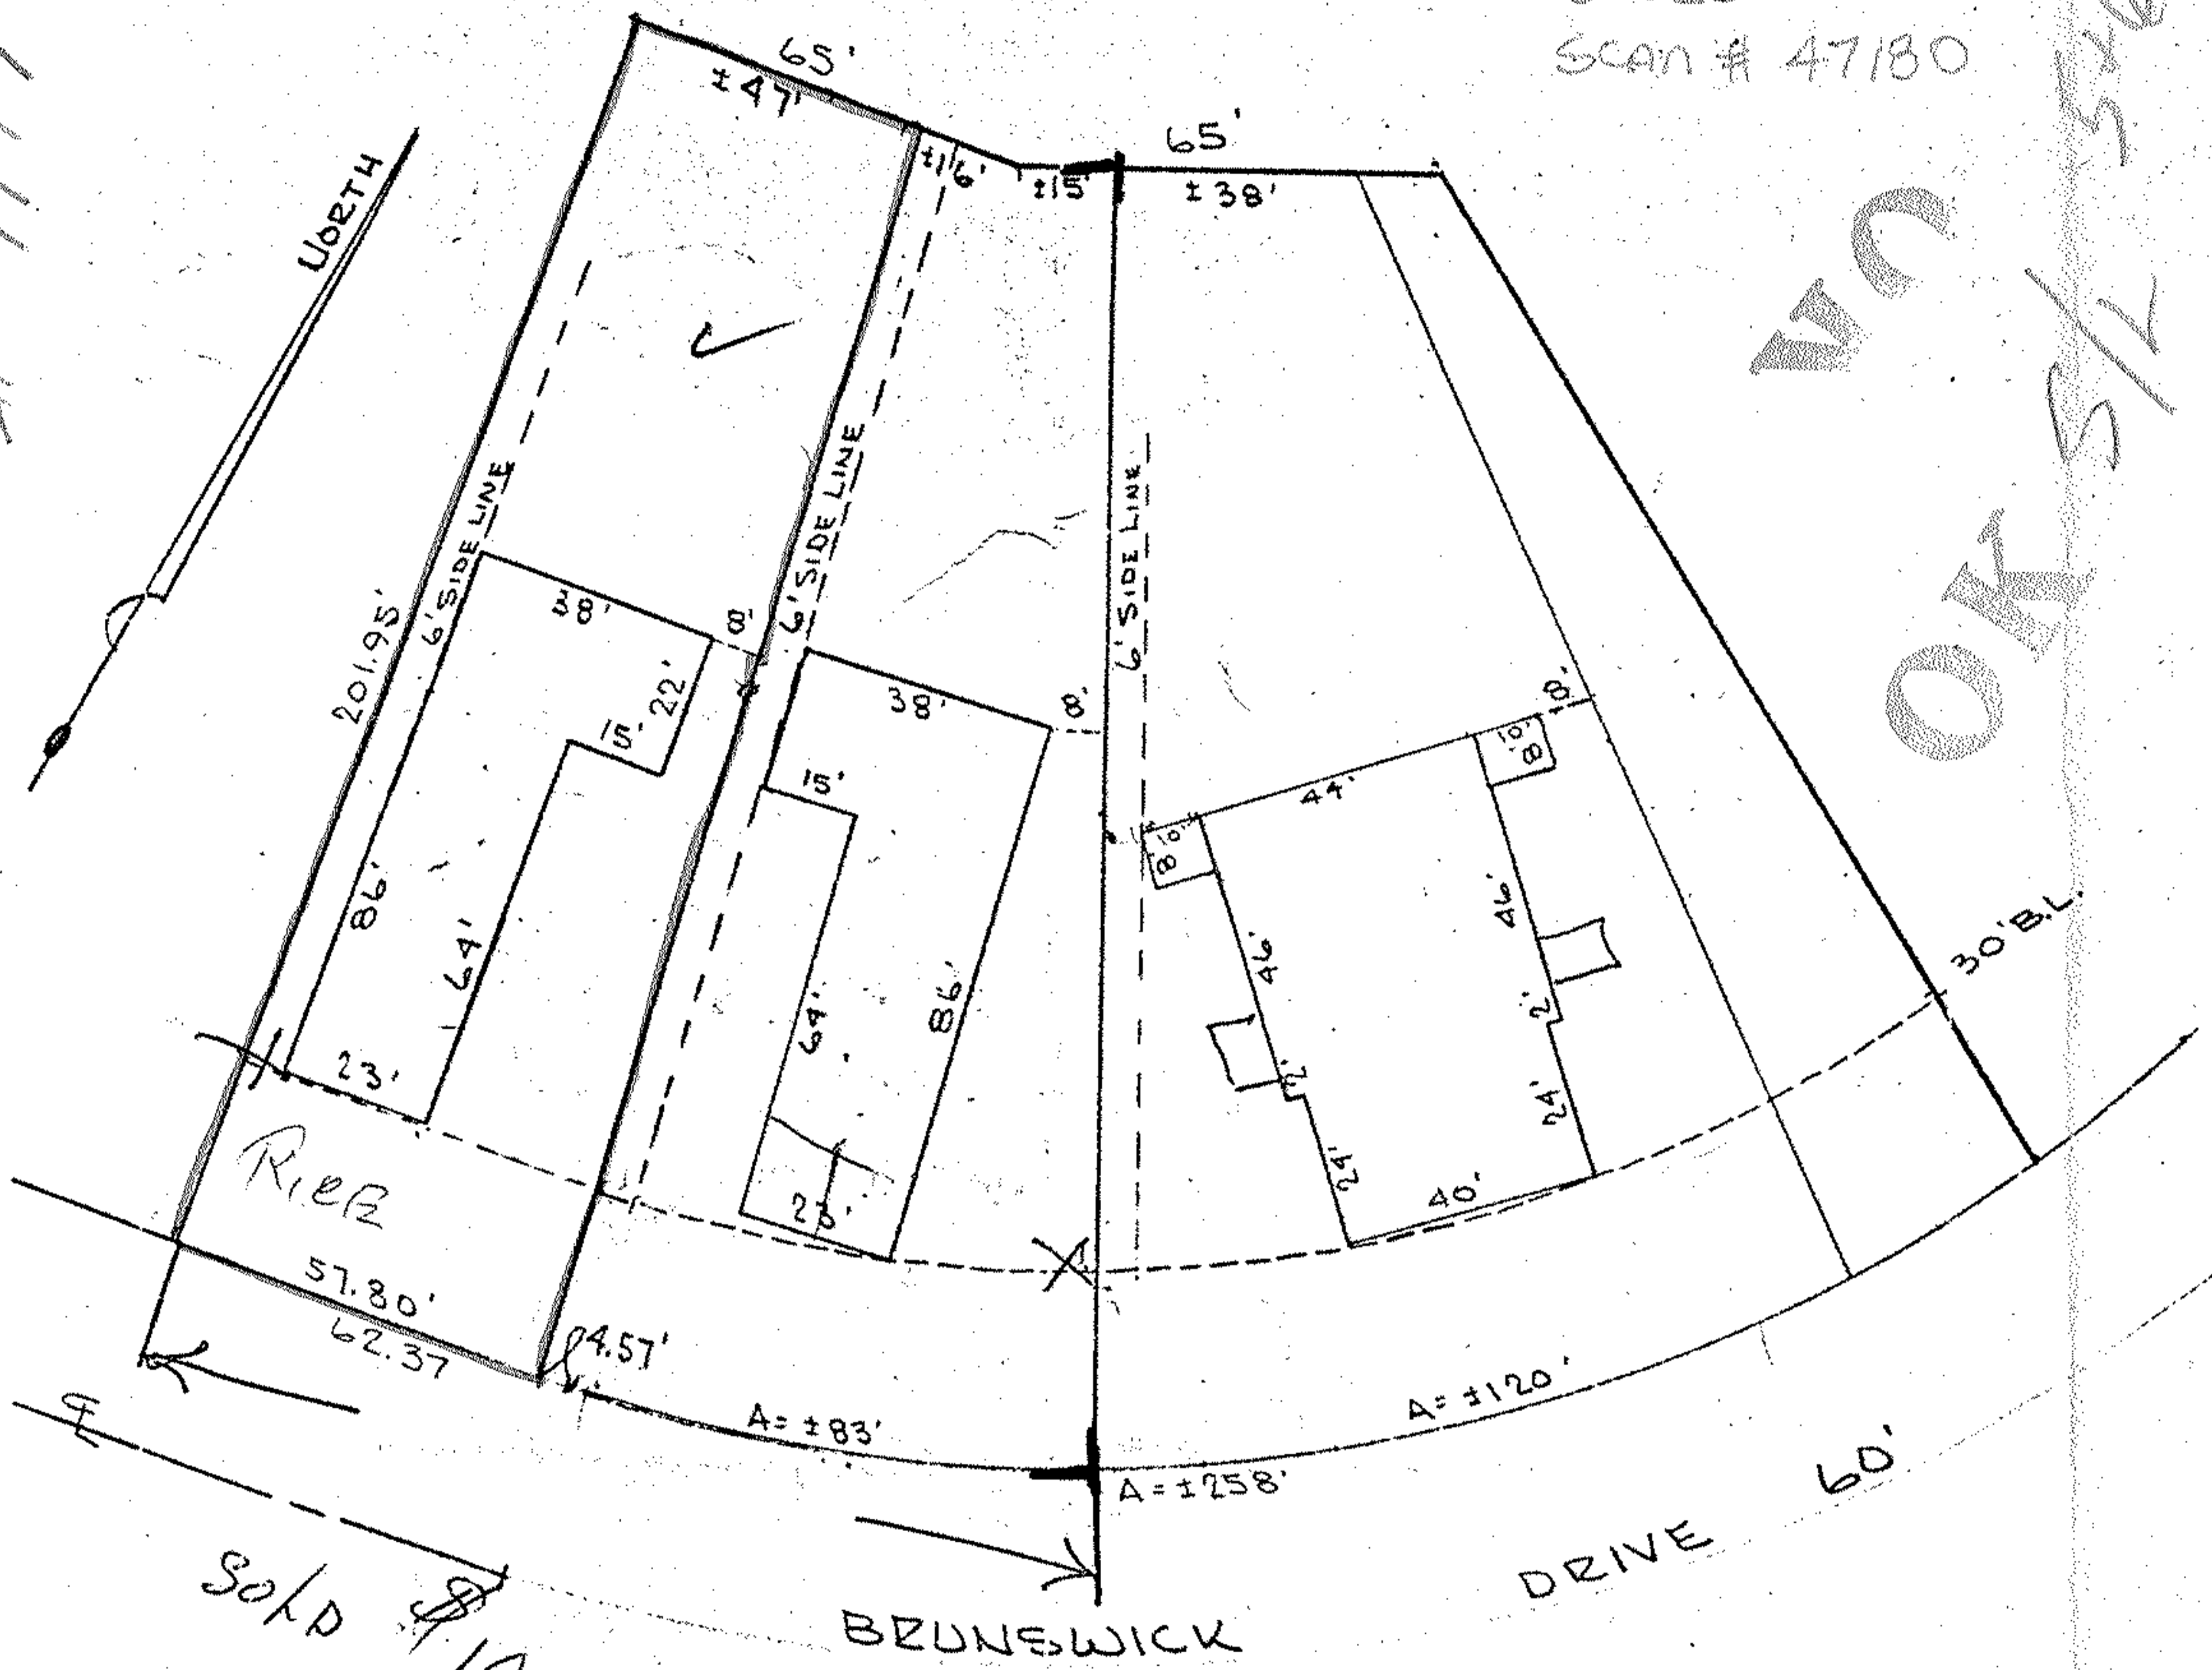

06-24-002-000-039-040  
6-128  
SCAN # 47180

NO OK S/L 3/6

Pg. 6-128

Sold \$10,000  
 5,000 ON FIRST LOT  
 4,000 TO BE PAID IN 6 MONTHS  
 500 EARNEST MONEY ON SECOND LOT  
 Ray B W.P. June

Prepared for: BIDINGER CONSTRUCTION

Scale: 1" = 40' Date: MARCH, 28, 1973