WILLIAM B. BARTON
REG. LAND SURVEYOR NO. 4438
388 PARKWOOD AVENUE
AVON LAKE, OHIO 44012
TELEPHONE (216) 933-6662

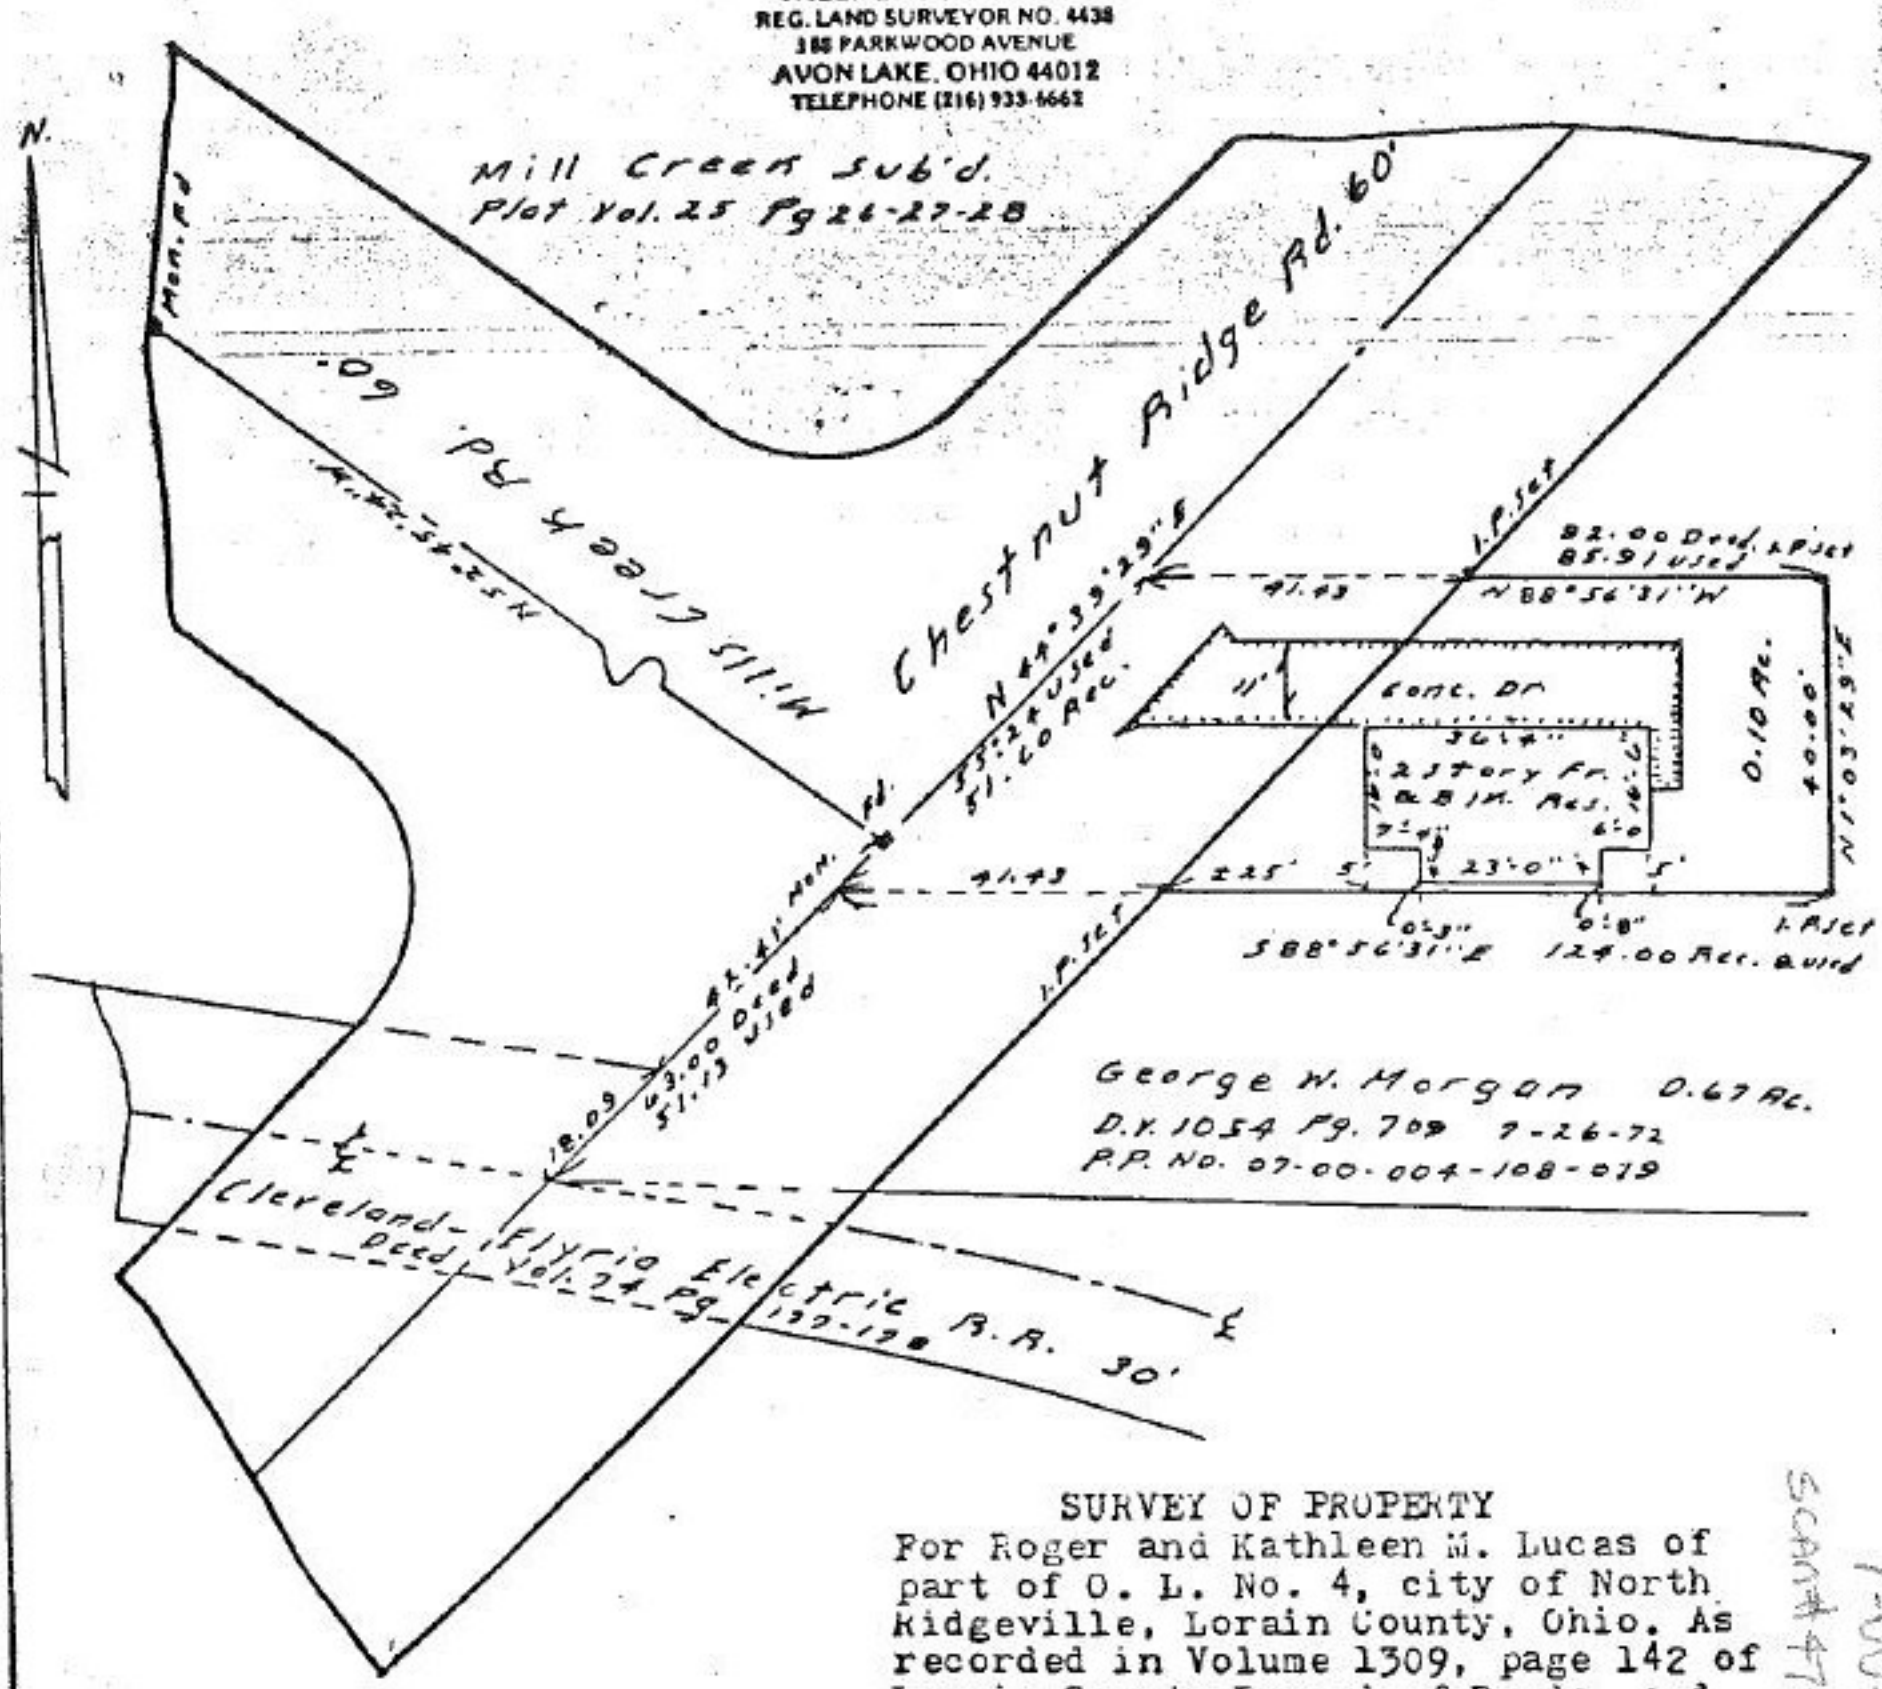

SURVEY OF PROPERTY
For Roger and Kathleen M. Lucas of part of O. L. No. 4, city of North Ridgeville, Lorain County, Ohio. As recorded in Volume 1309, page 142 of Lorain County Record of Deeds, and being P. P. No. 07-00-004-108-020.
Scale 1"=30' June 23, 1984.

NOTE: The southerly line of the above property was set by oral agreement with Mr. George W. Morgan, it being his belief that the part of the existing building being of concrete block construction is the same building known as the Chestnut Ridge Sub-station, as referred to in Volume 1309, page 142 of Lorain Co. Record of Deeds, now owned by Roger and Kathleen M. Lucas.

STATE OF OHIO
WILLIAM B. BARTON
4438
REGISTERED SURVEYOR
3-032

Scan 47217
7-00-004-B
07-00-004-108-020