MICHAEL G. HURA

REGISTERED SURVEYOR
#12706 R.D. 2 MASON RD. VERMILION, OHIO 44089
PHONE 965-4040

03-00-059-000-029
03-00-060-000-029
03-00-254-00
060-6

Scan # 47218

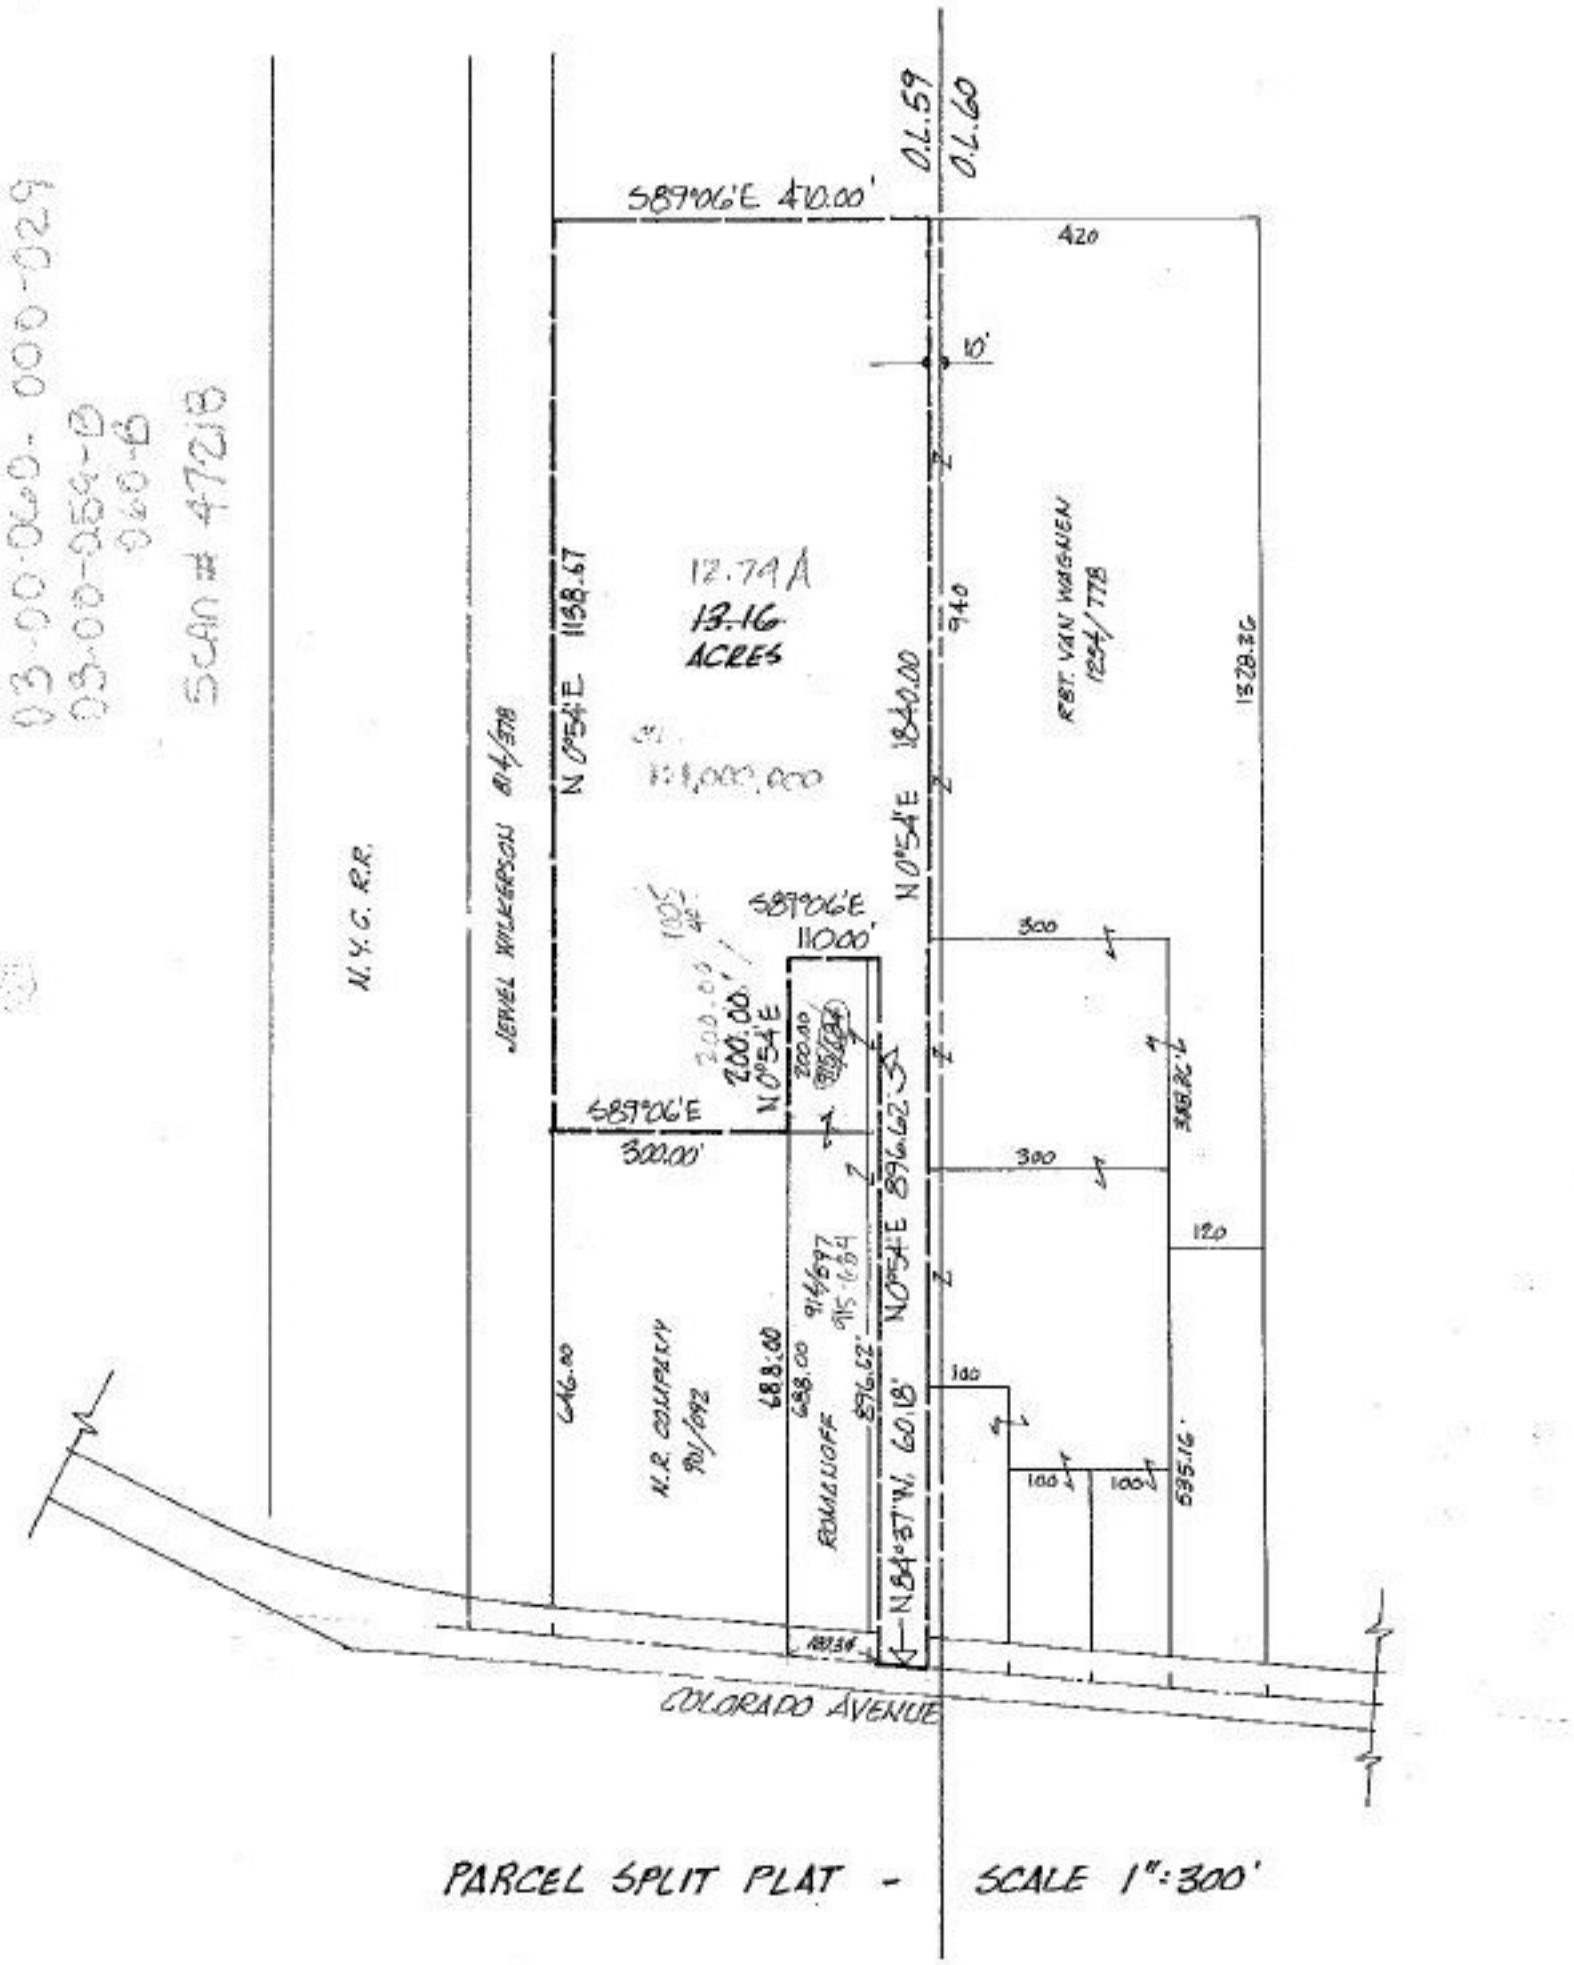

PARCEL SPLIT PLAT - SCALE 1":300'