ap of Part of Lot 7 Tract 14 Henrietta Twp. Lorain Co. Ohio
y Arnold F.. Koepp Reg. Surveyor Survey Sept. 1983

08-14-007-000-007
8-B
SCAN # 47223

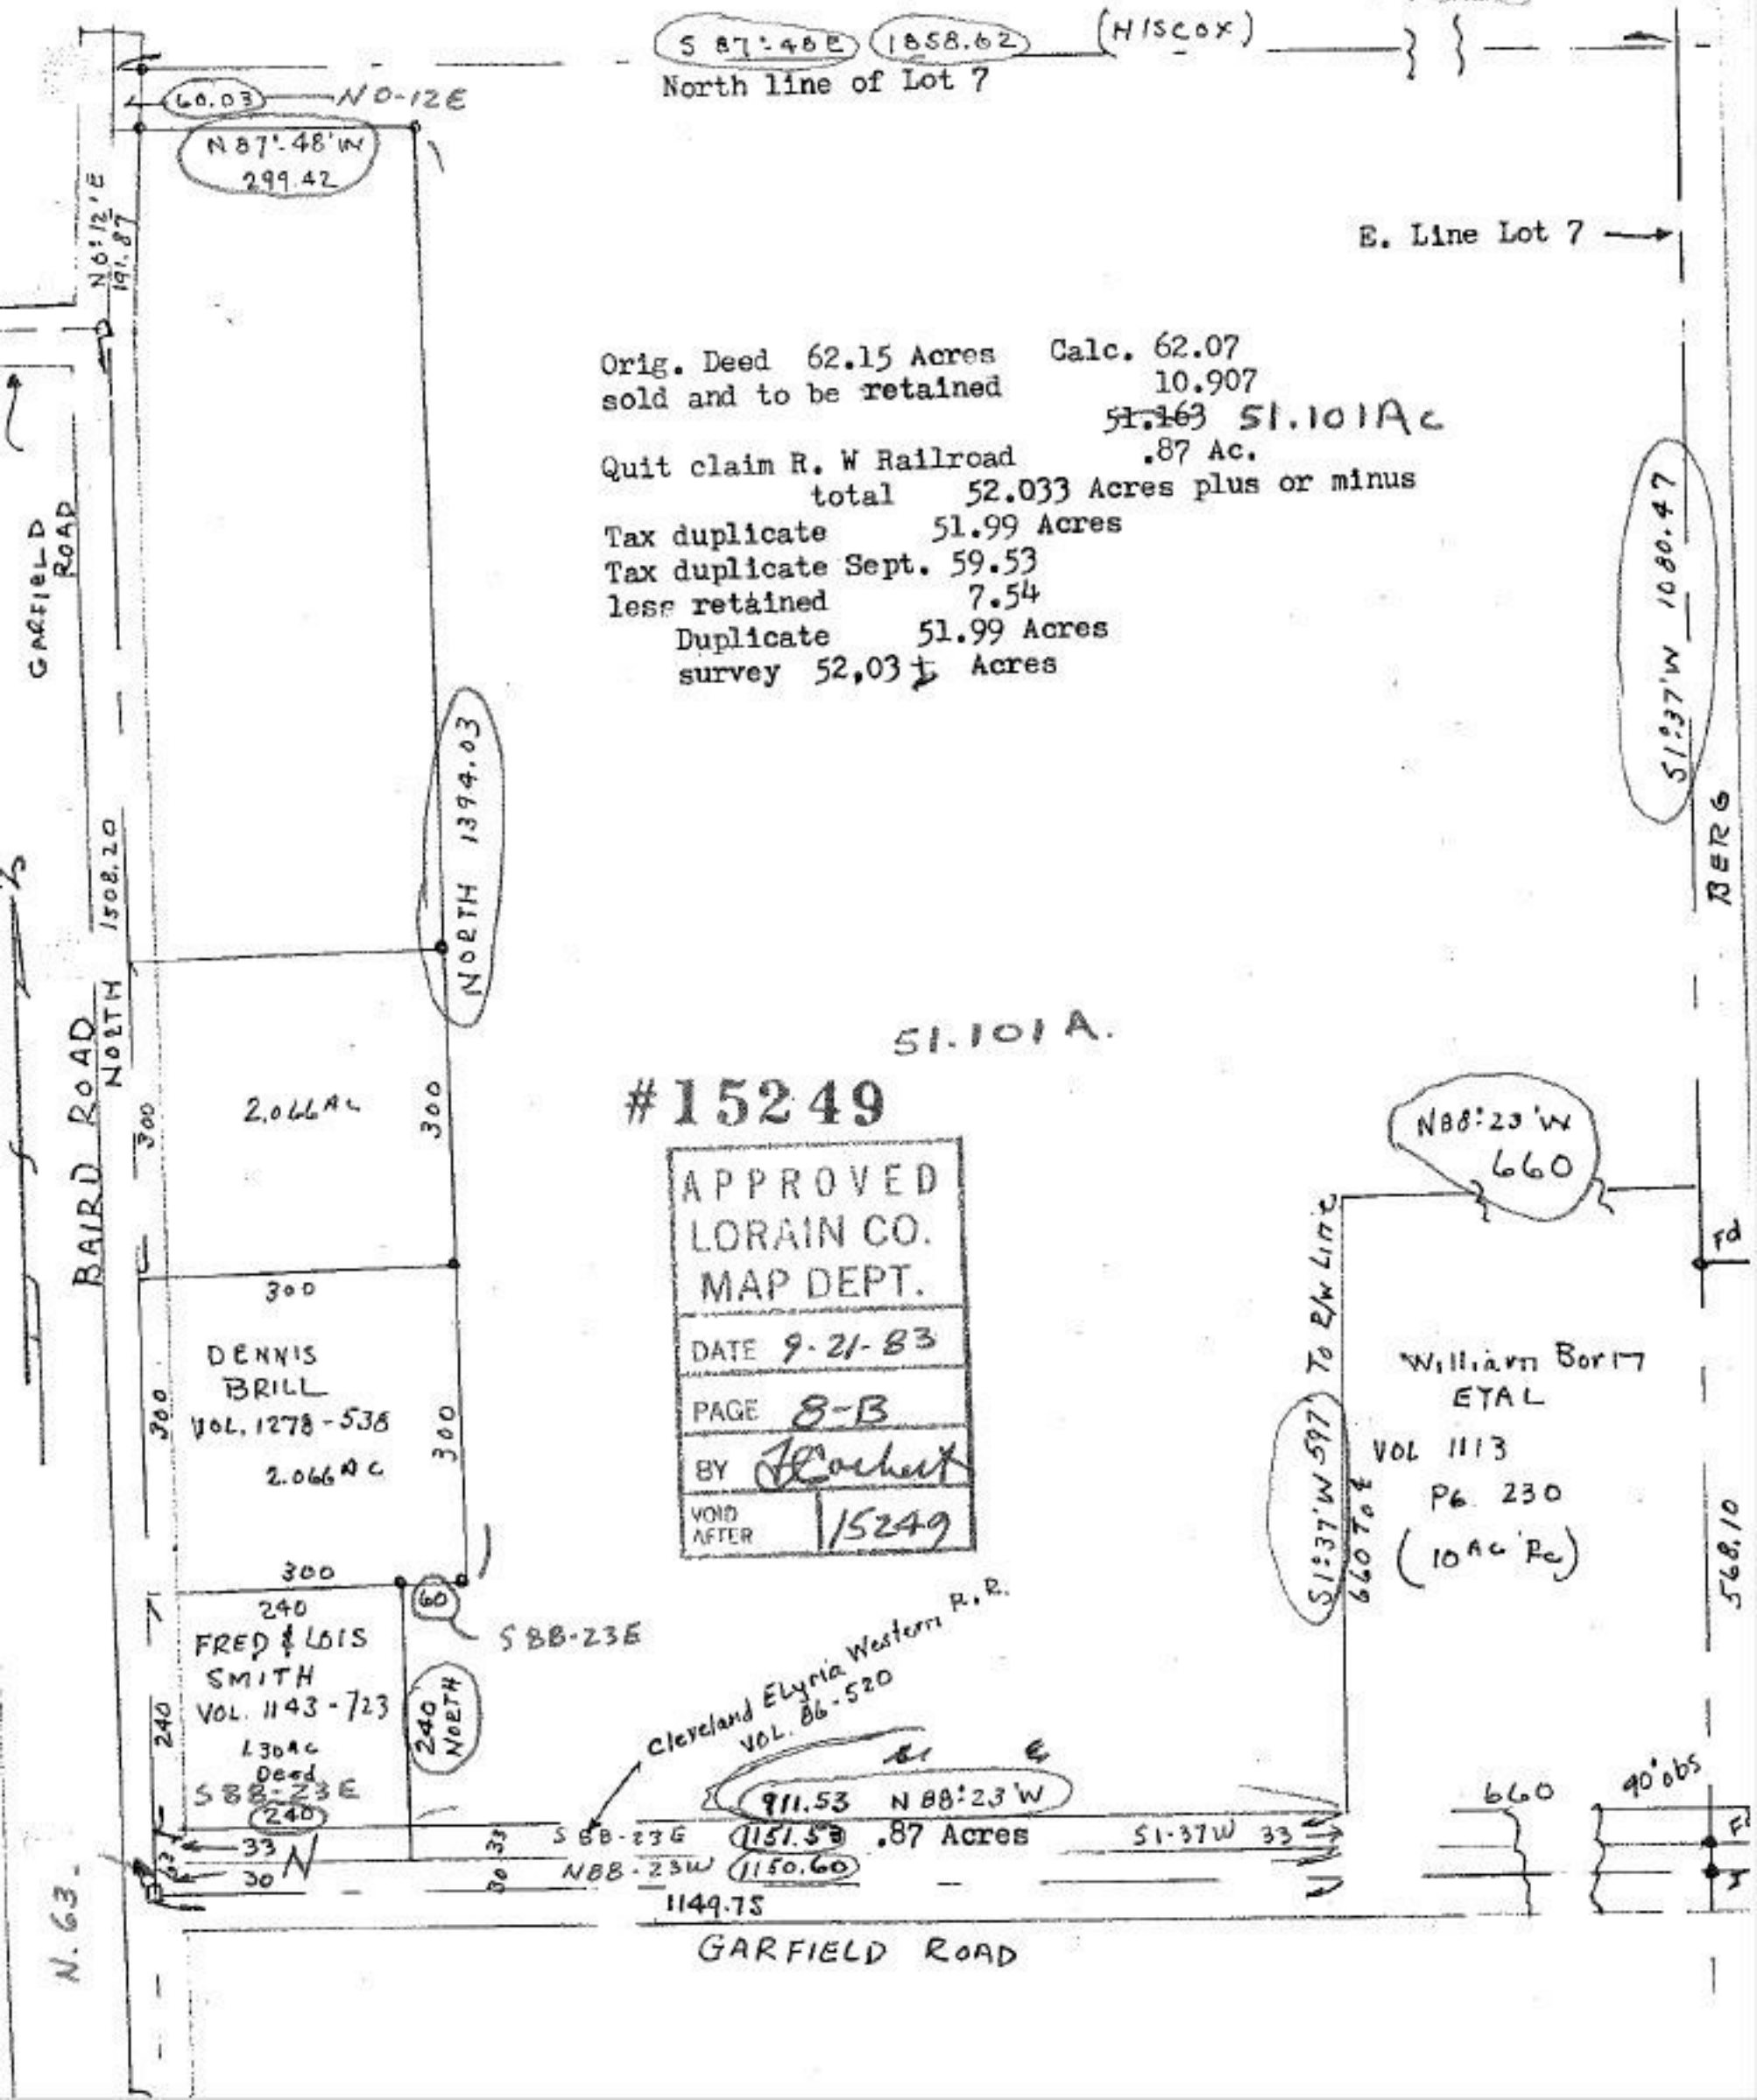

Orig. Deed 62.15 Acres Calc. 62.07
sold and to be retained 10.907
~~51.163~~ 51.101 Ac

Quit claim R. W Railroad .87 Ac.
total 52.033 Acres plus or minus

Tax duplicate 51.99 Acres
Tax duplicate Sept. 59.53
less retained 7.54
Duplicate 51.99 Acres
survey 52,03 ± Acres

#15249

APPROVED
LORAIN CO.
MAP DEPT.
DATE 9-21-83
PAGE 8-B
BY [signature]
VOID AFTER 15249