ORIG SURVEY
NOTES 1984
C.E.P LVIC. D.P.

Map of Part of Lot 3 Tract 13 Henrietta Twp. Lorain Co. Ohio
Scale 1" = 200'
April 2, 1980 By Arnold F. Koepp Reg. Surveyor No. 4368

#13545
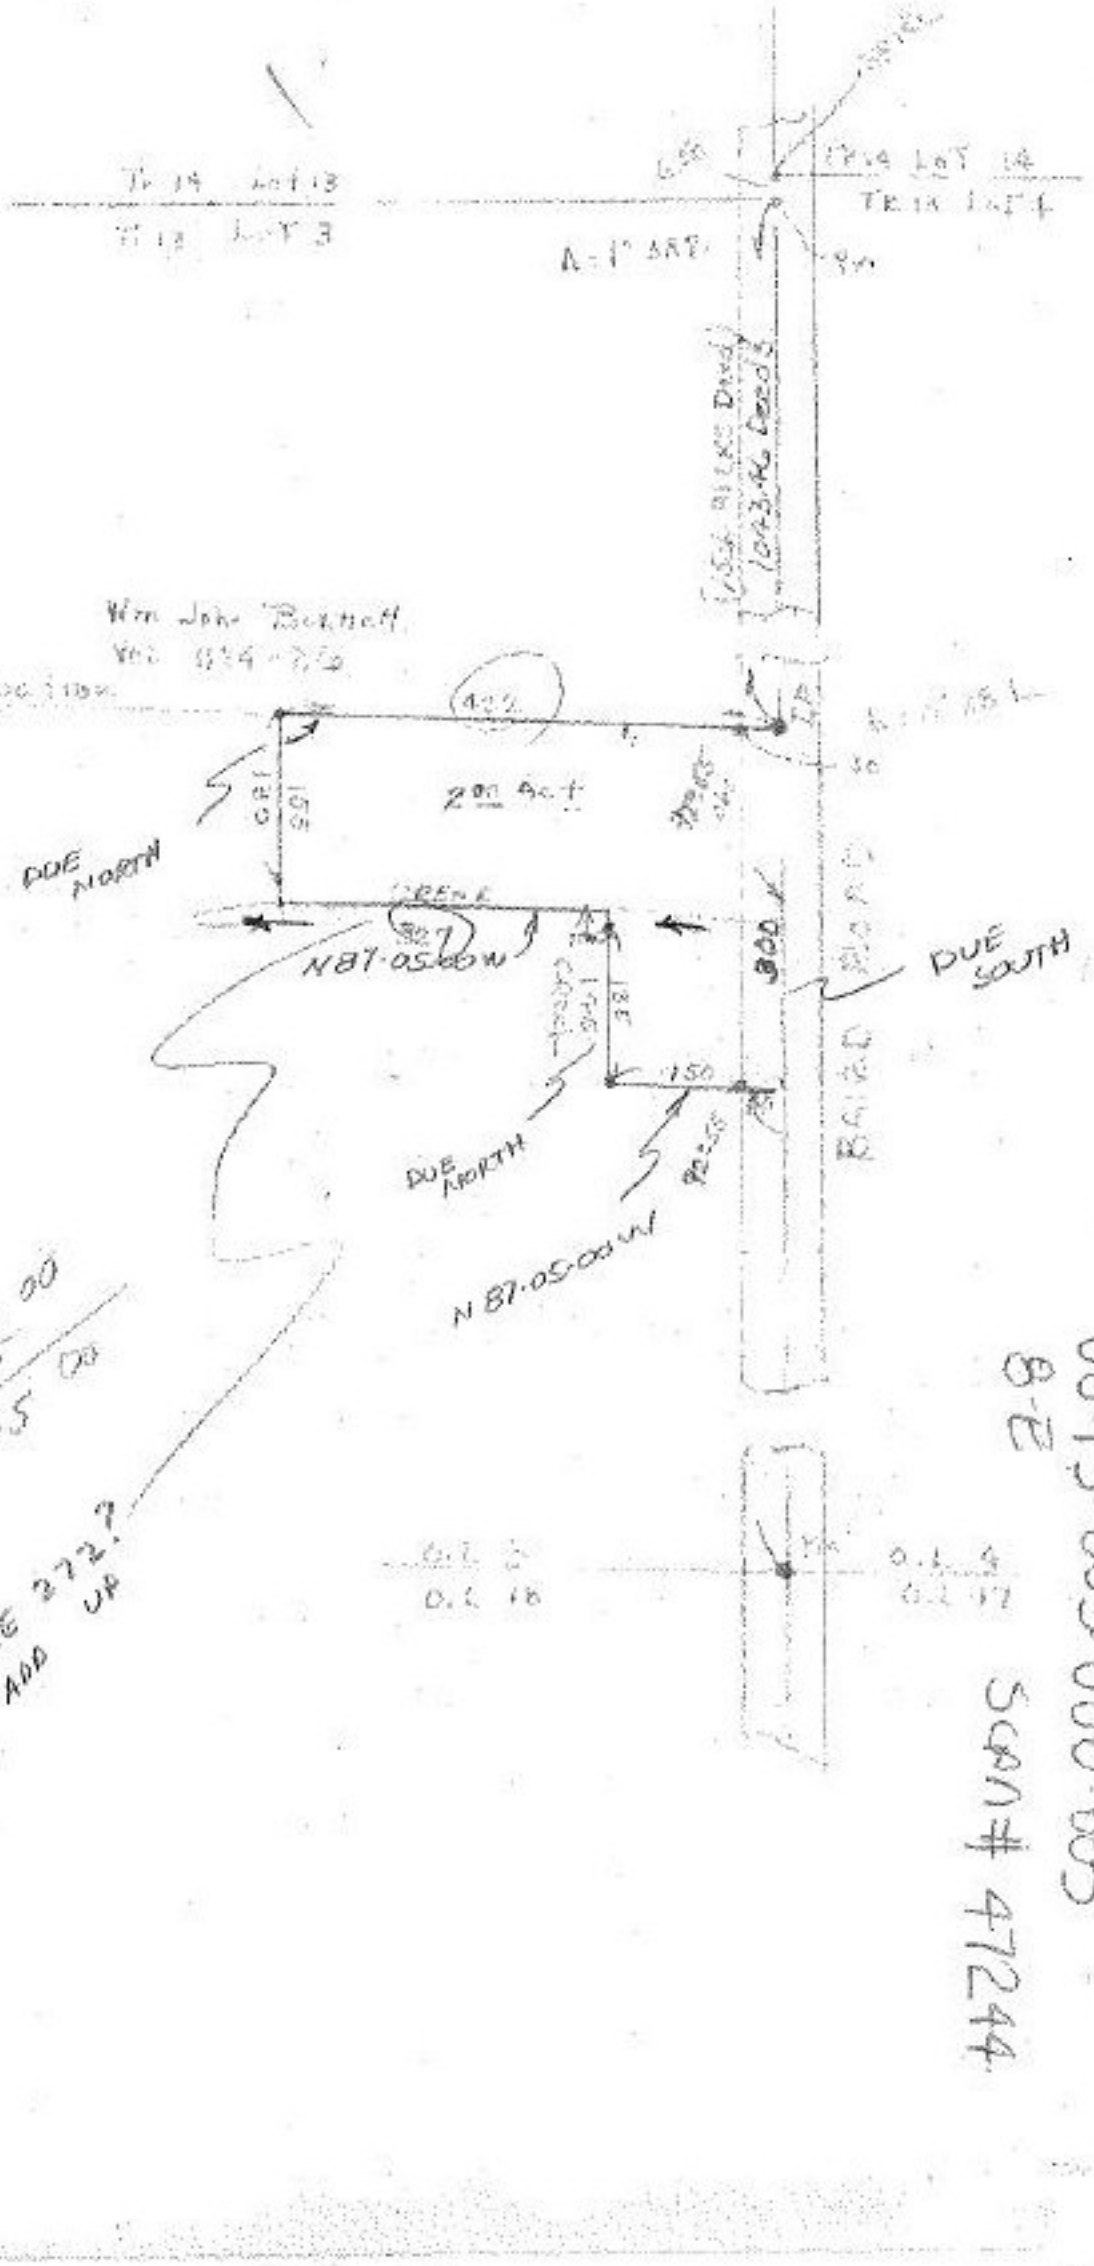
APPROVED
LORAIN CO.
MAP DEPT.
DATE 5-1-80
PAGE 8-E
BY T. McMain
VOID AFTER