
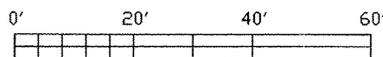



STATE OF OHIO,
 COUNTY OF LORAIN,
 TOWNSHIP OF SHEFFIELD,
 ORIGINAL LOT NO. 107

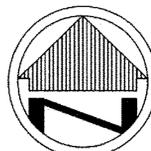

SCALE: 1"=20'


APPROVED
 LORAIN CO.
 MAP DEPT
 DATE 8-22-12
 PAGE 3-00-107-B
 BY R. MAINES
 #12-02559-D

SCAN #47260

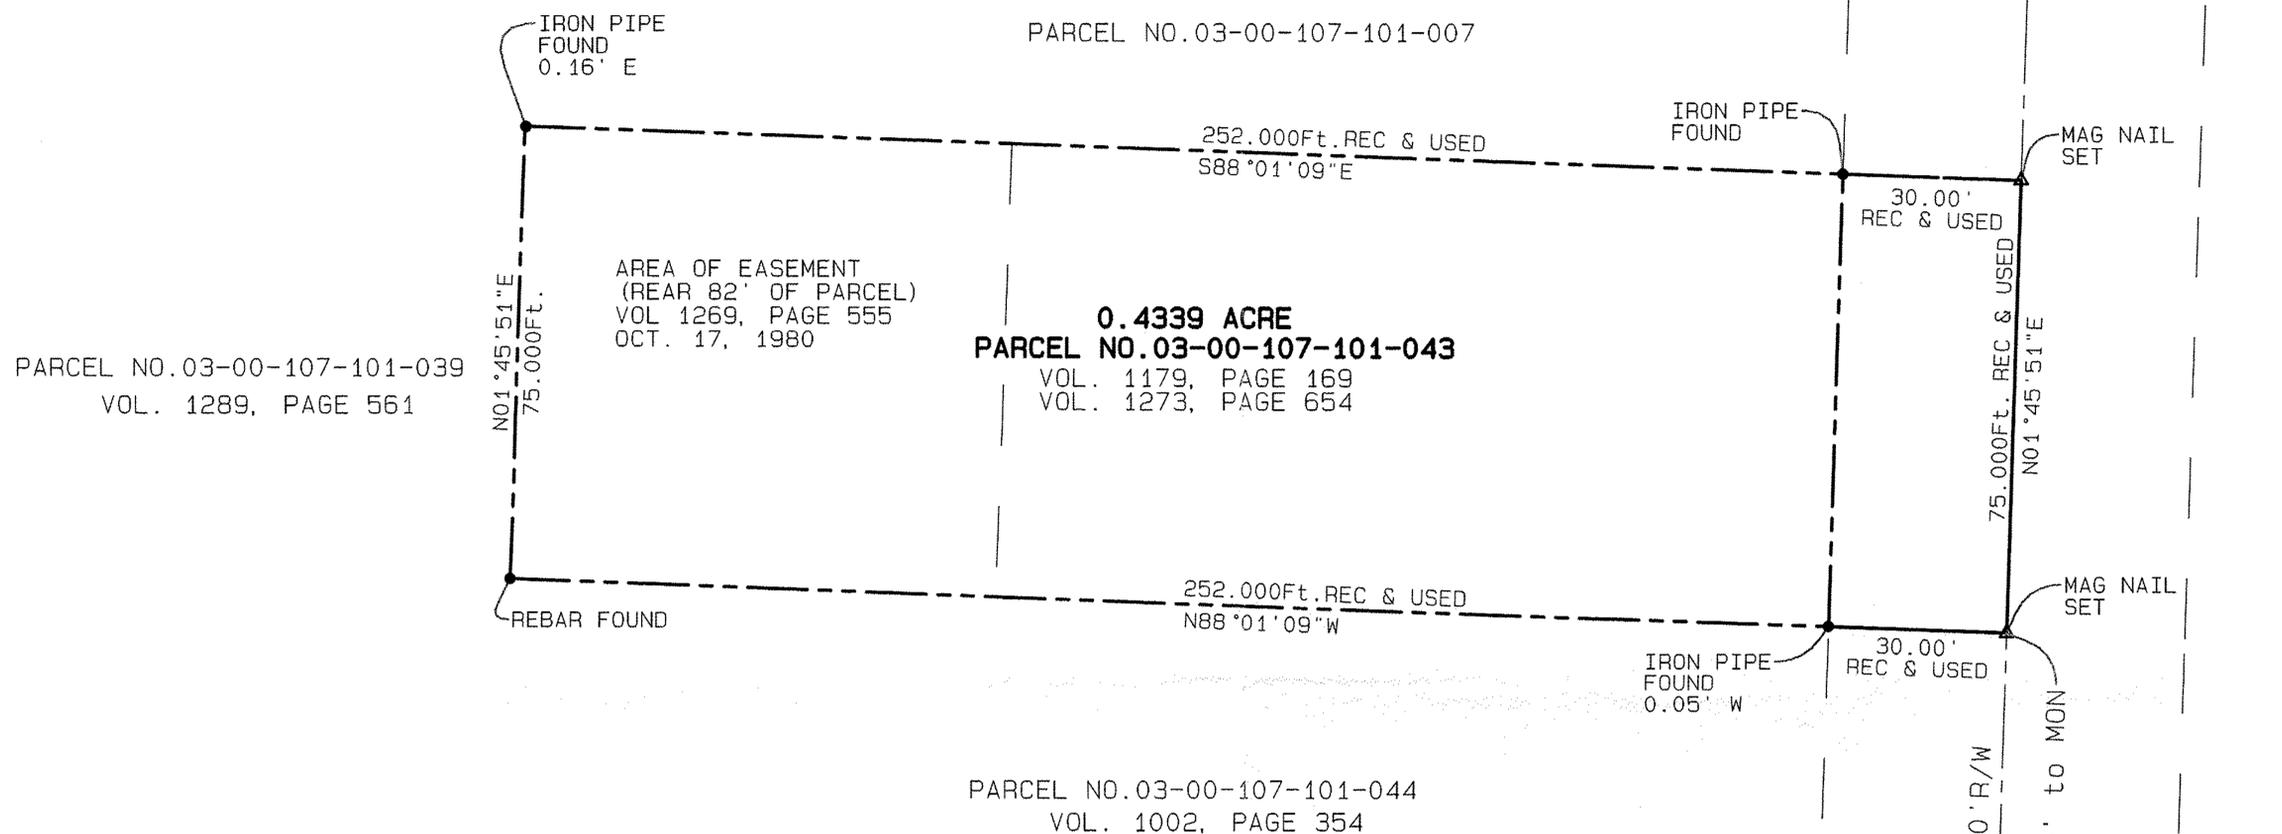

BASIS OF BEARING:
 THE BASIS OF BEARING
 FOR THIS SURVEY IS
 N 1°-45'-51"E AS THE
 CENTERLINE OF DUNTON ROAD
 OHIO NORTH ZONE 3401, NAD 88

LEGEND	
REC. - RECORD DISTANCE OR ANGLE	
OBS. - FIELD OBSERVED DISTANCE OR ANGLE	
CALC. - CALCULATED DISTANCE OR ANGLE	
■ - MONUMENT BOX	
○ - MONUMENT FOUND, SIZE & TYPE AS INDICATED.	
—X— - FENCE	
▲ - MAG NAIL SET	

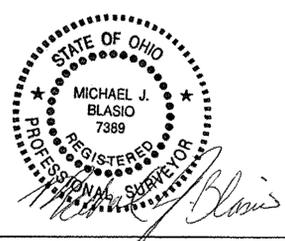

MICHAEL J. BLASIO, P.S. #7389

CERTIFICATION
 To: Time Warner NY Cable, LLC, Old Republic National Title Insurance Company, and Jancura & Associates,
 This is to certify that this map & survey on which it is based were made in accordance with the Ohio Administrative Code Chapter 4733-37, and that Parcel no. 03-00-107-101-043 is one in the same as the property described in Commitment Number 14754 prepared by Old Republic National Title Insurance Company. The field work was completed on August 13, 2012 under the direct supervision of Michael J. Blasio, P.S.

NOTE: DIMENSIONS SHOWN HEREON ARE GIVEN IN FEET AND DECIMAL PARTS THEREOF.

DATE	REVISIONS

BOUNDARY RETRACEMENT SURVEY
 4138 DUNTON ROAD
 SHEFFIELD TOWNSHIP, OH 44055

6775 SKYLANE STREET NW
 NORTH CANTON, OH 44720
 330-324-9999 (Phone)
TERRA LOGIC INC

DATE:
 AUGUST 13, 2012
 SHEET 1 OF 1