Plat of Survey
State of Ohio
County of Lorain
part of O.L. 77
Eaton TWP
5.0206 acre split "Parcel A" from
PP # 11-00-077-000-087
Current Title - INST 20000669979
in the name of Henry Yost & Denise R. Yost

Legend

- ○ iron pin or pipe found as noted
- ● 5/8" rebar w/ "Rafter A. LTD" cap set
- • Mag Nail set
- ⊠ Mon. Box w/ Brass Capped Pin
- —x—x— fence line
- C indirect measurement - radial or GPS
- R recorded distance or deflection

Rafter A. LTD
Land Surveying & Engineering
10980 LaGrange Road
Elyria, OH 44035
440-309-5275

03088
APPROVED
LORAIN CO.
MAP DEPT
DATE 10-19-12
PAGE 11-00-077A
BY JHatfield
#12-03088

Survey made at the request of Henry Yost

Survey performed on Sept. 19,20 & 21 in 2012 under direct field supervision of Richard A. Fredrickson, P.S.

Basis of Bearing is derived from Ohio State Plane Coordinates, NAD 83, North Zone (3401) obtained from GPS obersvations made on the survey site

STATE OF OHIO
RICHARD A. FREDRICKSON
S-8285
REGISTERED
PROFESSIONAL SURVEYOR
9-25-2012

References Used

recordings listed hereon

Plat of Survey by McGlinchy & Associates for Darlton Yost - 1980
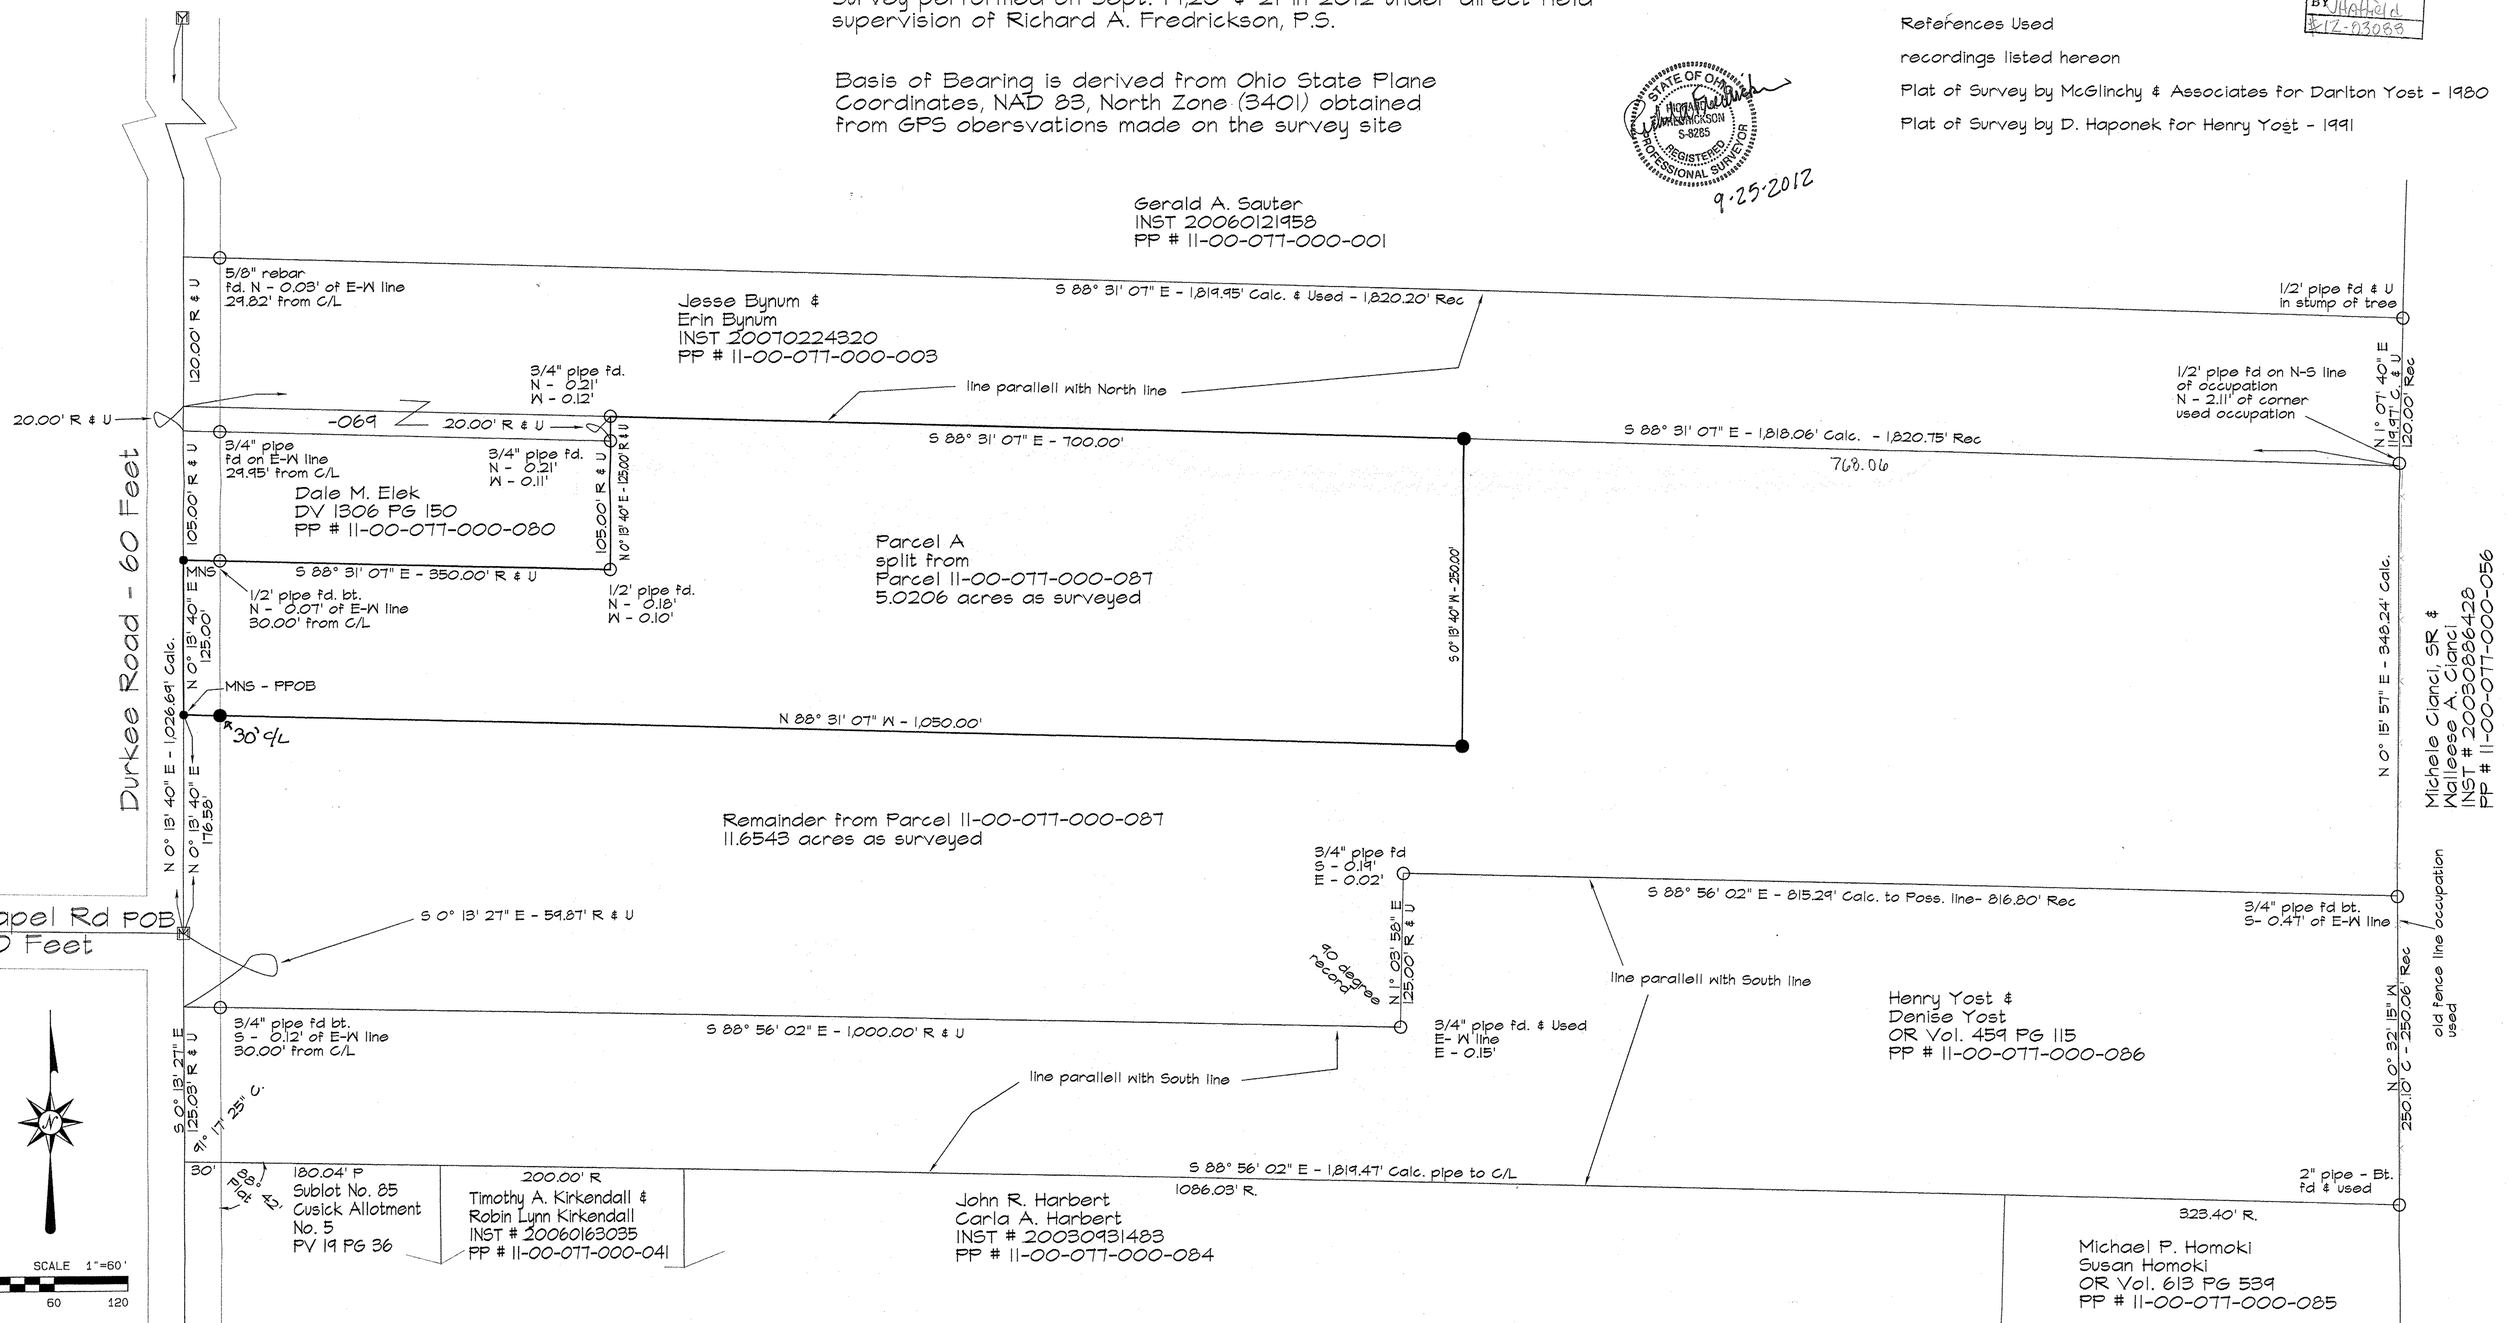
Plat of Survey by D. Haponek for Henry Yost - 1991