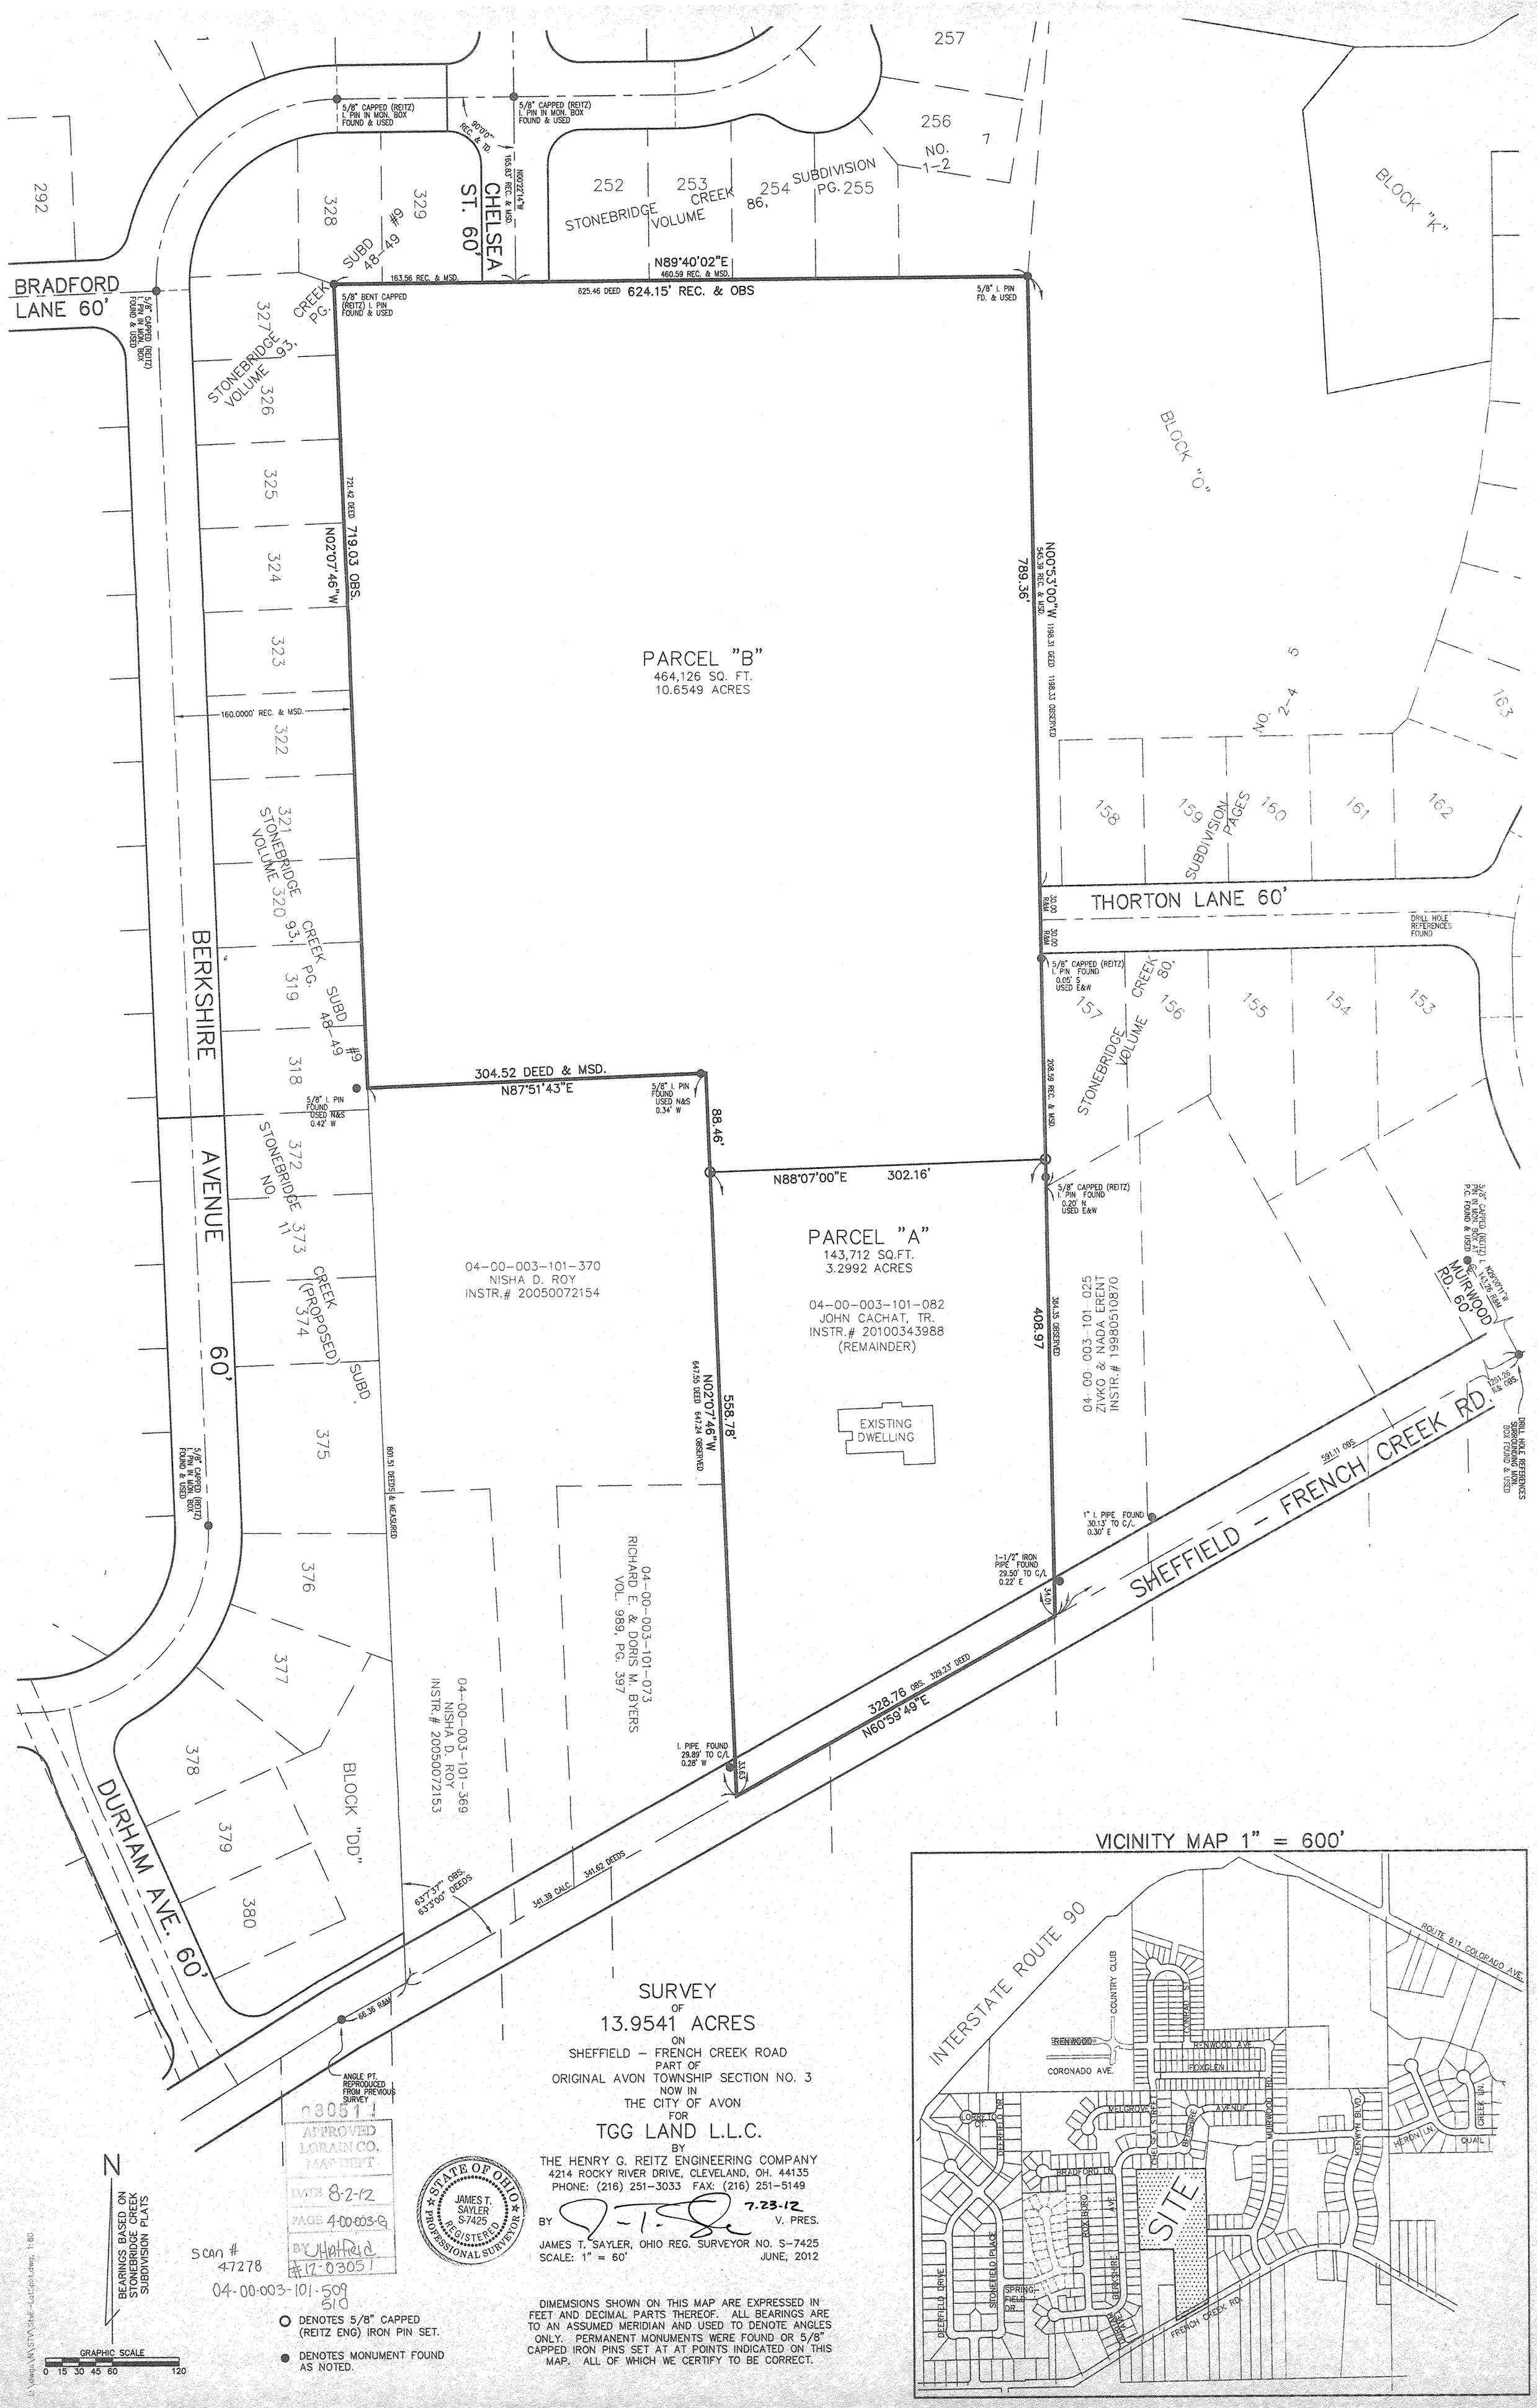

SURVEY
OF
13.9541 ACRES
ON
SHEFFIELD – FRENCH CREEK ROAD
PART OF
ORIGINAL AVON TOWNSHIP SECTION NO. 3
NOW IN
THE CITY OF AVON
FOR
TGG LAND L.L.C.

BY
THE HENRY G. REITZ ENGINEERING COMPANY
4214 ROCKY RIVER DRIVE, CLEVELAND, OH. 44135
PHONE: (216) 251-3033 FAX: (216) 251-5149

BY 7-23-12 V. PRES.

JAMES T. SAYLER, OHIO REG. SURVEYOR NO. S-7425
SCALE: 1" = 60' JUNE, 2012

DIMENSIONS SHOWN ON THIS MAP ARE EXPRESSED IN FEET AND DECIMAL PARTS THEREOF. ALL BEARINGS ARE TO AN ASSUMED MERIDIAN AND USED TO DENOTE ANGLES ONLY. PERMANENT MONUMENTS WERE FOUND OR 5/8" CAPPED IRON PINS SET AT AT POINTS INDICATED ON THIS MAP. ALL OF WHICH WE CERTIFY TO BE CORRECT.