Plat of Survey
State of Ohio
County of Lorain
TWP of Columbia
Part of O.L. No. 4
comination of
PP # 12-00-004-000-031 &
PP # 12-00-004-000-032
2.1907 acres as surveyed

Rafter A. LTD
10980 Lagrange Road
Elyria, OH 44035
PH 440-309-5275
FAX 440-458-6294

survey made at request of
Brian & Nicole Mikolak

Legend

- o iron pin or pipe found as shown
- ● 5/8" rebar set - cap "Fredrickson S -8285"
- C indirect measurement - GPS or radially
- R record
- SR survey record

references

recordings listed hereon

Plat of Survey - G Penfound for D. Hauck - 1978

Plat of unrecorded subdivision - Andrew Bradnan by Slabe and Mackay - 1975

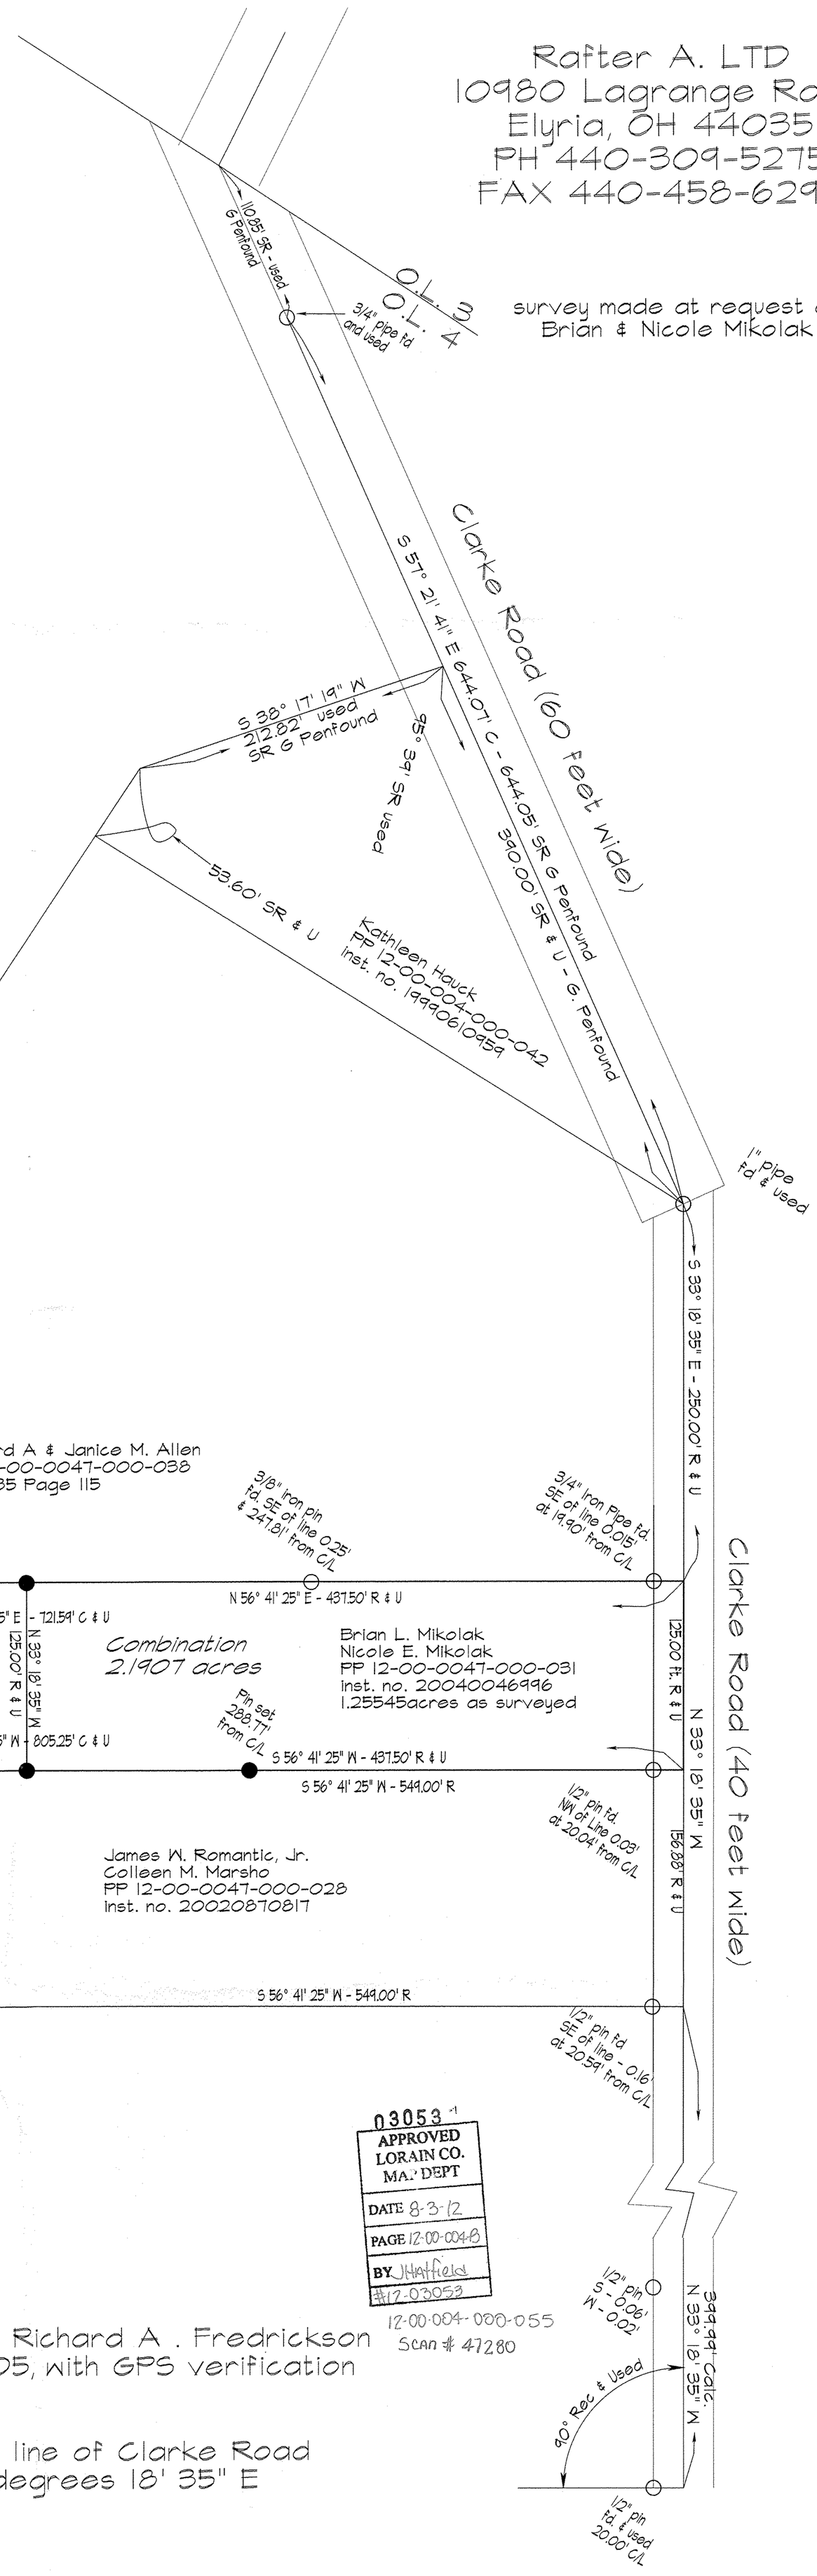

STATE OF OHIO
RICHARD A. FREDRICKSON
S-8285
REGISTERED
PROFESSIONAL SURVEYOR
6-22-12

03053
APPROVED
LORAIN CO.
MAP DEPT
DATE 8-3-12
PAGE 12-00-004-B
BY JHatfield
#12-03053

12-00-004-000-055
SCAN # 47280

Field Survey performed by Richard A . Fredrickson
on June 26 & June 29, 2005, with GPS verification
on June 14, 2012

Basis of Bearing is center line of Clarke Road
at 40' ROW section S 33 degrees 18' 35" E
as shown hereon

SCALE 1"=50'
0 50 100