FILE 4127

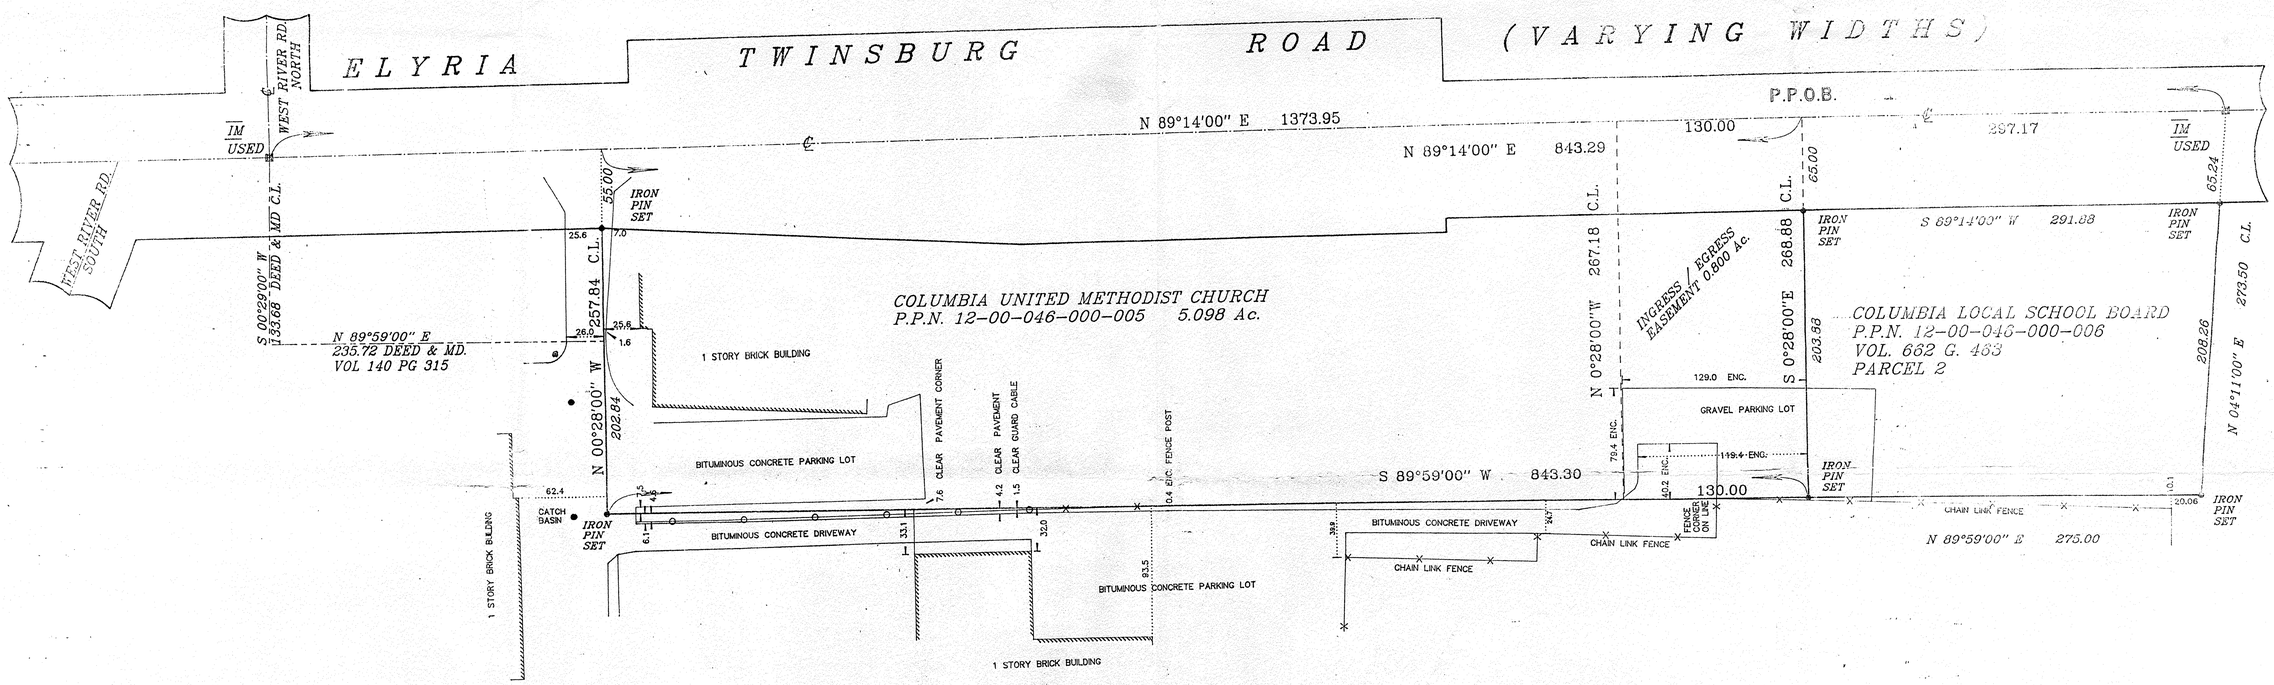

PLAT OF SURVEY FOR

COLUMBIA LSD BOARD OF EDUCATION

14168 STATE ROUTE 82

OF LINES ADJOINING P.P.N. 12-00-046-000-005

OF PART OF ORIGINAL COLUMBIA TWP. LOT 46 NOW IN THE TOWNSHIP OF COLUMBIA, COUNTY OF LORAIN, STATE OF OHIO.

SEPTEMBER 2003 SCALE 1" = 50'

REV. SEP. 1 2004

I HAVE PERFORMED A TRUE & ACCURATE SURVEY ON THE GROUND OF THE REAL PROPERTY SHOWN HEREON. DISTANCES SHOWN HEREON ARE IN FEET AND DECIMAL PARTS THEREOF, BEARINGS ARE TO AN ASSUMED MERIDIAN, IRON PINS WERE SET AT ALL POINTS MARKED THUS ✦, ALL OF WHICH I CERTIFY TO BE CORRECT.

ERIC J. NELSON P.S.

GILES NELSON & ASSOC. INC.
CIVIL ENGINEERING & SURVEYING CO.
12210 EATON COMMERCE PKWY. - #2
COLUMBIA STA. OHIO 44028
PHONE 440 748 0400 FX 0413

STATE OF OHIO ERIC J. NELSON 7049 REGISTERED SURVEYOR