APPROVED
LORAIN CO.
MAP DEPT

DATE 12-3-12

PAGE 9-F

BY R. MAINES

#12-02628-D

09-00-102-000-006

Scan # 47318

Plat of Survey

Marion Gordon

New Russia Twp.
Lorain Co.

O.L. 102
Ohio

Carlson Surveys

Job: 901-22R
April 2011

STATE OF OHIO
RICHARD D. CARLSON
REGISTERED SURVEYOR

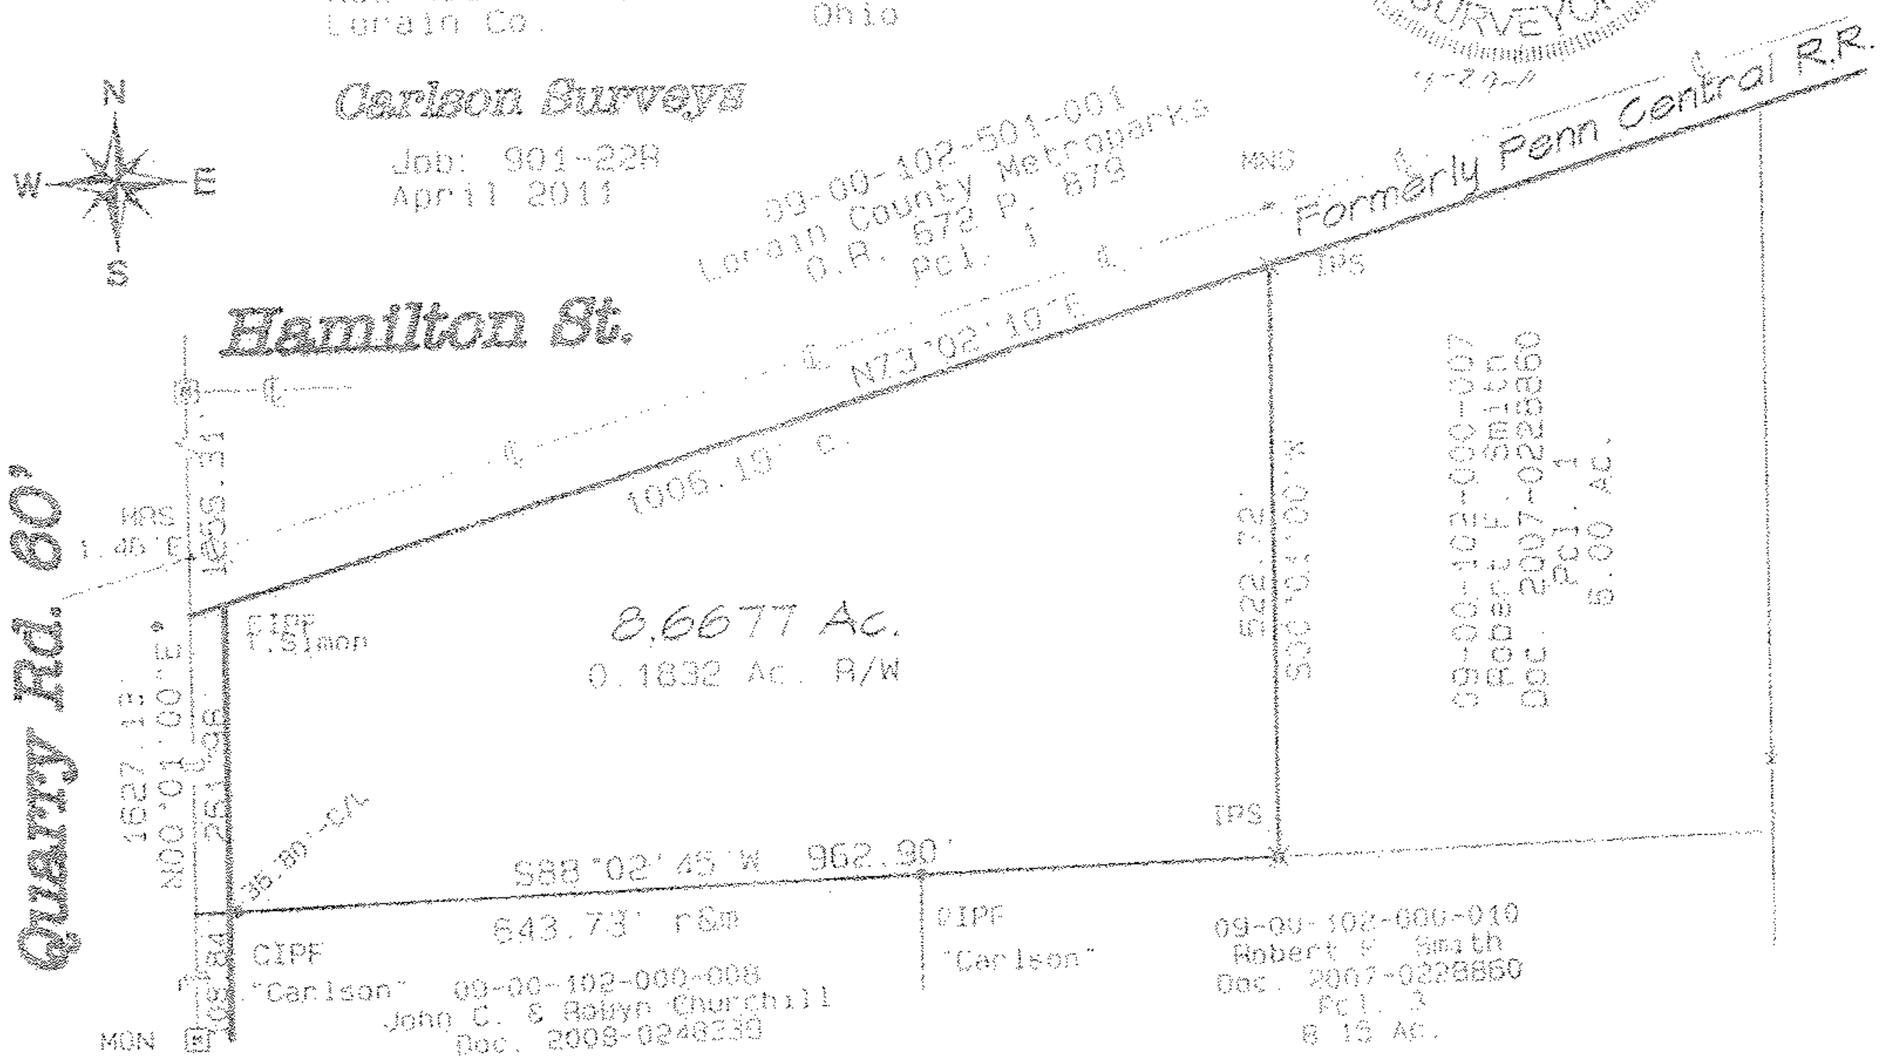

MNS=Mag Nail Set
CIPF=Capped Iron Pin Found as noted
IPS=Iron Pin Set 5/8" rebar with cap stamped Carlson
RRS=Railroad Spike Fd.
MON=Monument Box

GRAPHIC SCALE 1"=200'

0 200 400 600