18-00-020-000-073
18-00-020-C
Scan # 47318

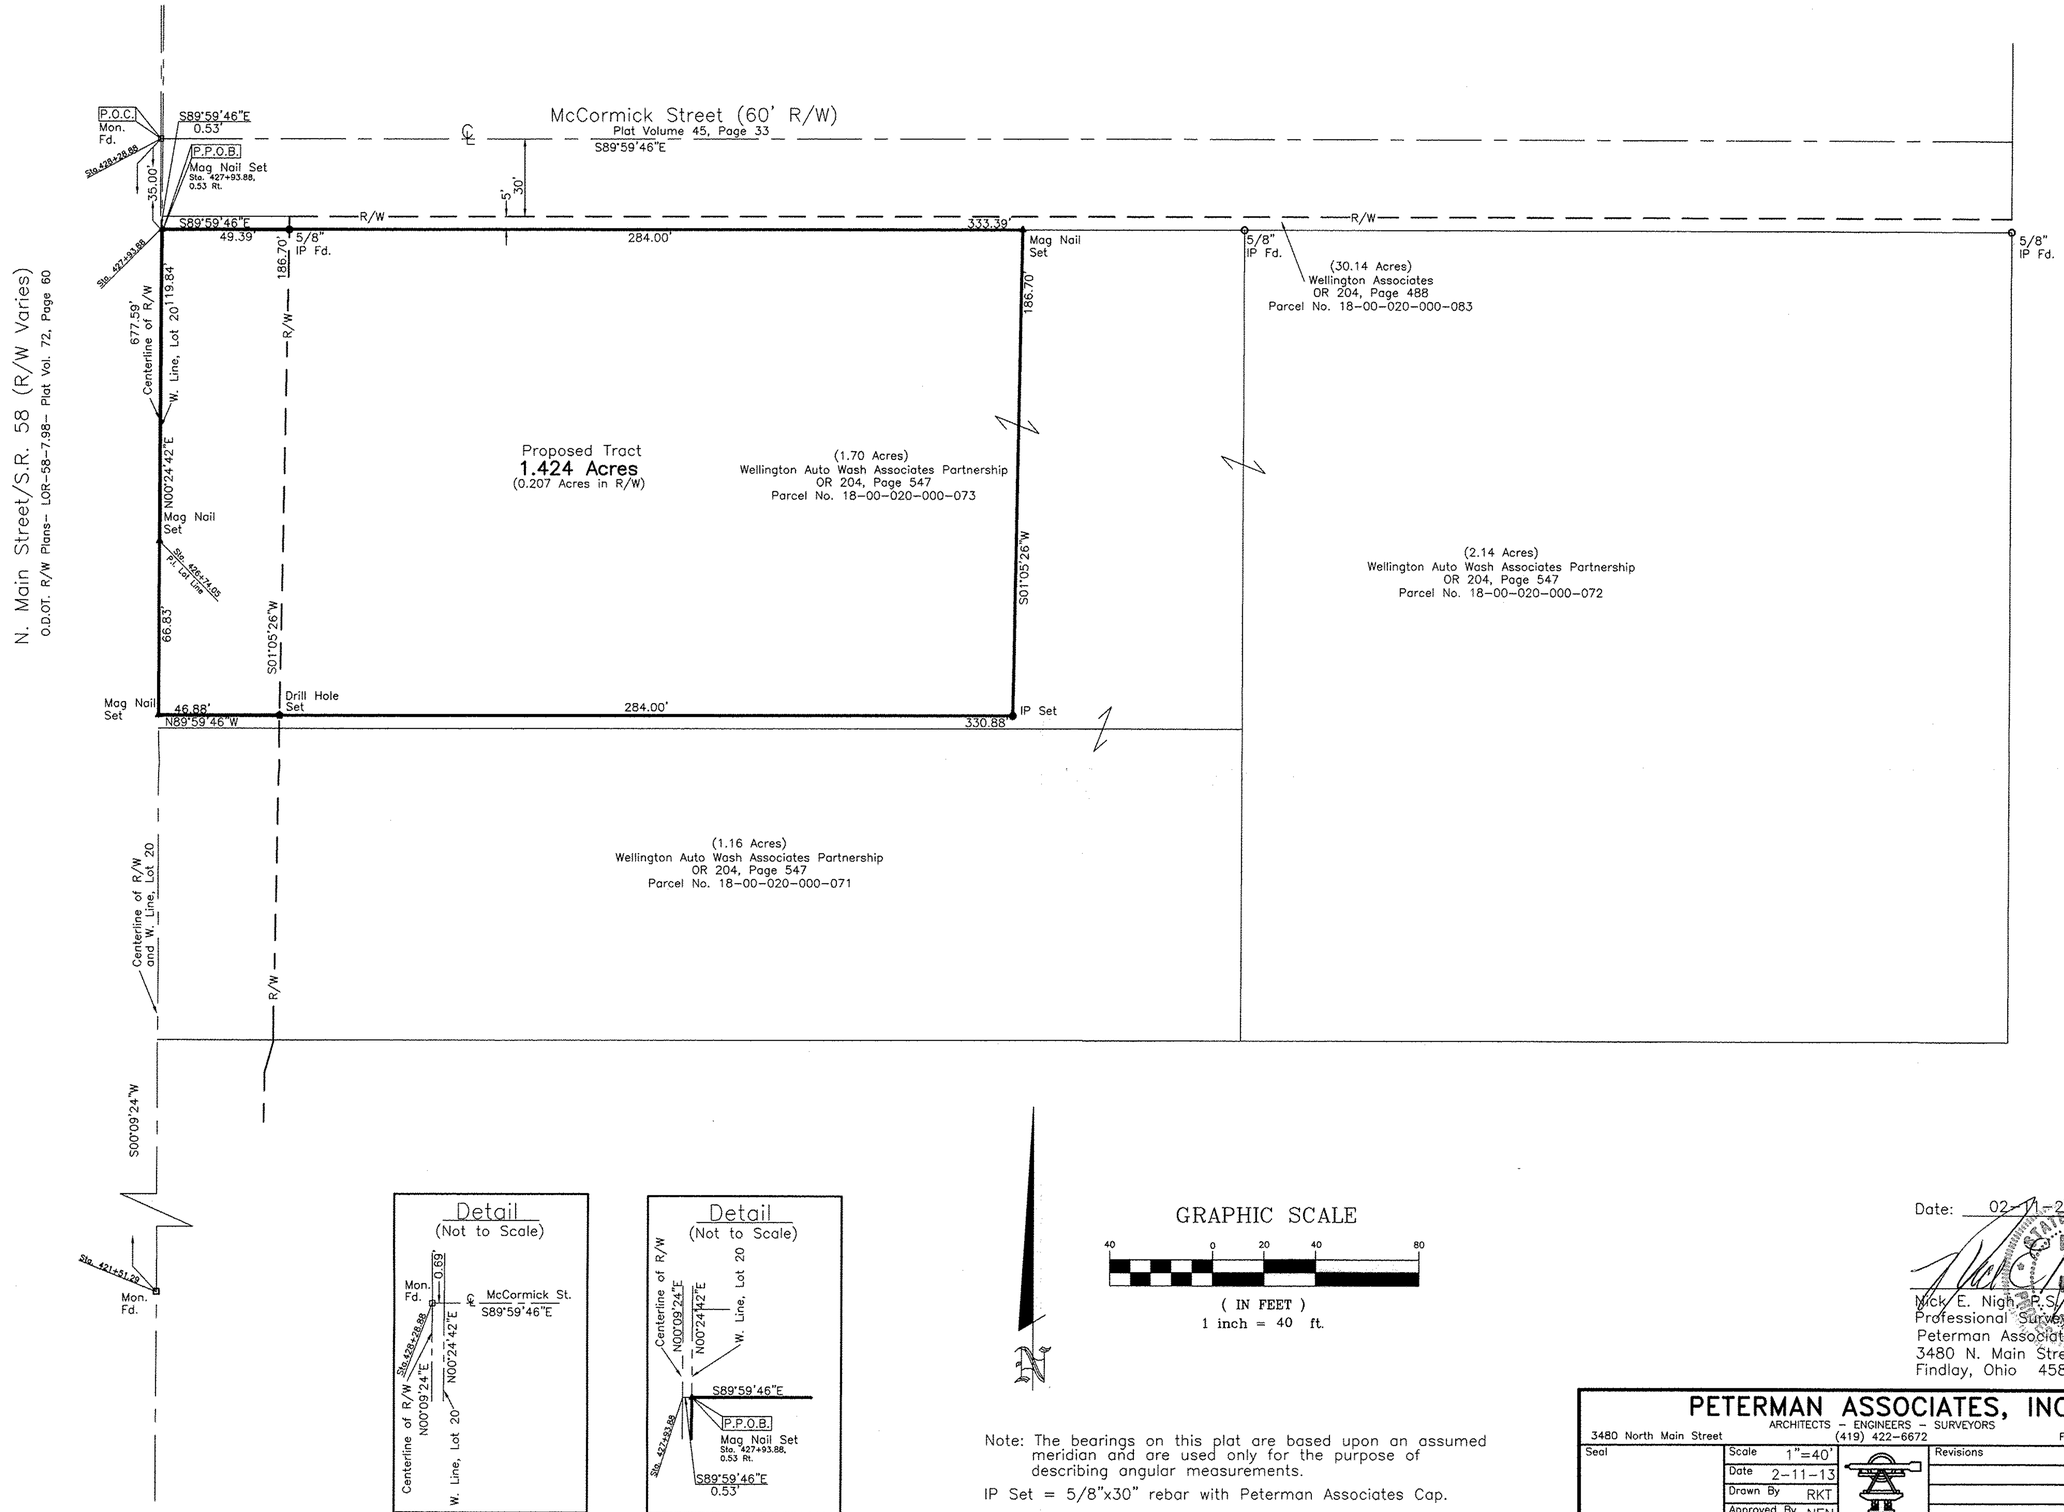

Note: The bearings on this plat are based upon an assumed meridian and are used only for the purpose of describing angular measurements.

IP Set = 5/8"x30" rebar with Peterman Associates Cap.

This survey plat represents an actual field survey performed under my supervision during the month of January, 2013

Date: 02-11-2013

Nick E. Nigh, P.S. #7384
Professional Surveyor #7384
Peterman Associates, Inc.
3480 N. Main Street
Findlay, Ohio 45840

PETERMAN ASSOCIATES, INC.
ARCHITECTS – ENGINEERS – SURVEYORS
3480 North Main Street (419) 422-6672 Findlay, Ohio 45840

Seal	Scale 1"=40'	Revisions	By	Date
	Date 2-11-13			
	Drawn By RKT			
	Approved By NEN			

SURVEY

The Hutton Company

Being part of Original Wellington Township Lot No. 20, Village of Wellington, County of Lorain, Ohio

Job No. 12-0041 12-0042