04-00-027-103-013
04-00-027-E
scan # 47331

MAP OF SURVEY

FOR

CLEVELAND HOME TITLE AGENCY, LTD.

SITUATED IN THE CITY OF AVON, COUNTY OF LORAIN, AND STATE OF OHIO
AND KNOWN AS BEING PART OF ORIGINAL AVON TOWNSHIP SECTION NO. 27

MACKAY
Engineering & Surveying Company
7017 Pearl Road, Cleveland, Ohio 44130
(440) 886-4500 (440) 886-4590 Fax

JANUARY 31, 2013

0 30 60 90
SCALE: 1"=30'

North

SURVEYOR'S CERTIFICATION

THIS MAP AND THE SURVEY ON WHICH IT IS BASED ARE MADE IN ACCORDANCE WITH THE MINIMUM STANDARDS FOR BOUNDARY SURVEYS IN THE STATE OF OHIO AS SET FORTH IN CHAPTER 4733-37 OF THE OHIO ADMINISTRATIVE CODE.

DIMENSIONS SHOWN HEREON ARE EXPRESSED IN FEET AND DECIMAL PARTS THEREOF, BEARINGS SHOWN HEREON ARE TO AN ASSUMED MERIDIAN AND ARE TO INDICATE ANGLES ONLY.

IP SET INDICATES 5/8" IRON PIN SET WITH CAP NO. 7344.

ALL OF WHICH I CERTIFY TO BE CORRECT.

STATE OF OHIO
MICHAEL MACKAY
7344
REGISTERED
PROFESSIONAL SURVEYOR

Michael Mackay 1/31/13
MICHAEL MACKAY, P.S. #7344 DATE

LEGEND

- ● IRON PIN SET
- ○ IRON PIN FOUND
- R/W = RIGHT-OF-WAY
- ℄ = CENTERLINE
- FND = FOUND
- ℙ = PROPERTY LINE
- D = DEED
- U = USED
- R = RECORDED
- C = CALCULATED
- L.C.M.R. = LORAIN COUNTY MAP RECORDS
- L.C.D.R. = LORAIN COUNTY DEED RECORDS
- AOL = APPROXIMATELY ON LINE

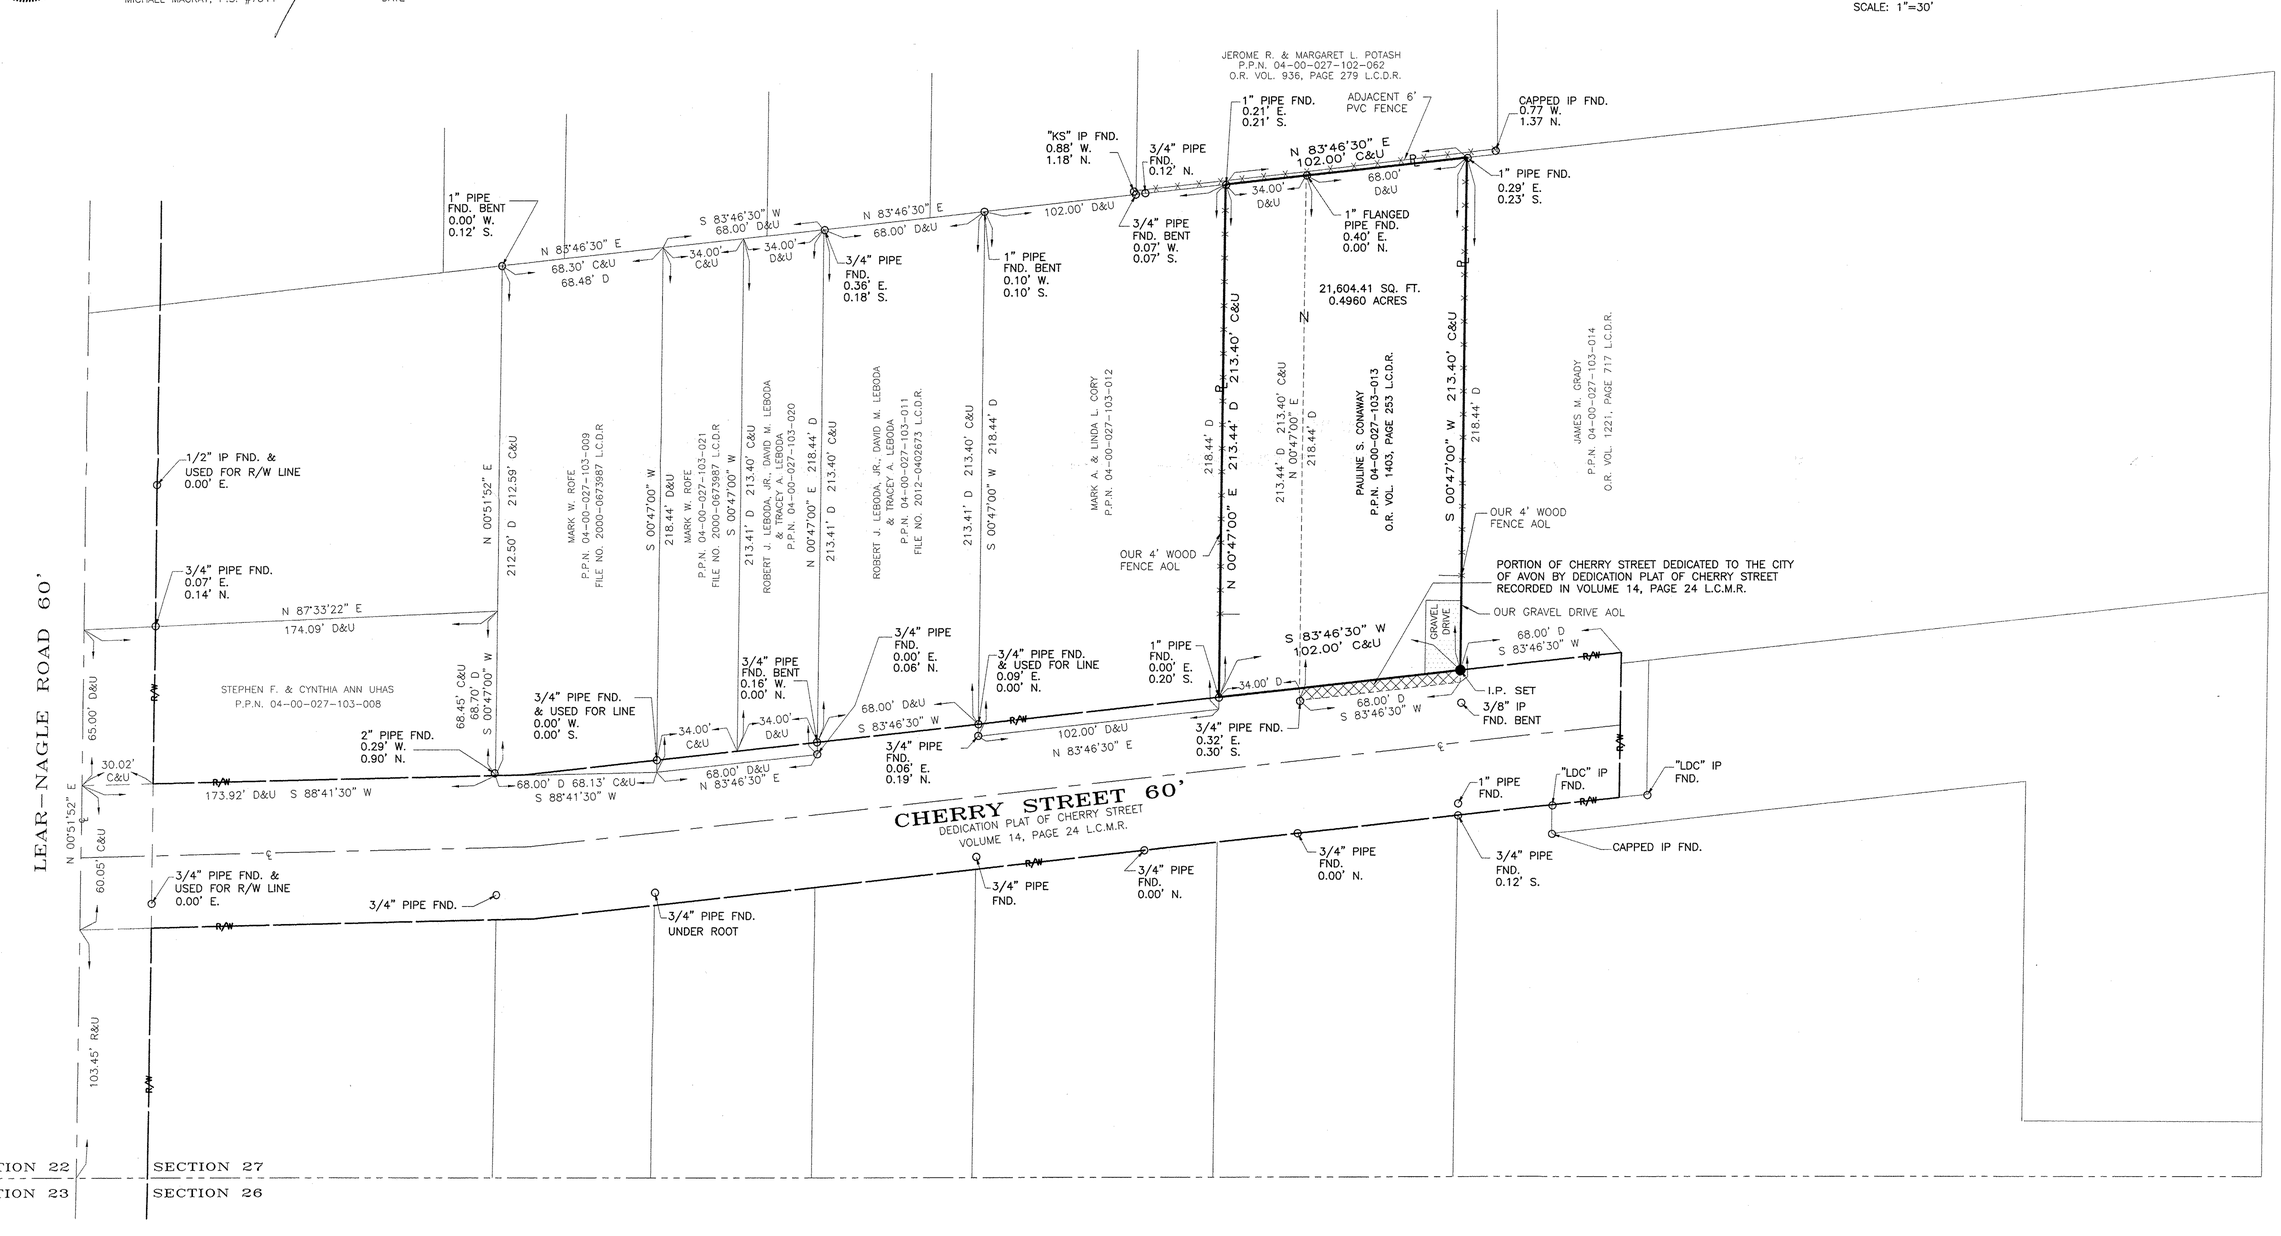

JOB NO. 5400
SHEET 1 OF 1