

PJD NO. 83456

R/N DESIGNER MSN
R/N REVIEWER R/SSR

RIGHT OF WAY TOPO SHEET
STA. 1166+00 TO STA. 1170+00

LOR-301-21.50
(ABBE RD.)

21 / 26



ms consultants, inc.

scan# 47334

APPROVED
LORRY CO.
MPT
D: 2.6.13
PN: 300-001-A
BY: R. BALDES
*13.00349


03-00-001-000-188
-189

STRUCTURE KEY

- RESIDENTIAL
- COMMERCIAL

MSN	2-9-12	(SAVE) MCDONALD'S SIGN
MSN	4-12-12	TAKE BURGER KING SIGN

REV. BY	DATE	DESCRIPTION

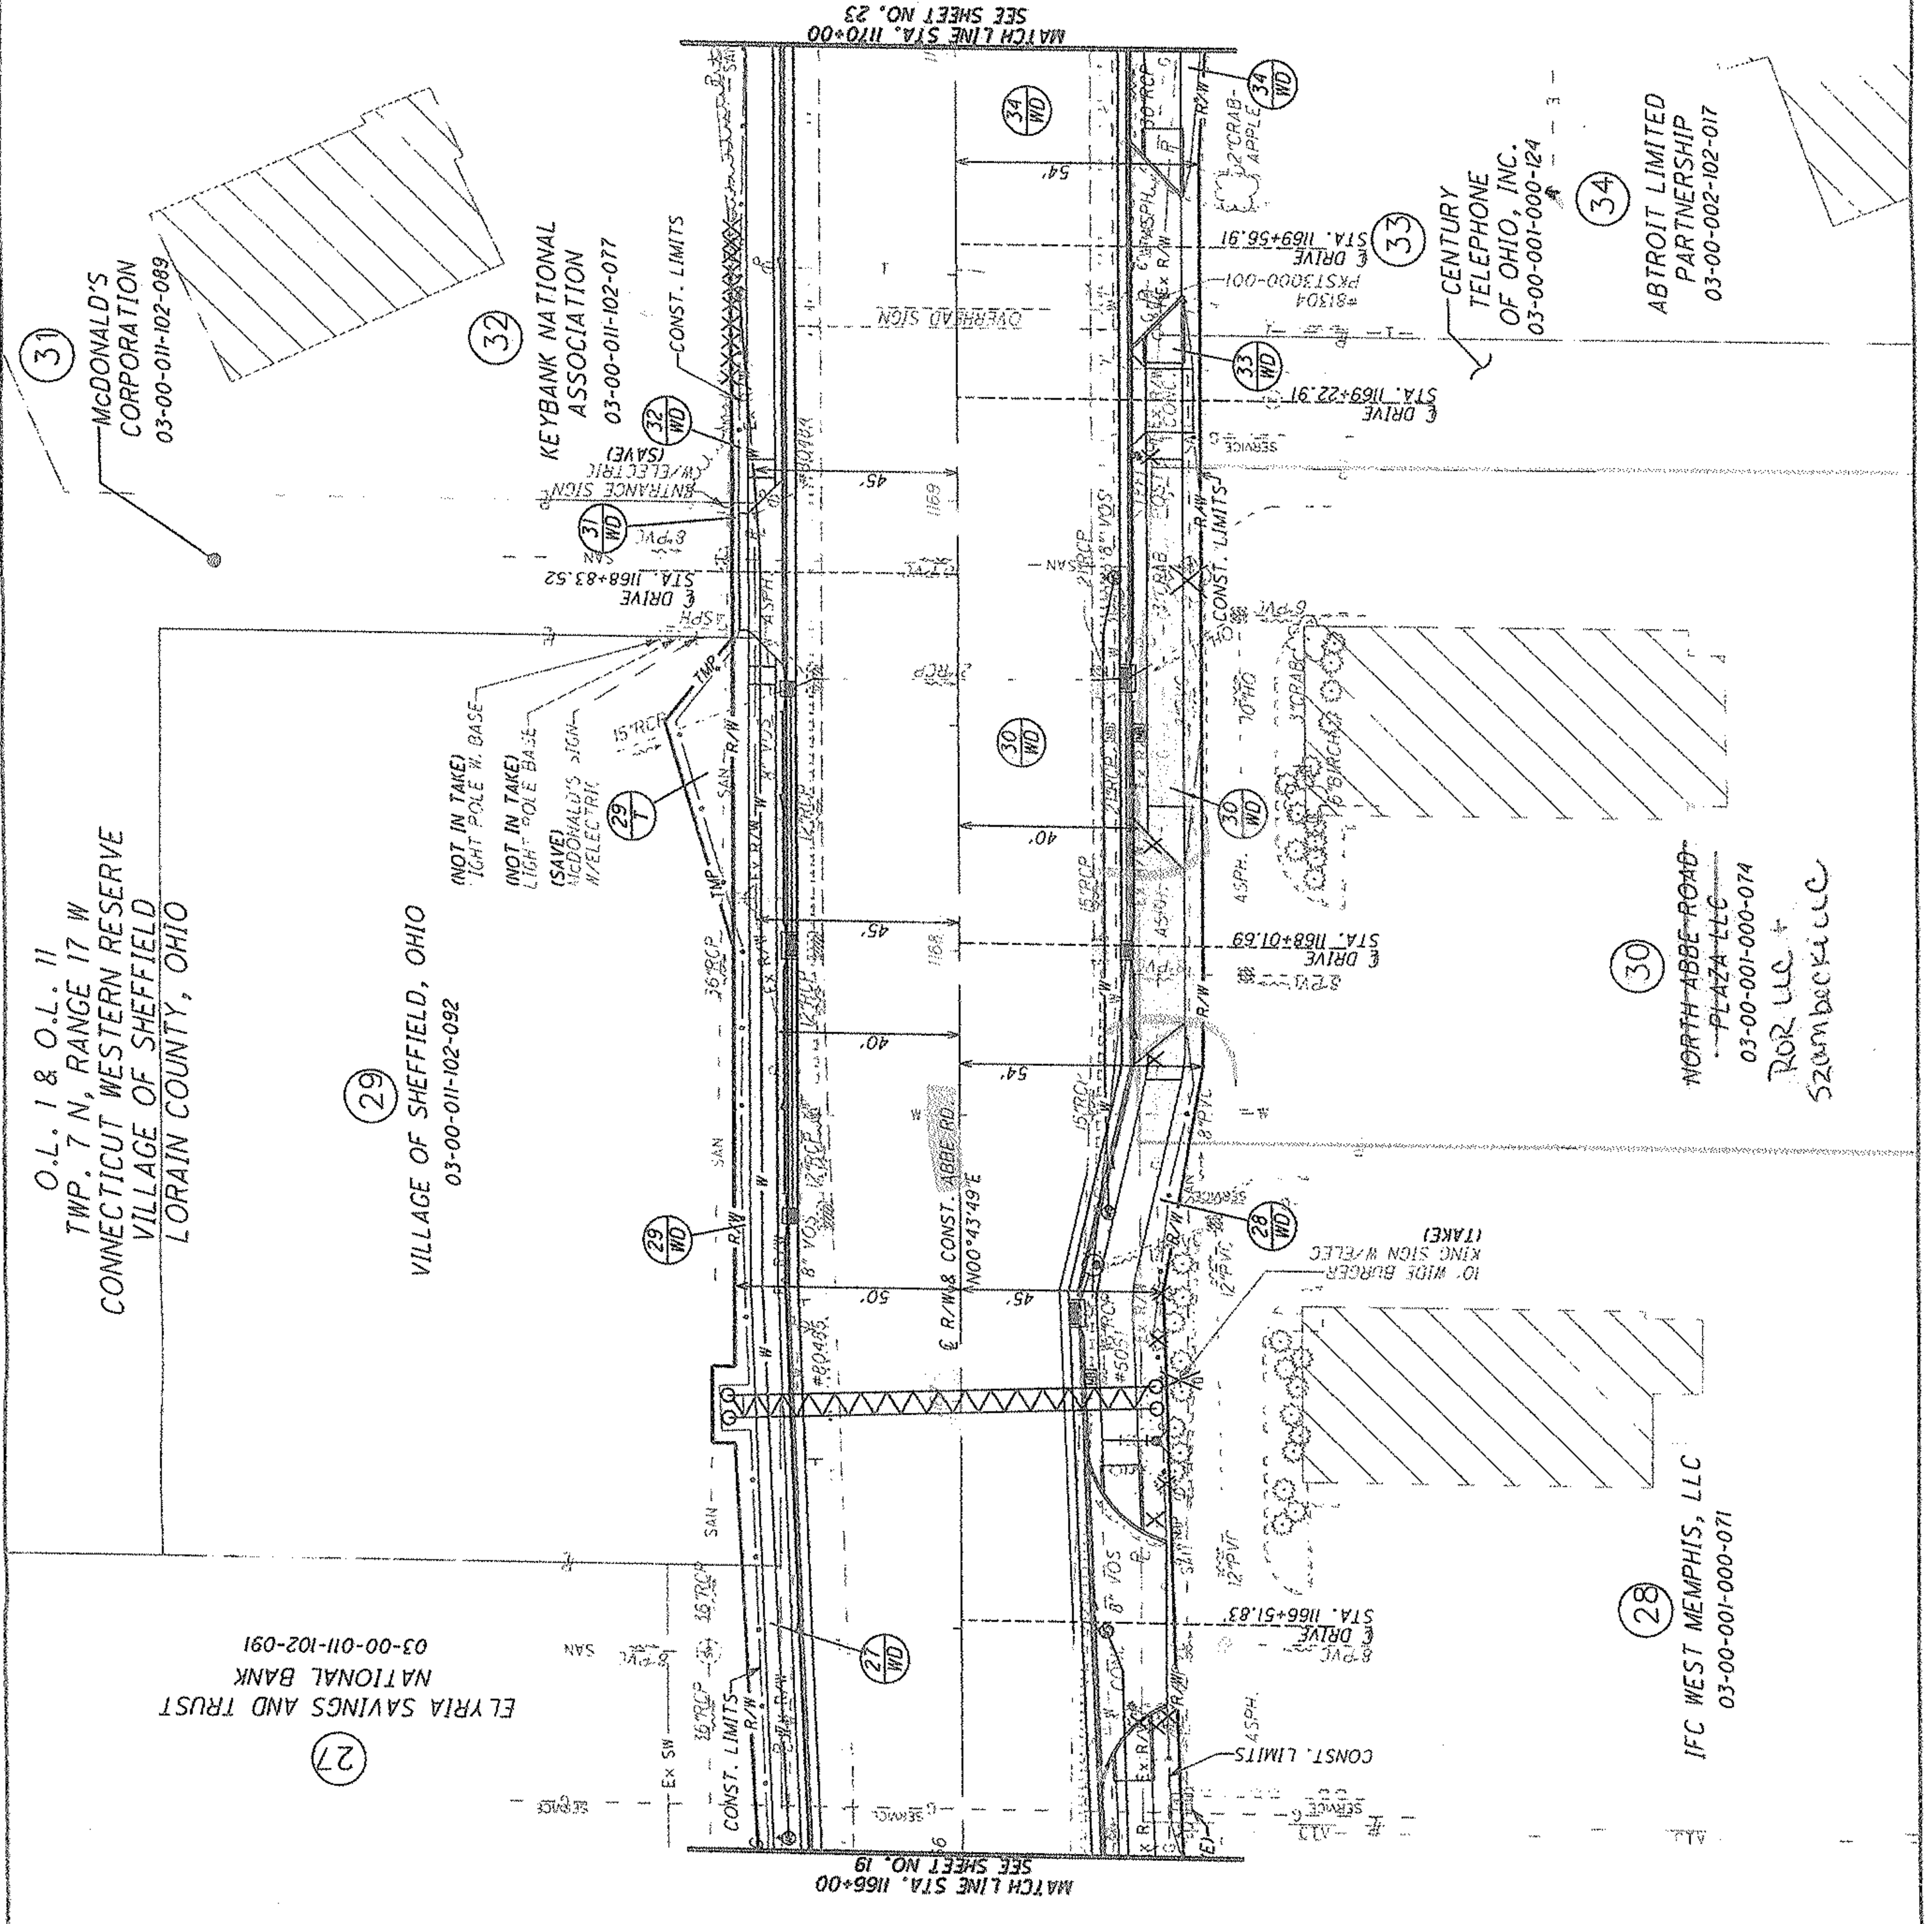

MATCH LINE STA. 1166+00
SEE SHEET NO. 19

MATCH LINE STA. 1170+00
SEE SHEET NO. 23