
BOUNDARY SURVEY

FJD PROPERTIES LLC


SITUATED IN THE CITY OF NORTH RIDGEVILLE, COUNTY OF LORAIN, STATE OF OHIO AND KNOWN AS BEING PART OF ORIGINAL RIDGEVILLE TOWNSHIP LOT NUMBER 39.

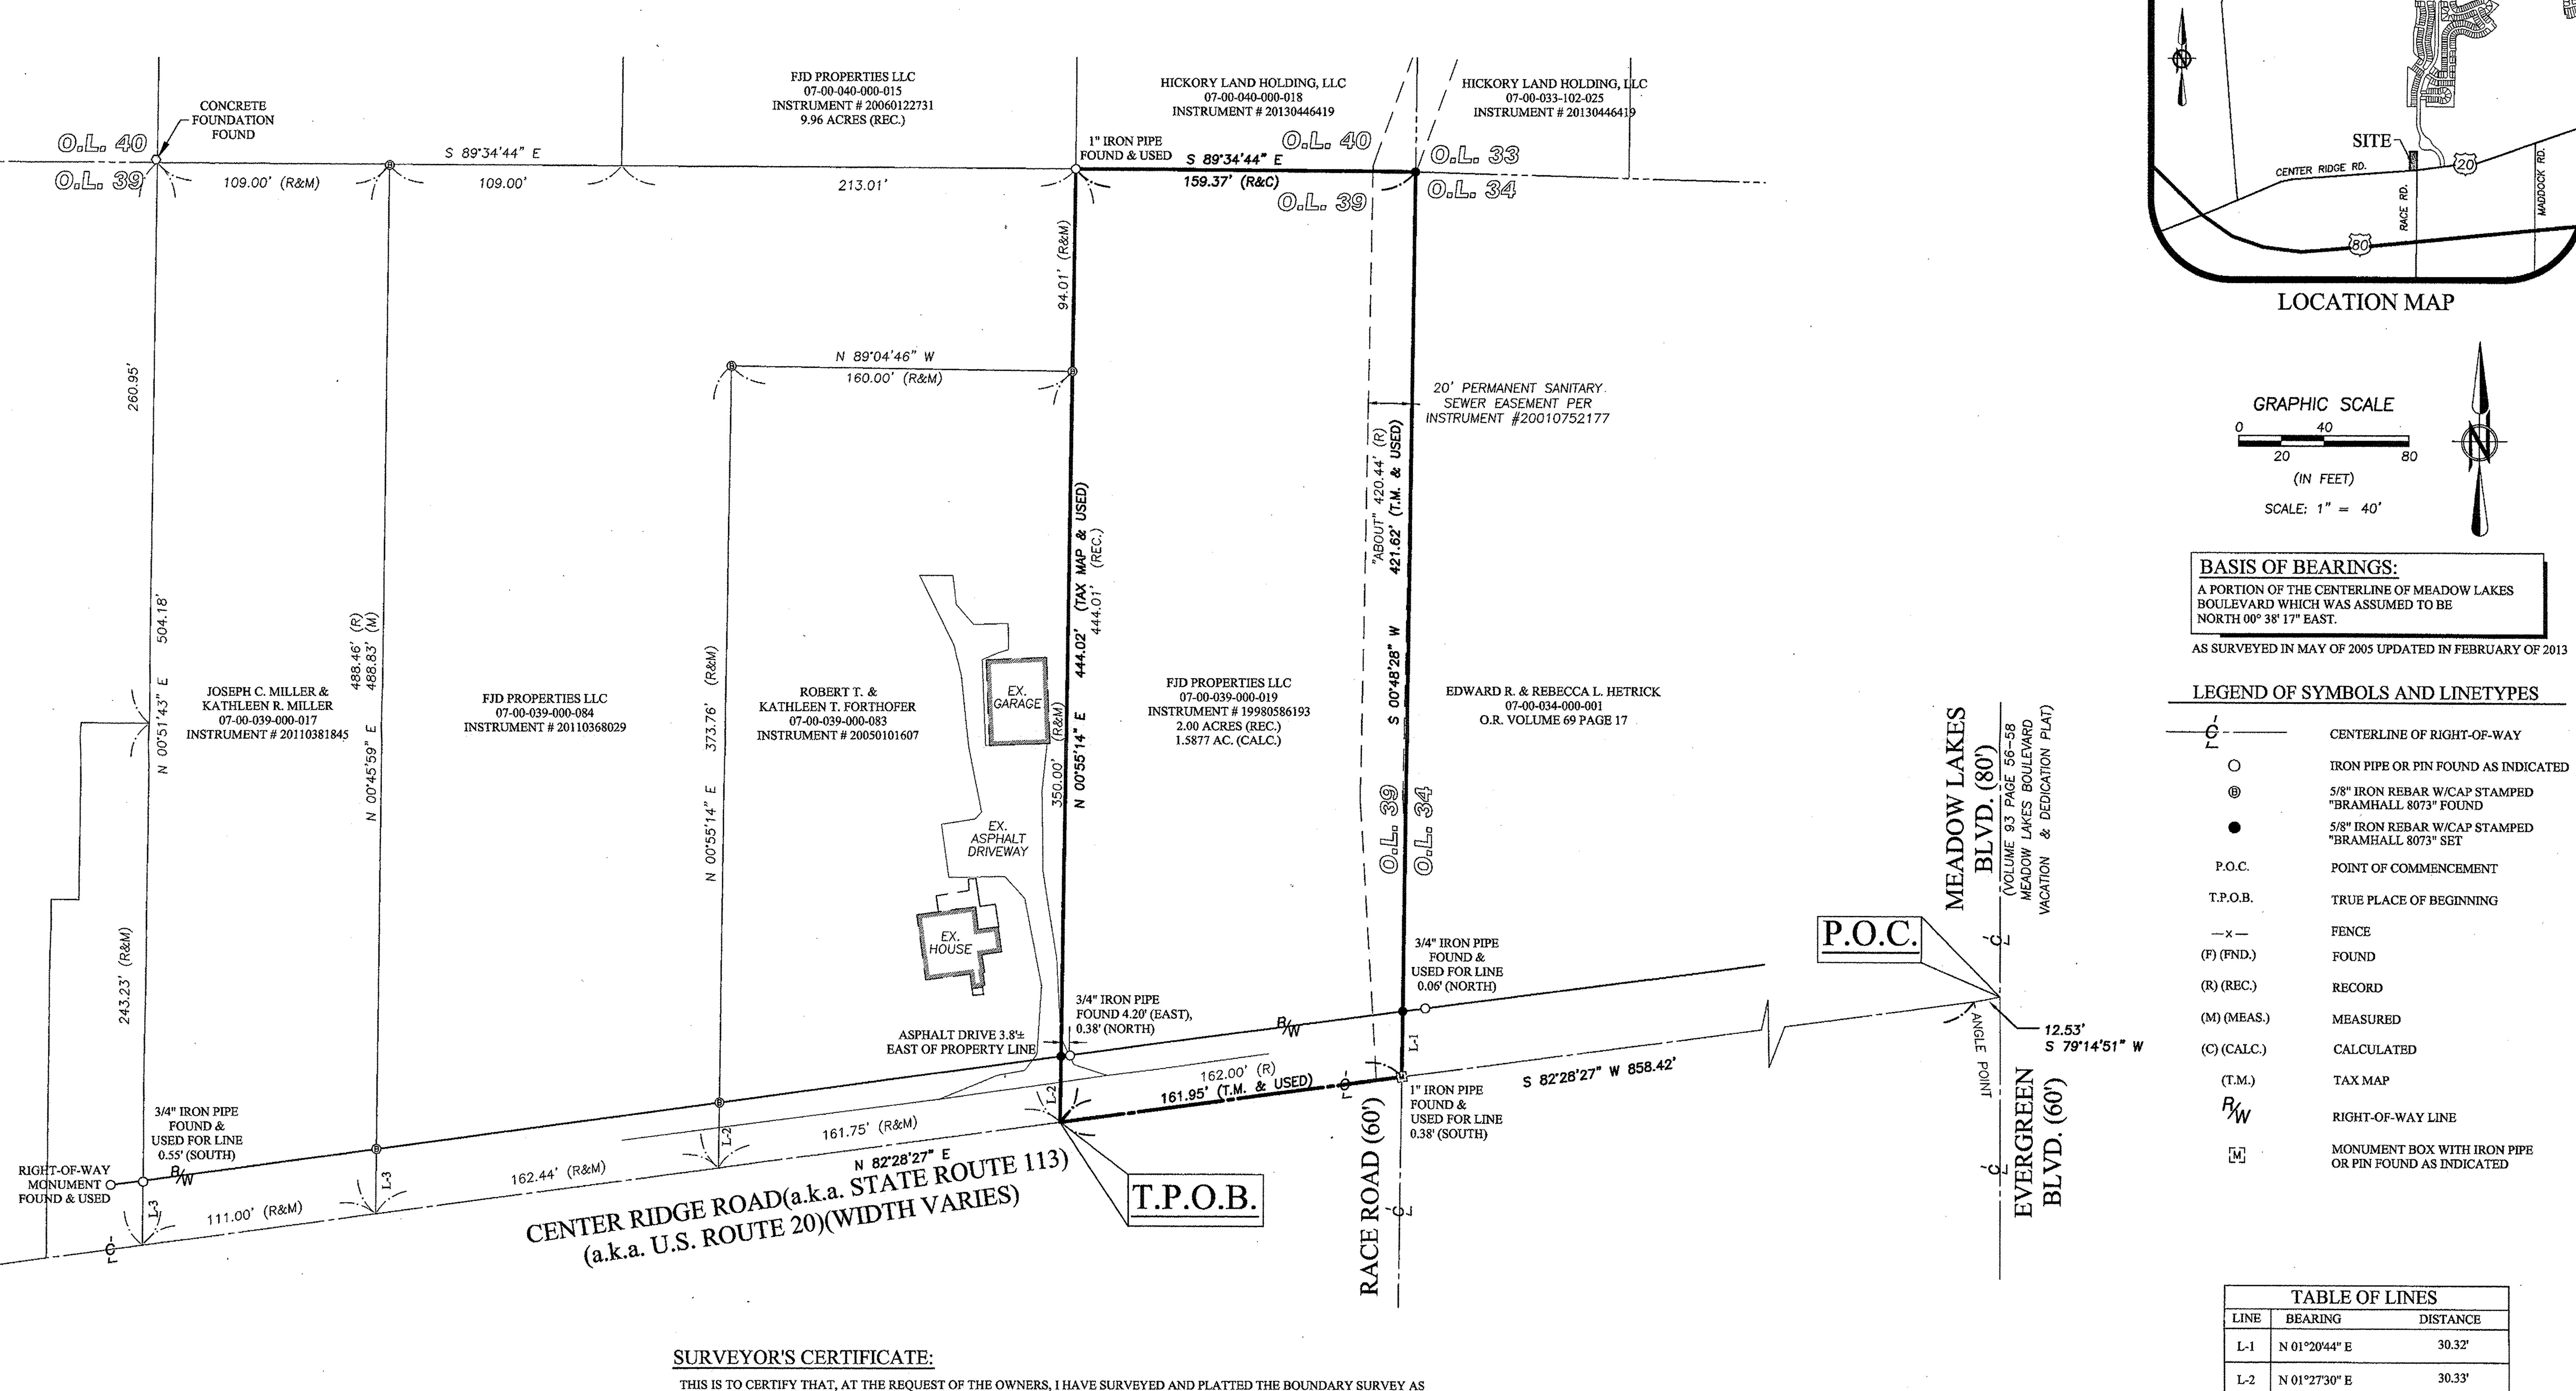


SHOWN HEREON, SITUATED IN THE CITY OF NORTH RIDGEVILLE, COUNTY OF LORAIN, STATE OF OHIO AND KNOWN AS BEING / LORAIN COUNTY DEED RECORDS, CONTAINING 1.5877 ACRES OF LAND IN ORIGINAL RIDGEVILLE TOWNSHIP LOT NUMBER 39, BE THE SAME MORE OR LESS, BUT SUBJECT TO ALL LEGAL HIGHWAYS AND EASEMENTS OF RECORD. AT ALL POINTS THUSLY INDICATED O IRON PIN MONUMENTS WERE FOUND AND AT ALL POINTS THUSLY INDICATED • IRON PIN MONUMENTS WERE SET. DISTANCES ARE SHOWN IN FEET AND DECIMAL PARTS THEREOF. BEARINGS SHOWN ARE USED TO DESCRIBE ANGLES BLOCK COMPUTED FROM FIELD MEASUREMENTS OF GROUND CLOSED WITHIN A LIMIT OF ERROR OF ONE (1) FOOT TO TEN STANDARDS FOR LAND SURVEYS, IN SECTION 4733-37 OF THE OHIO ADMINISTRATIVE CODE AND ADJACENT PROPERTY DESCRIPTIONS HAVE BEEN CONSIDERED IN PERFORMING THIS SURVEY. ALL OF WILCH! CERTIFY TO BE CORRECT.

3 1	DATE:	DX:	DESCRIPTION:	
Š	02/05/2013	BDA	ISSUE TO CLIENT	
SION				
REV				
2				
			<u>~</u>	······································
				<u> </u>

DATE 2-5-13

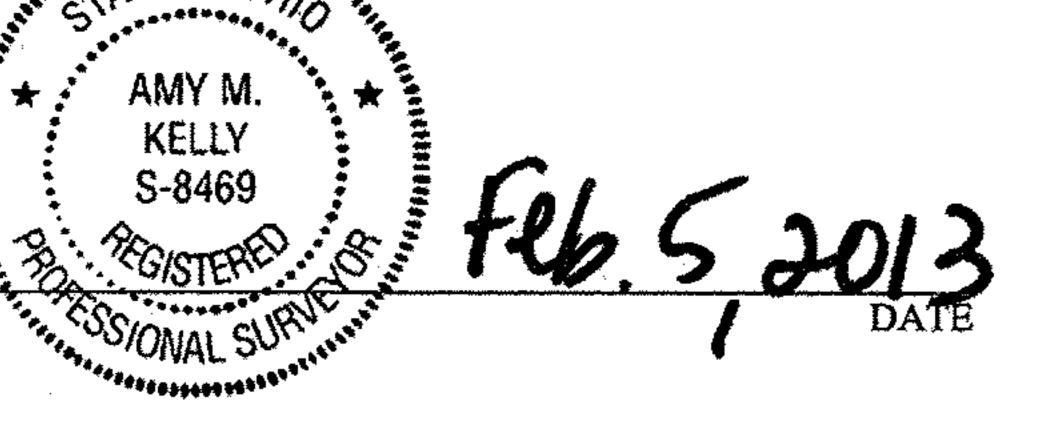

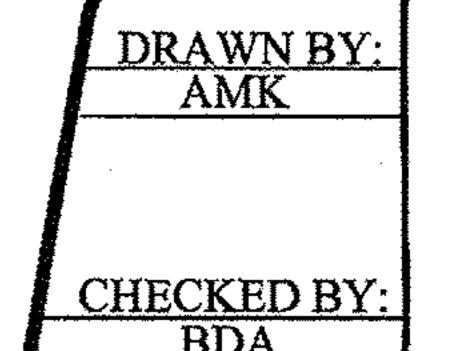



L-3 N01°18'15" E

SHEET

DISTANCE

06-2430-017